
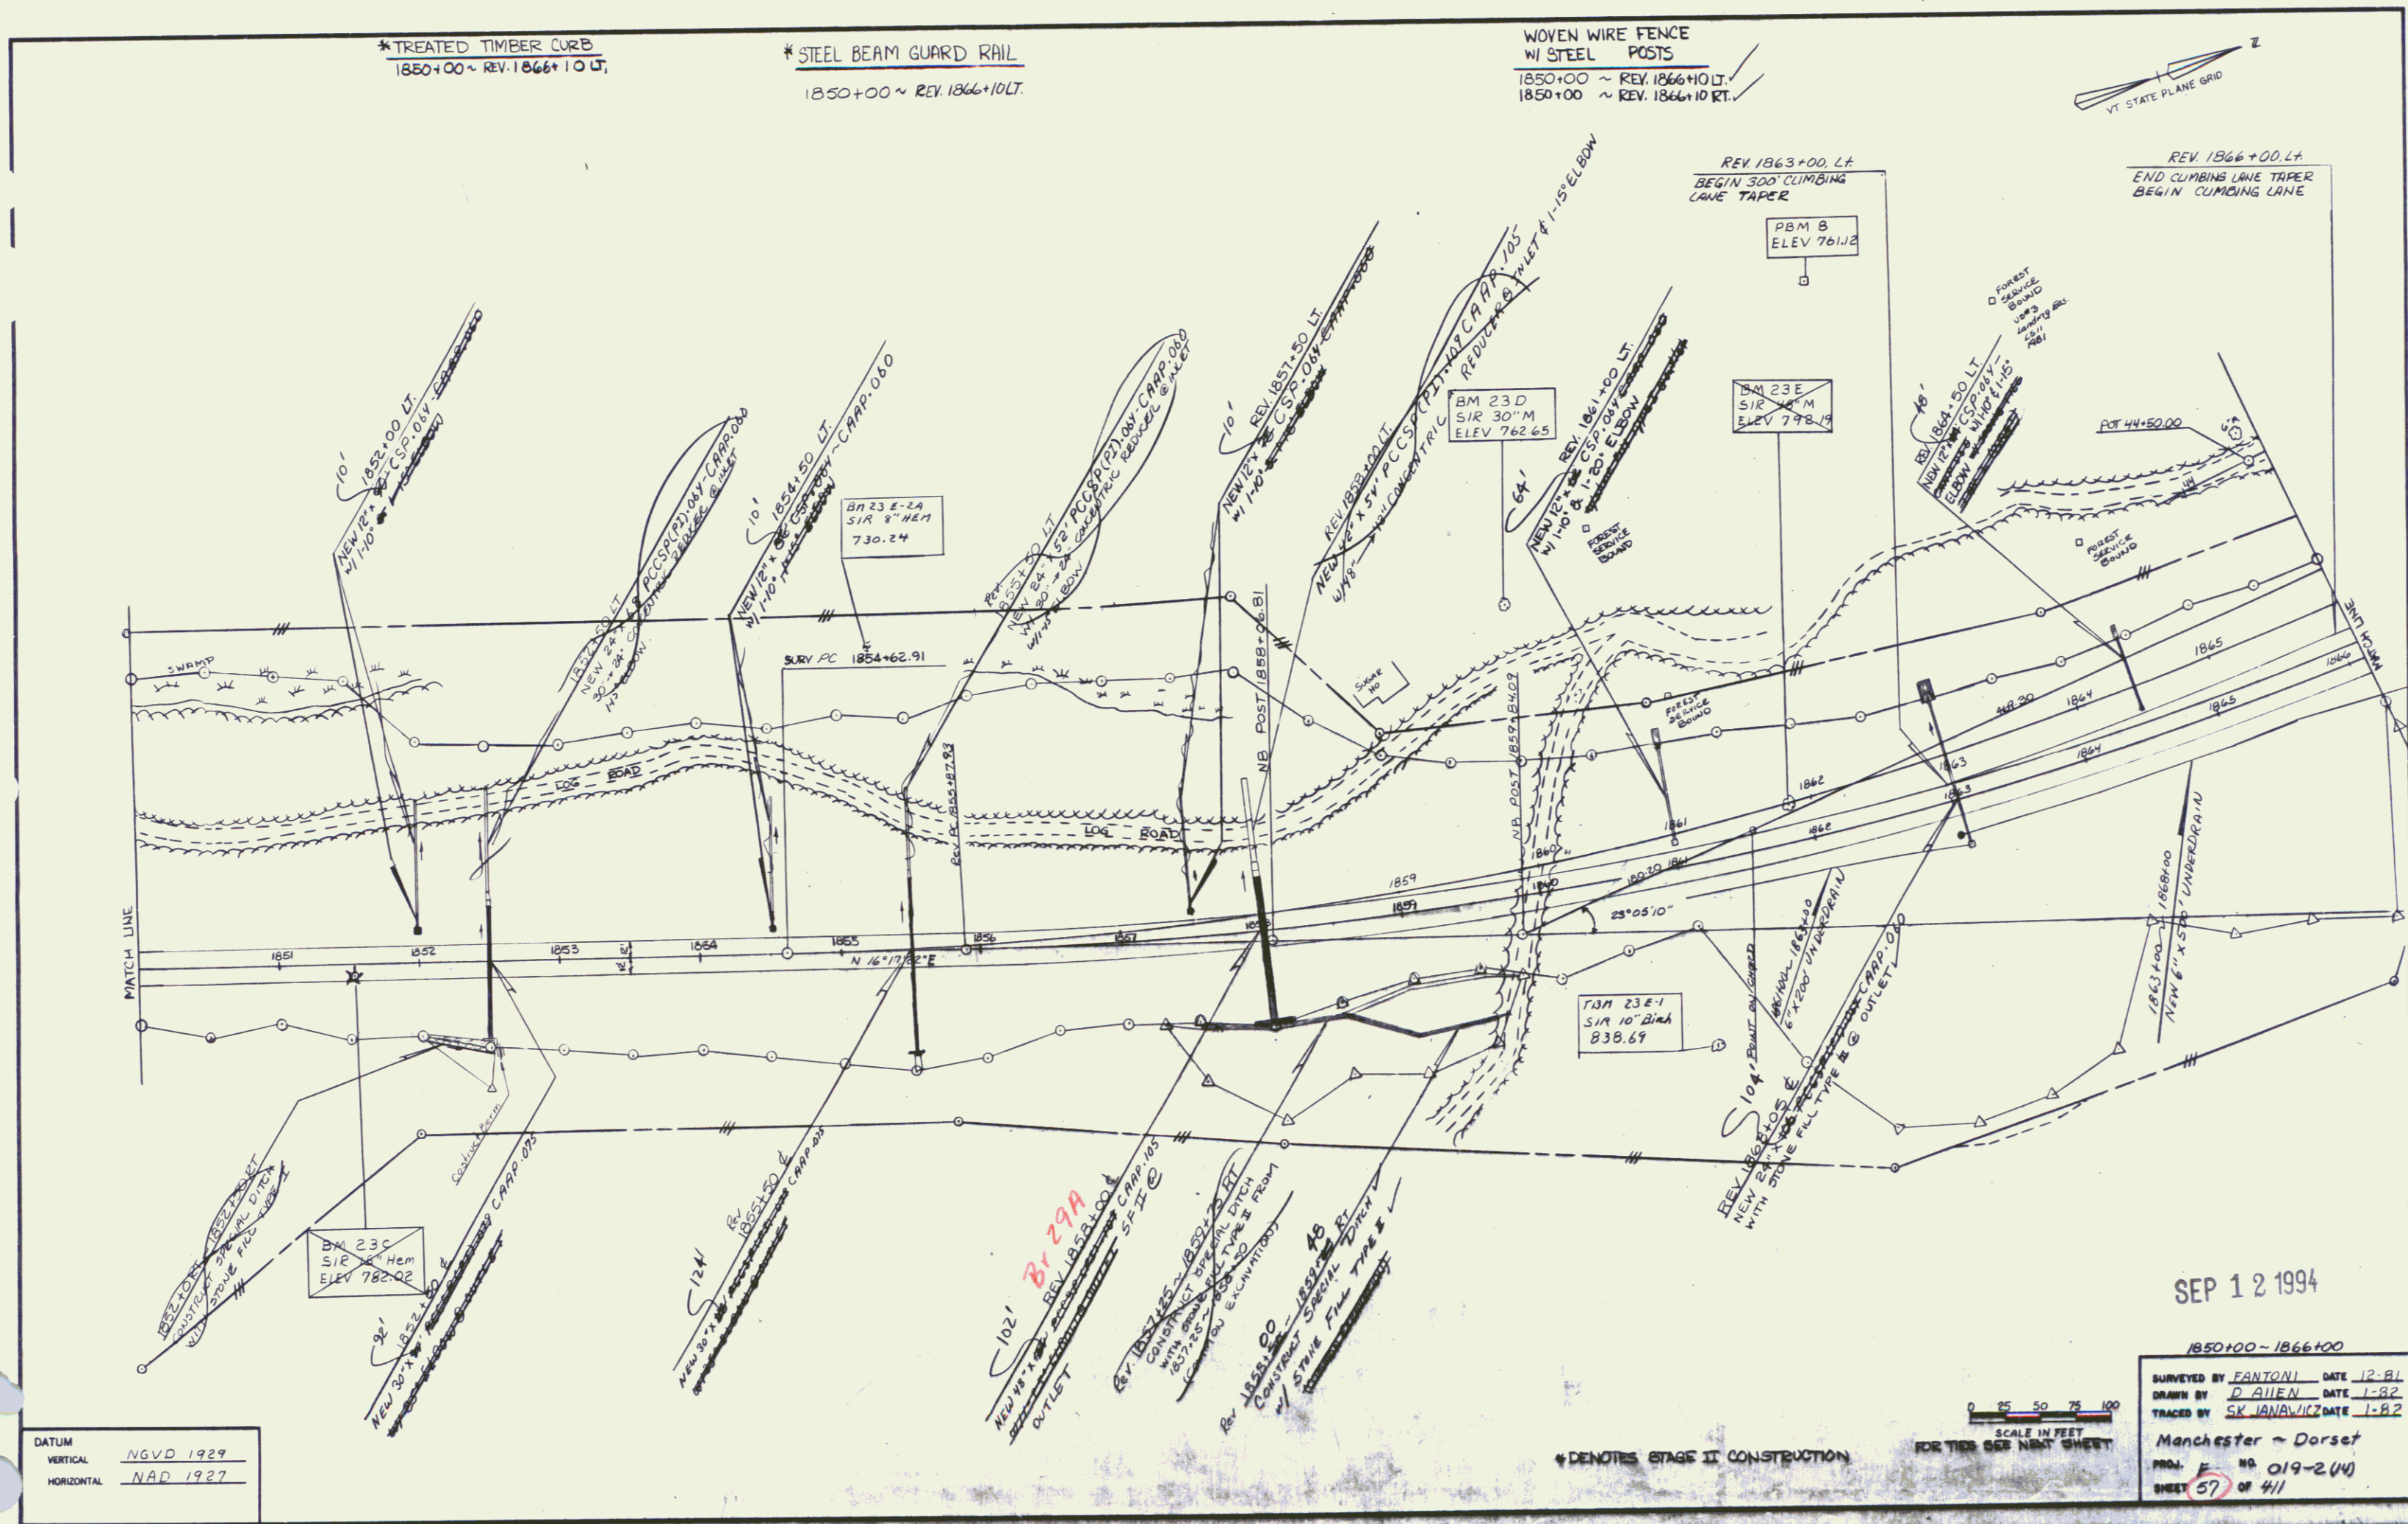


*TREATED TIMBER CURB
1850+00 ~ REV. 1866+10 LT.

*STEEL BEAM GUARD RAIL
1850+00 ~ REV. 1866+10 LT.

WOVEN WIRE FENCE
W/ STEEL POSTS
1850+00 ~ REV. 1866+10 LT.
1850+00 ~ REV. 1866+10 RT.

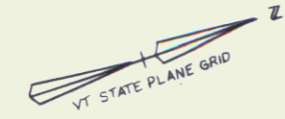

DATUM
VERTICAL NGVD 1929
HORIZONTAL NAD 1927

1021
NEW 10' x 10' P.C.S. OUTLET
REV. 1851+50 LT.
CONSTRUCT SPECIAL POINT
W/ STEEL BEAM GUARD RAIL

* DENOTES STAGE II CONSTRUCTION

SCALE IN FEET
0 25 50 75 100

SEP 12 1994

1850+00 ~ 1866+100
SURVEYED BY FANTONI DATE 12-81
DRAWN BY D ALLEN DATE 1-82
TRACED BY SK JANAWICZ DATE 1-82
Manchester ~ Dorset
PROJ. # 019-2(4)
SHEET 57 OF 41