



\* GUARD RAIL APPROACH  
SECTION TYPE I  
REV 1887+29 LT. ~ REV 1887+77 LT.  
REV 1887+41 RT. ~ REV 1887+41 RT.  
REV 1888+65 LT. ~ REV 1889+115 LT.  
REV 1889+91 RT. ~ REV 1889+41 RT.  
REV 1892+45 LT. ~ REV 1892+95 LT.  
REV 1893+20 RT. ~ REV 1893+70 RT.  
REV 1894+28 LT. ~ REV 1894+78 LT.  
REV 1894+07 RT. ~ REV 1894+57 RT.

\* STEEL BEAM GUARD RAIL  
REV 1886+41 RT. ~ REV 1887+41 RT.  
REV 1886+52 LT. ~ REV 1887+27 LT.  
REV 1889+15 LT. ~ REV 1892+45 LT.  
REV 1894+41 RT. ~ REV 1893+20 RT.  
REV 1893+78 LT. ~ REV 1894+40.5 LT.  
REV 1894+57 RT. ~ REV 1895+42.5 RT.

WOVEN WIRE FENCE  
1/4" STEEL POST  
REV 1881+50 ~ REV 1882+25 LT.  
REV 1884+20 ~ REV 1885+25 LT.  
1887+71  
1893+27  
1888+90  
1894+30 RT. ~ REV 1894+10 RT.

6' CHAIN LINK FENCE  
REV 1882+25 ~ REV 1884+20 LT.

BRIDGE RAILING - GALVANIZED BOX BEAM  
REV 1887+77 LT. ~ REV 1888+65 LT.  
REV 1887+91 RT. ~ REV 1889+91 RT.  
REV 1892+95 LT. ~ REV 1893+28 LT.  
REV 1893+70 RT. ~ REV 1894+07 RT.

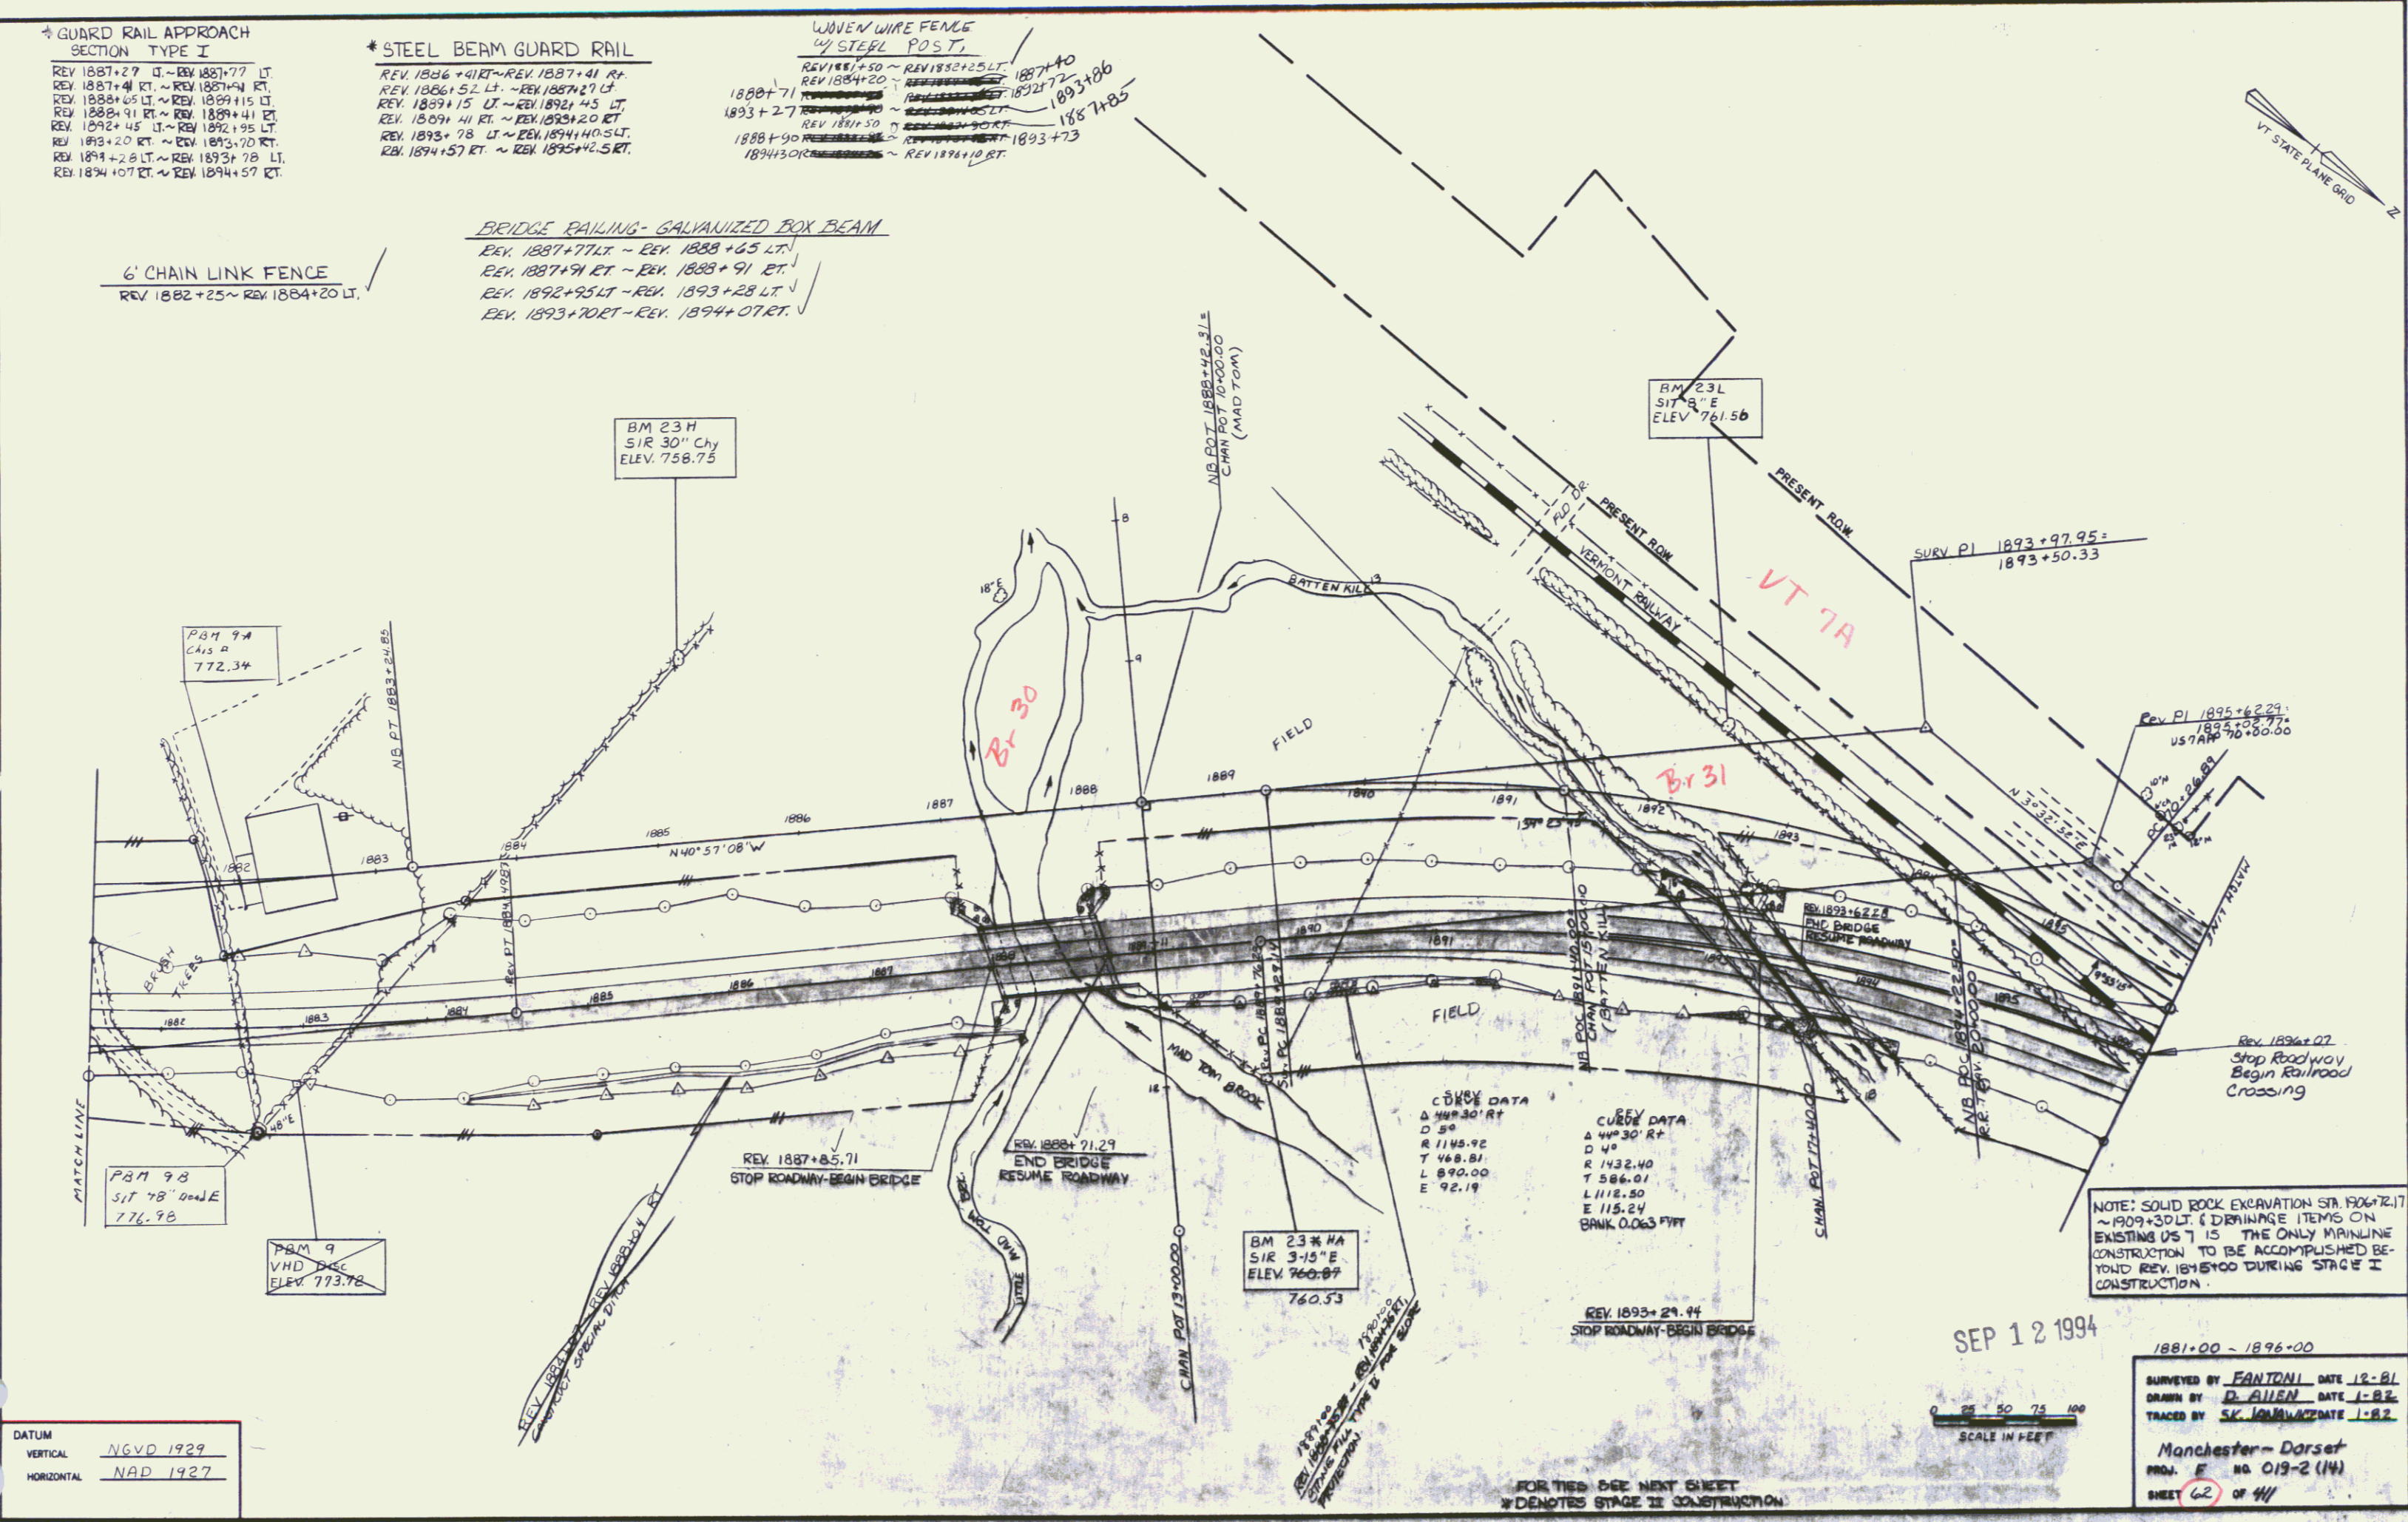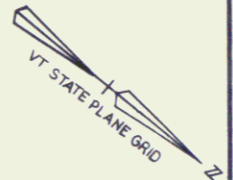

CURVE DATA  
Δ 44°30' RT  
D 50  
R 1145.92  
T 148.81  
L 890.00  
E 92.19

CURVE DATA  
Δ 44°30' RT  
D 40  
R 1432.40  
T 586.01  
L 1112.50  
E 115.24  
BANK 0.063 PVT

SEP 12 1994

1881-00 ~ 1896-00  
SURVEYED BY FANTONI DATE 12-81  
DRAWN BY D. ALLEN DATE 1-82  
TRACED BY SK. IANNUCCI DATE 1-82  
Manchester - Dorset  
PROJ. E NO 019-2 (14)  
SHEET 62 OF 44

DATUM  
VERTICAL NGVD 1929  
HORIZONTAL NAD 1927

FOR THE SEE NEXT SHEET  
DENOTES STAGE II CONSTRUCTION