


POOR ORIGINAL COPY

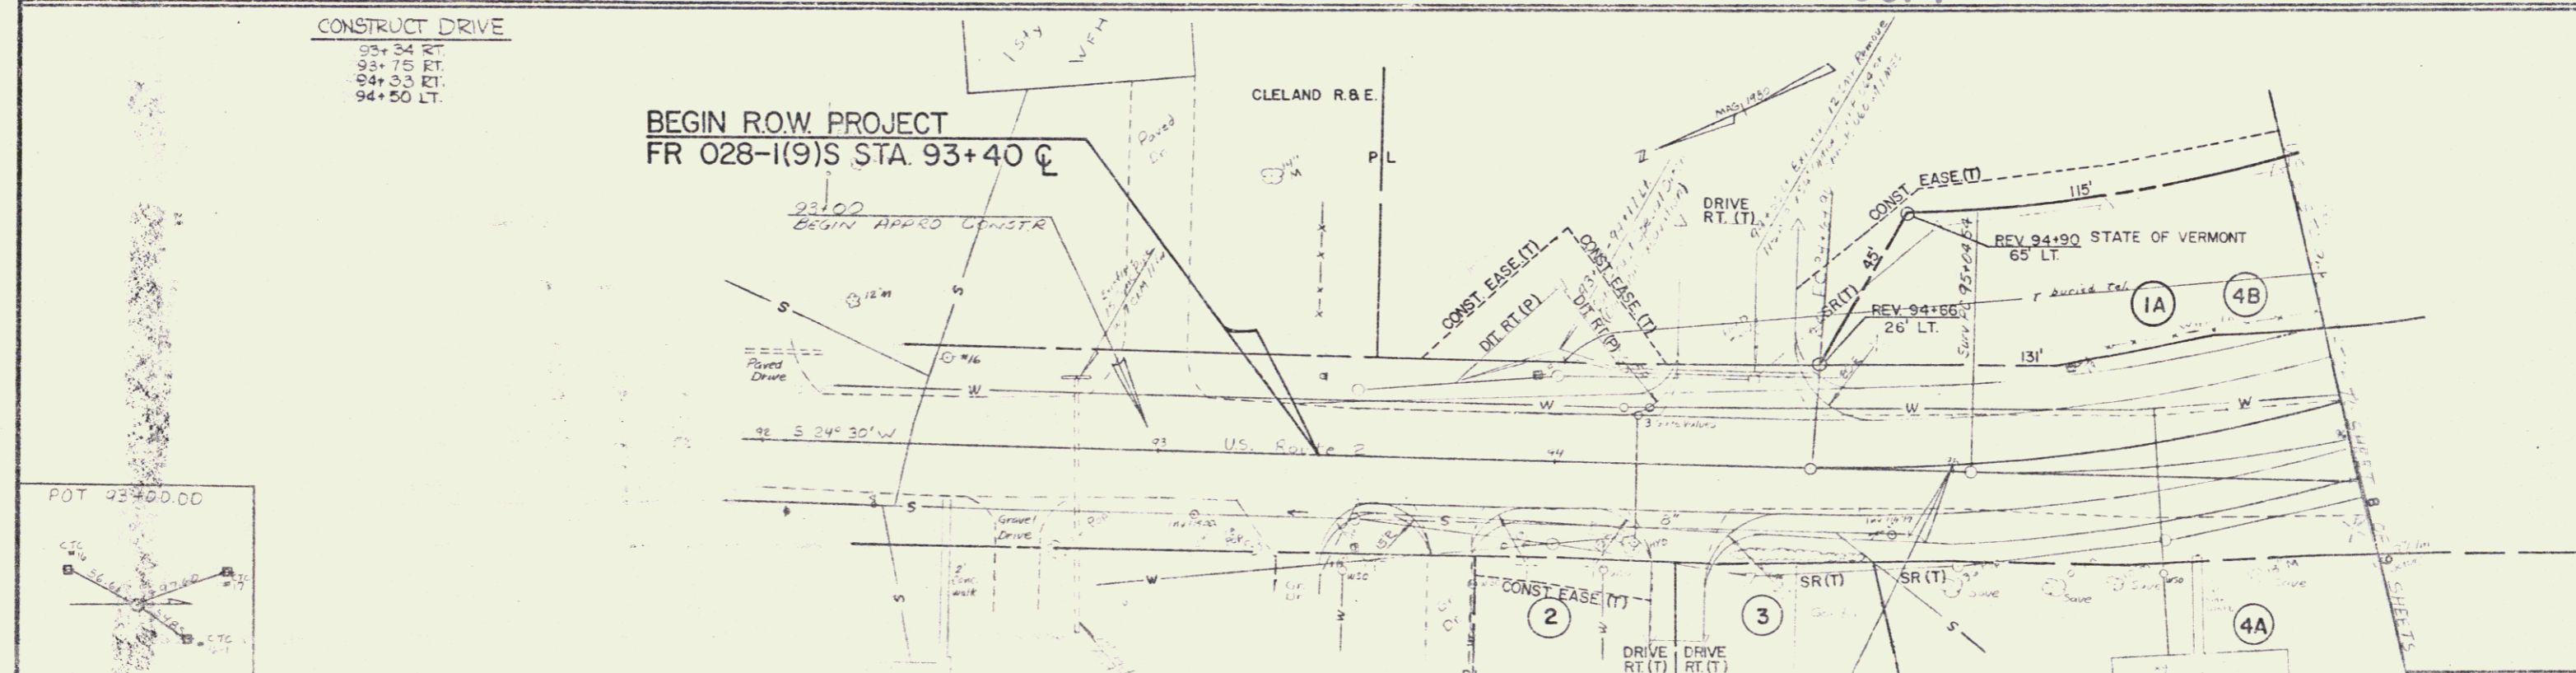

DATUM

VERTICAL	NAD 83
HORIZONTAL	NAD 83

SURVEYED BY	DATE
DRAWN BY	DATE
TRACED BY	DATE

ALBURG
FR 028-1(9)S
SHEET 7 OF 9

2