

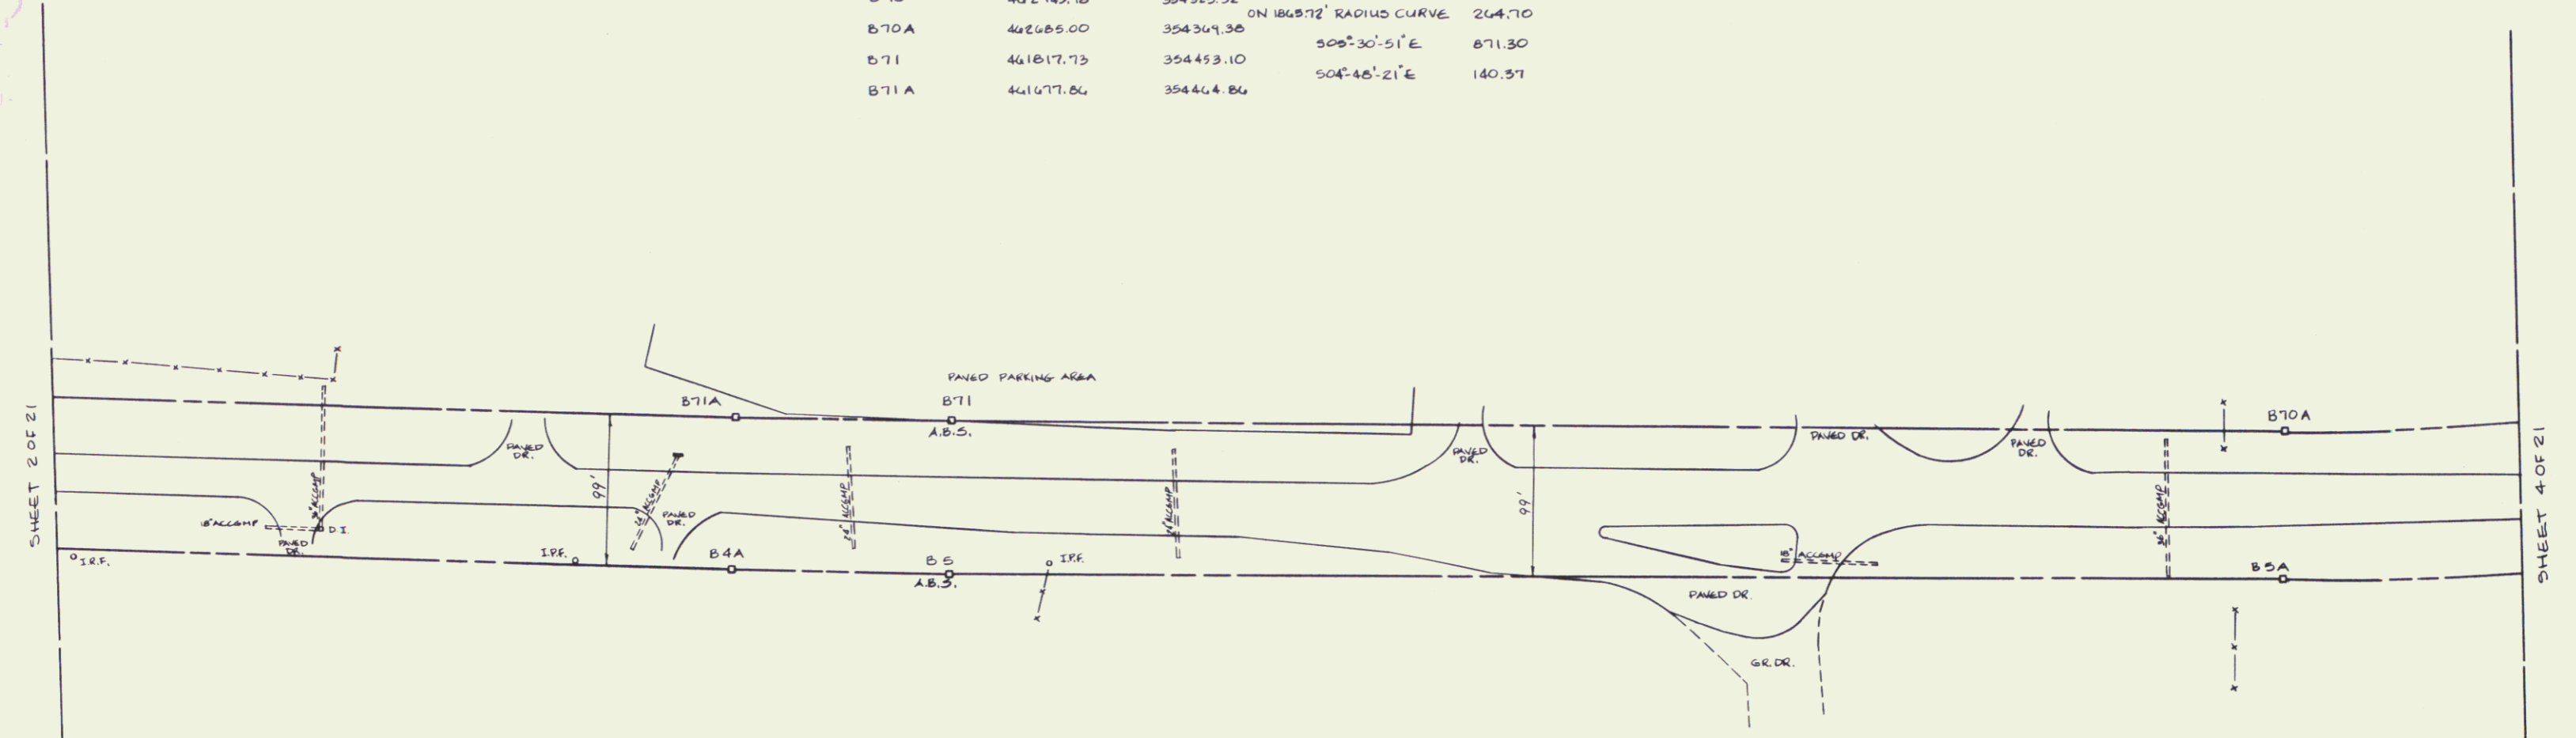


POINT #	NORTH	EAST	BEARING	DIST.
B 70	462145.78	354325.32		
B 70A	462685.00	354369.30	ON 186872' RADIUS CURVE	264.70
B 71	461817.73	354453.10	S08°30'51"E	871.30
B 71A	461677.86	354464.86	S04°48'21"E	140.37

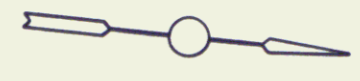

POINT #	NORTH	EAST	BEARING	DIST.
B 4A	461684.94	354563.41	N04°48'21" W	142.81
B 5	461827.25	354551.64	N06°30'51" W	871.30
B 5A	462694.51	354467.92	ON 196472' RADIUS CURVE	278.78
B 6	462969.17	354421.52		

ALL BEARINGS ARE REFERENCED TO THE VERMONT STATE PLANE COORDINATE SYSTEM.

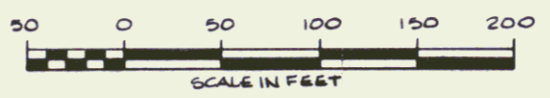

STATE OF VERMONT  
 U.S. ROUTE 7 RIGHT-OF-WAY  
 BRANDON FEGC F 019-B (29)  
 VERMONT SURVEY CONSULTANTS, INC.  
 58 EAST STATE ST.  
 MONTPELIER, VT.

DATE: JULY 1989	SCALE: 1" = 50'	SHEET: 5 OF 21
--------------------	--------------------	-------------------