



POINT #	NORTH	WEST R.O.W.		DIST.
		EAST	BEARING	
B 43 A	467448.21	352073.53	ON 1113.30' RADIUS CURVE	471.06
B 44	467099.24	352384.70	52°-35'-61" E	981.50
B 45	466245.81	352869.47		

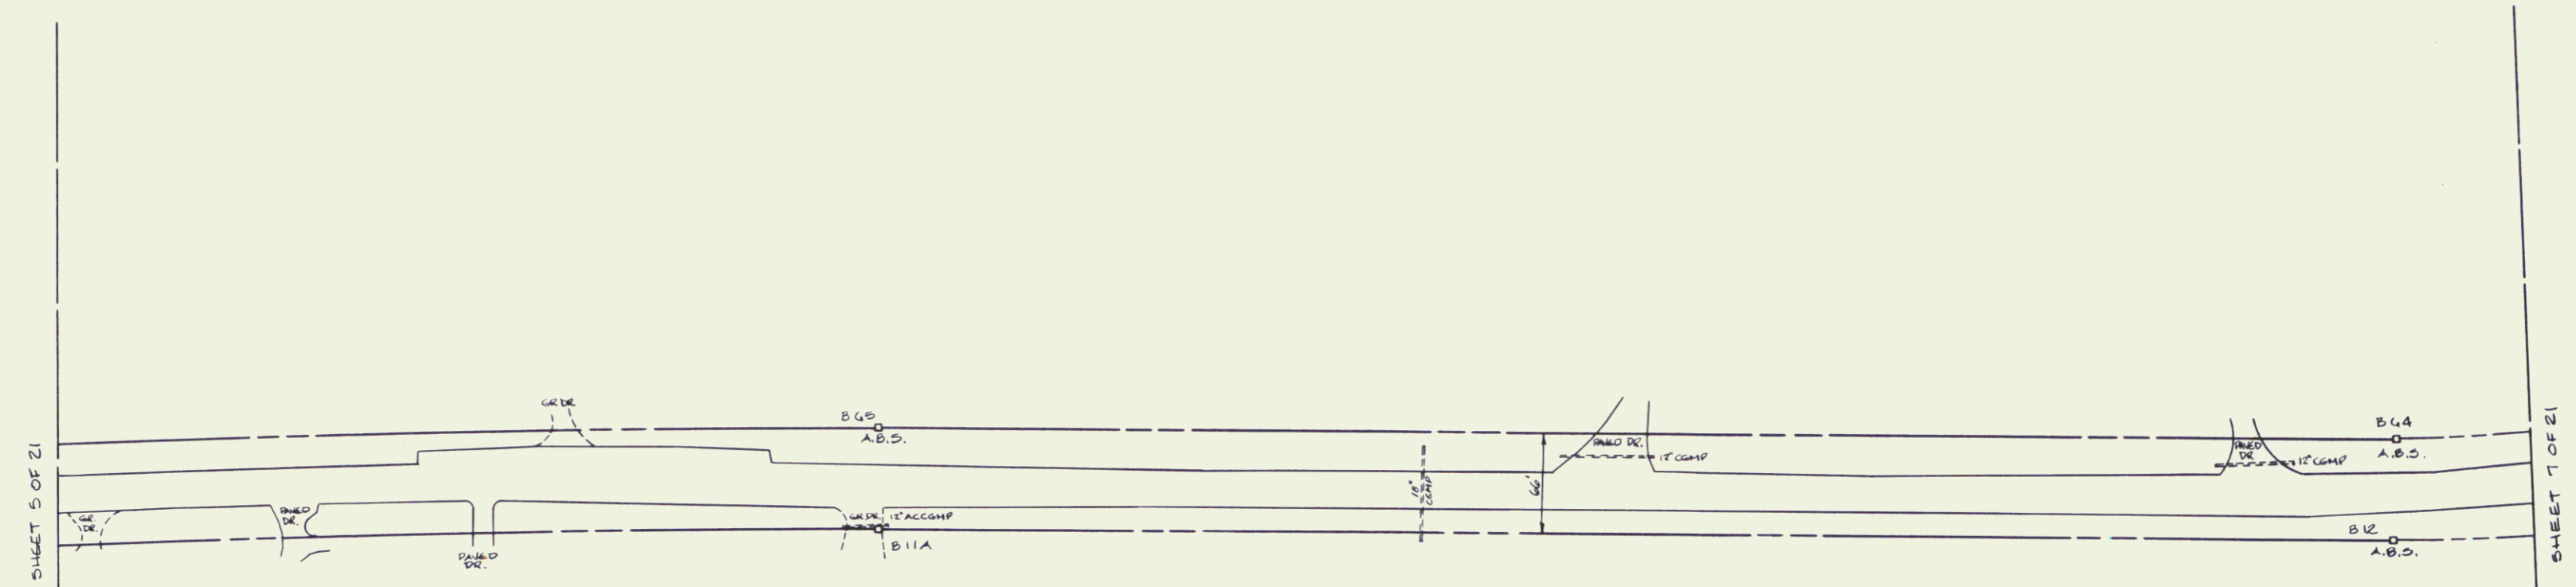

POINT #	NORTH	EAST R.O.W.		DIST.
		EAST	BEARING	
B 11 A	466278.41	352964.85	N29°-35'-51" W	981.50
B 12	467131.84	352442.09	ON 1179.30' RADIUS CURVE	402.29
B 12 A	467441.33	352188.14		

ALL BEARINGS ARE REFERENCED TO THE VERMONT STATE PLANE COORDINATE SYSTEM.

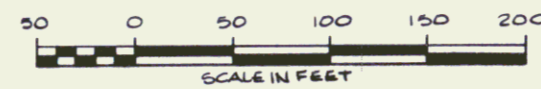

STATE OF VERMONT U.S. ROUTE 7 RIGHT-OF-WAY BRANDON FEGC F 019-5 (29)		
VERMONT SURVEY CONSULTANTS, INC. 58 EAST STATE ST. MONTPELIER, VT.		
DATE: JULY 1989	SCALE: 1" = 50'	SHEET: 6 OF 21