


POINT #	NORTH	EAST	BEARING	DIST.
B 39	484716.47	340207.01	S06°40'-21" E	2061.70
B 39 A	484718.75	340207.01	S05°18'-46" W	108.70
B 40	484425.21	340201.02		



POINT #	NORTH	EAST	BEARING	DIST.
B 37	484639.06	340301.07	NW-19°-14" W	101.43
B 37 A	484736.40	340272.97	N06°40'-21" W	2061.70
B 38	484784.14	340033.01		

ALL BEARINGS ARE REFERENCED TO THE VERMONT STATE PLANE COORDINATE SYSTEM.

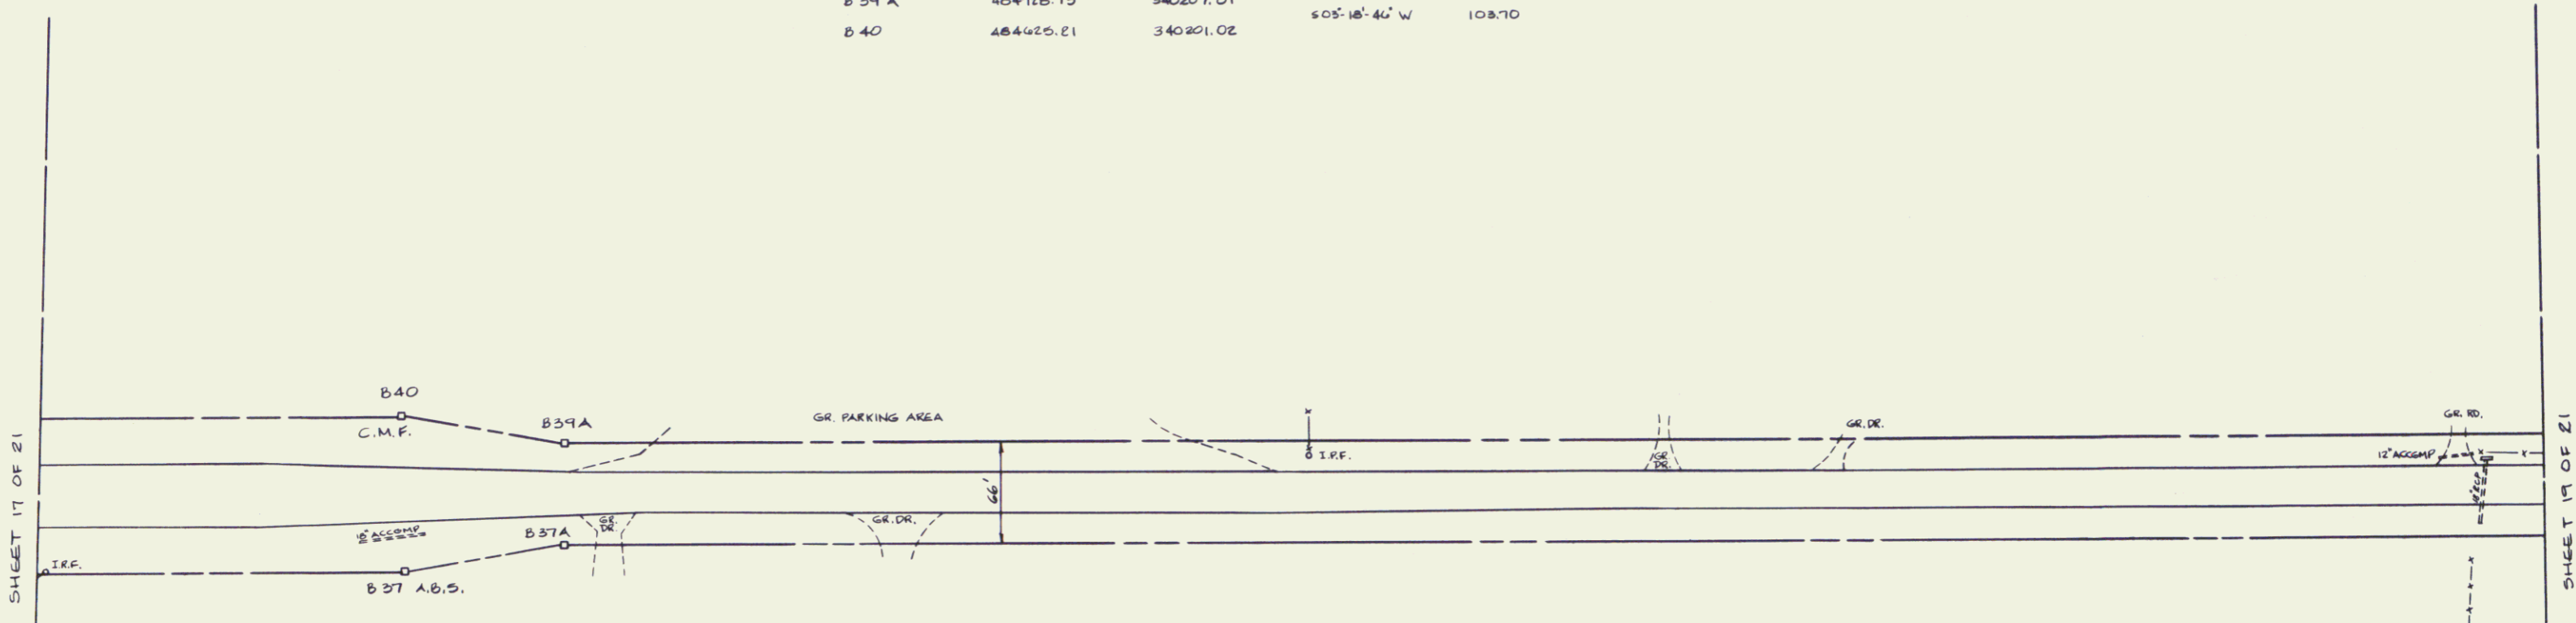

STATE OF VERMONT
 U.S. ROUTE 7 RIGHT-OF-WAY
 BRANDON FECC F 019-B (29)
 VERMONT SURVEY CONSULTANTS, INC.
 58 EAST STATE ST.
 MONTPELIER, VT.

DATE:	SCALE:	SHEET:
JULY 1989	1" = 50'	19 OF 21

19