


POINT #	NORTH	EAST	BEARING	DIST.
L42 A	508474.69	340391.43	S12°20'47" W	381.56
L43 A	508101.96	340309.84	N33°54'49" W	11.34
L43	508111.37	340303.52	S08°55'30" W	291.29
L43 B	502823.61	340256.33	S15°25'34" W	224.38
L44	502605.35	340196.24	S04°00'37" W	294.14
L45	502309.93	340171.50	S08°52'33" W	649.00
L45 A	501466.70	340077.36	S33°45'16" W	55.04
L46	501622.94	340044.78		

SHEET 7 OF 12

SHEET 9 OF 12

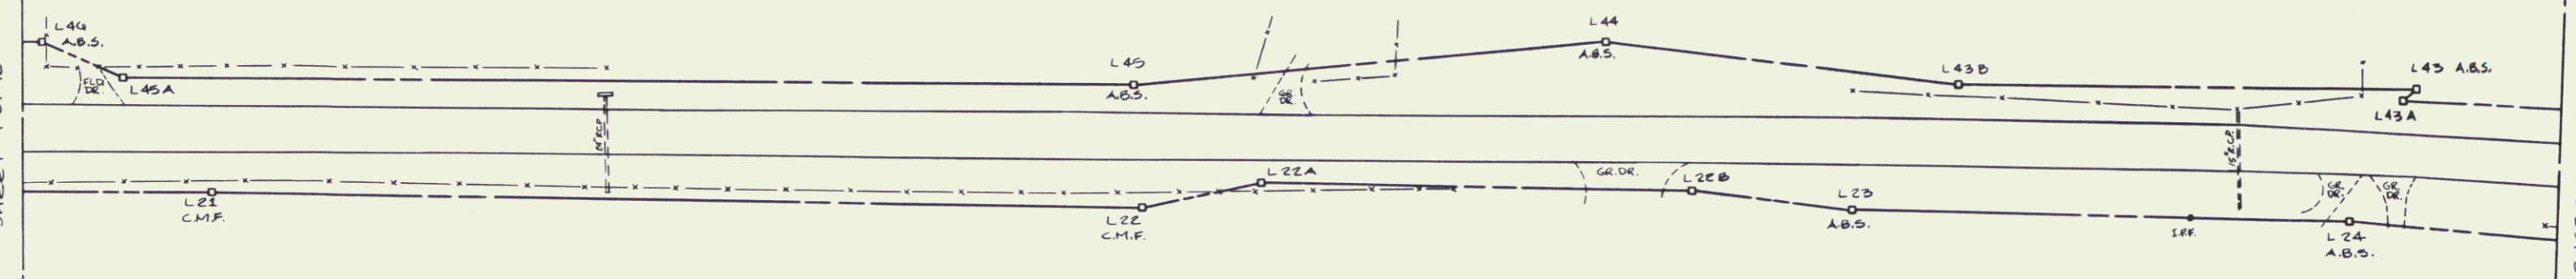

POINT #	NORTH	EAST	BEARING	DIST.
L21	501710.38	340157.28	N09°29'24" E	595.24
L22	502297.47	340255.52	N00°47'06" W	76.15
L22 A	502373.61	340254.48	N09°15'39" E	275.00
L22 B	502645.03	340296.73	N15°53'43" E	100.72
L23	502741.90	340324.52	N09°36'15" E	318.69
L24	503056.12	340379.49	N13°55'26" E	246.56
L25	503297.38	340439.30		

ALL BEARINGS ARE REFERENCED TO THE VERMONT STATE PLANE COORDINATE SYSTEM.



STATE OF VERMONT US ROUTE 7 RIGHT-OF-WAY LEICESTER REC FOR-3 (29)		
VERMONT SURVEY CONSULTANTS, INC. 58 EAST STATE ST. MONTPELIER, VT.		
DATE: JULY 1989	SCALE: 1" = 50'	SHEET: 8 OF 12