

SPECIAL DITCH STONE FILL TYPE I  
 LT  
 236+00-235+45  
 247+72-249+82

EROSION MATTING  
 LT  
 240+50-241+00 234+00-234+00  
 242+08-244+00 248+50-250+00

CONSTRUCT DRIVES  
 RT  
 241+93 244+39  
 246+70 248+33  
 245+55  
 246+45 (to be supplied  
 & seeded)  
 (7428)31+10  
 250+00


REINFORCE DISPOSAL OF  
 EXISTING GRAVITY PAIR  
 LT  
 246+60-247+05

GRADE AND STD STEEL BAR  
 1/4" WOOD POSTS, TYPE II  
 LT  
 246+60-249+00 244+15-246+00

24 SAND BORROW  
 234+00-246+75  
 243+35-250+00

Note: 246+80 LT-247+20 LT  
 Save as many bushes  
 as possible.

246+95 Station 62' LT  
 NEW 30" x 17" ALUMINUM (C. 675)  
 SEE NEW 8" x 150' CMP  
 SHEET FOR ADDITIONAL  
 DETAILS.

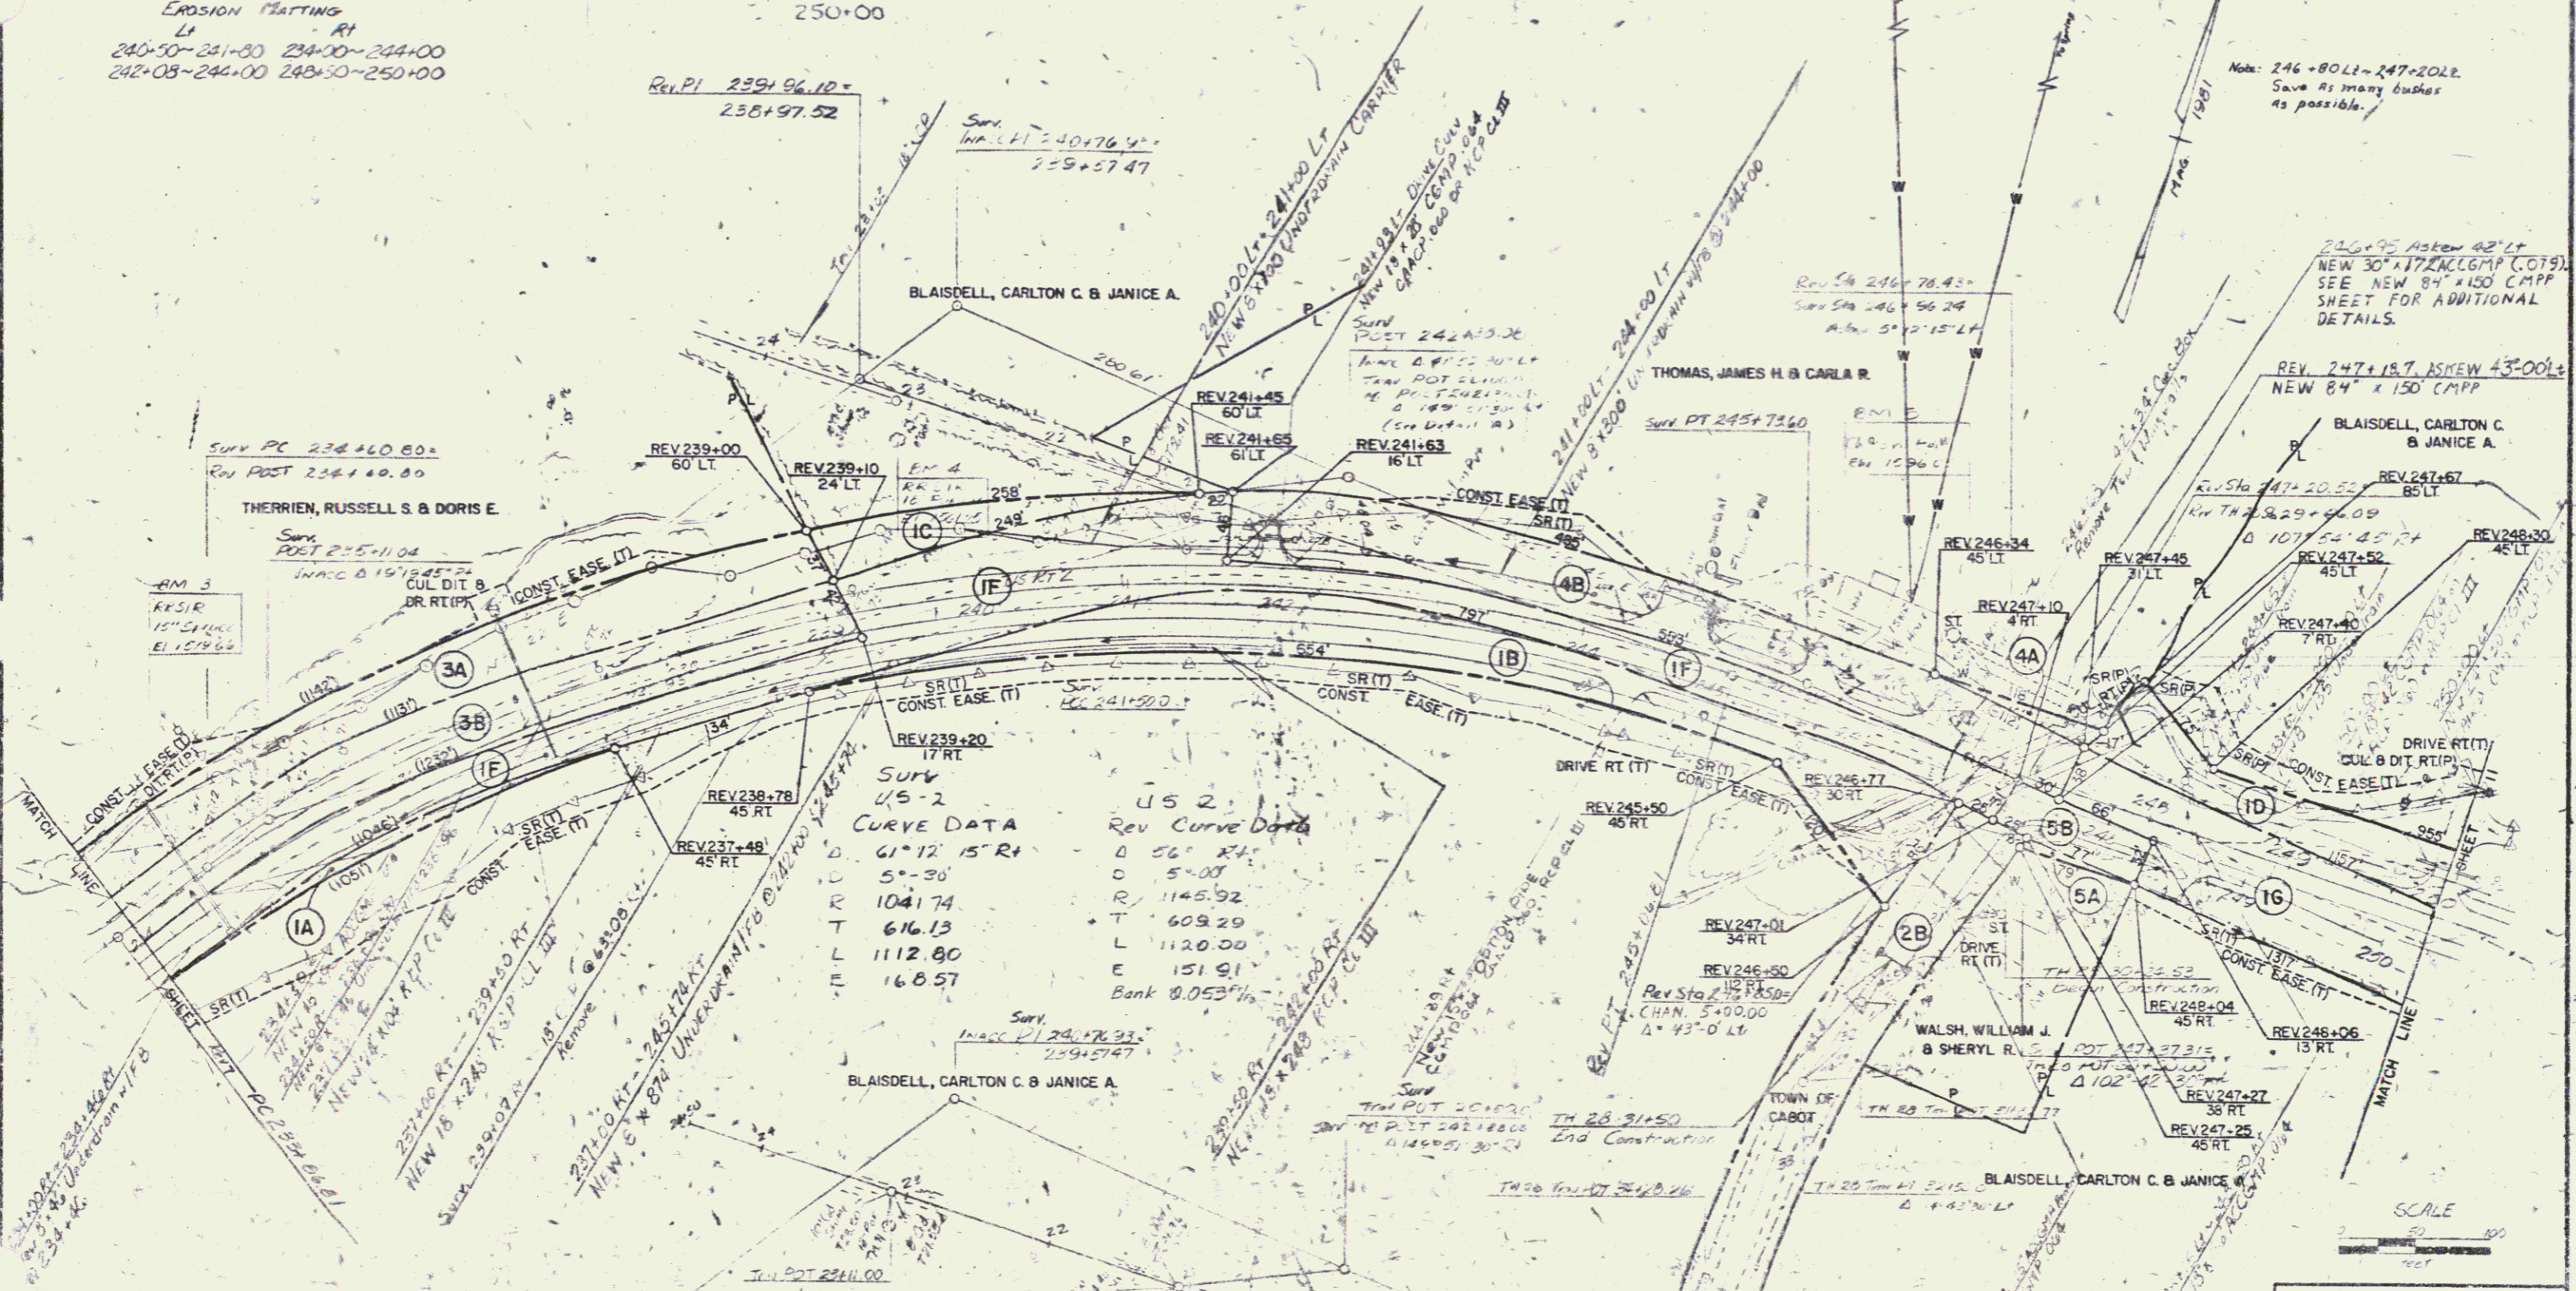

U.S. 2  
 Rev Curve Data

|      |             |
|------|-------------|
| D    | 61°12'15" R |
| R    | 56.00       |
| L    | 1145.92     |
| T    | 609.29      |
| L    | 1120.00     |
| E    | 151.91      |
| E    | 168.57      |
| Bank | 0.053'      |

U.S. 1  
 Curve Data

|      |             |
|------|-------------|
| D    | 61°12'15" R |
| R    | 56.00       |
| L    | 1145.92     |
| T    | 609.29      |
| L    | 1120.00     |
| E    | 151.91      |
| E    | 168.57      |
| Bank | 0.053'      |

DATUM  
 VERTICAL: 119.10 1929  
 HORIZONTAL: 119.10

DETAIL A

SCALE  
 1" = 50'  
 SURVEYED BY: [Signature] DATE: [Date]  
 DRAWN BY: [Signature] DATE: [Date]  
 TRACED BY: [Signature] DATE: [Date]  
 CABOT  
 F 028-3(14)  
 9 OF 14