

24" SAND BORROW
250+00~255+00
265+50~266+00

EROSION MATTING
LT RT
250+26~255+00 250+00~252+35

257+78~253+83
259+13~260+63

Special Ditch w Stone Fill
LT RT
255+25~257+75

CONSTRUCT DITCHES
LT RT
253+50

253+96.6
260+81
250+00
SPECIAL DITCH
LT RT
257+78 258+22


EXCAVATION & REMOVAL OF ROAD SURFACES & PAVEMENTS
251+50~254+50

CONSTRUCT TURNOUT
LT
265+50~266+00

SLABIFYING EXISTING PAVEMENTS
253+00~260+50

CURVE DATA:
D 32846 0' L1
D 4°
K 1492.40
T 421.14
L 613.20
E 65.63

REV CURVE DATA
D 27° 33' 50" L1
D 5°
R 1145.92
T 281.08
L 551.28
E 35.97
Bank 0.053 1/4

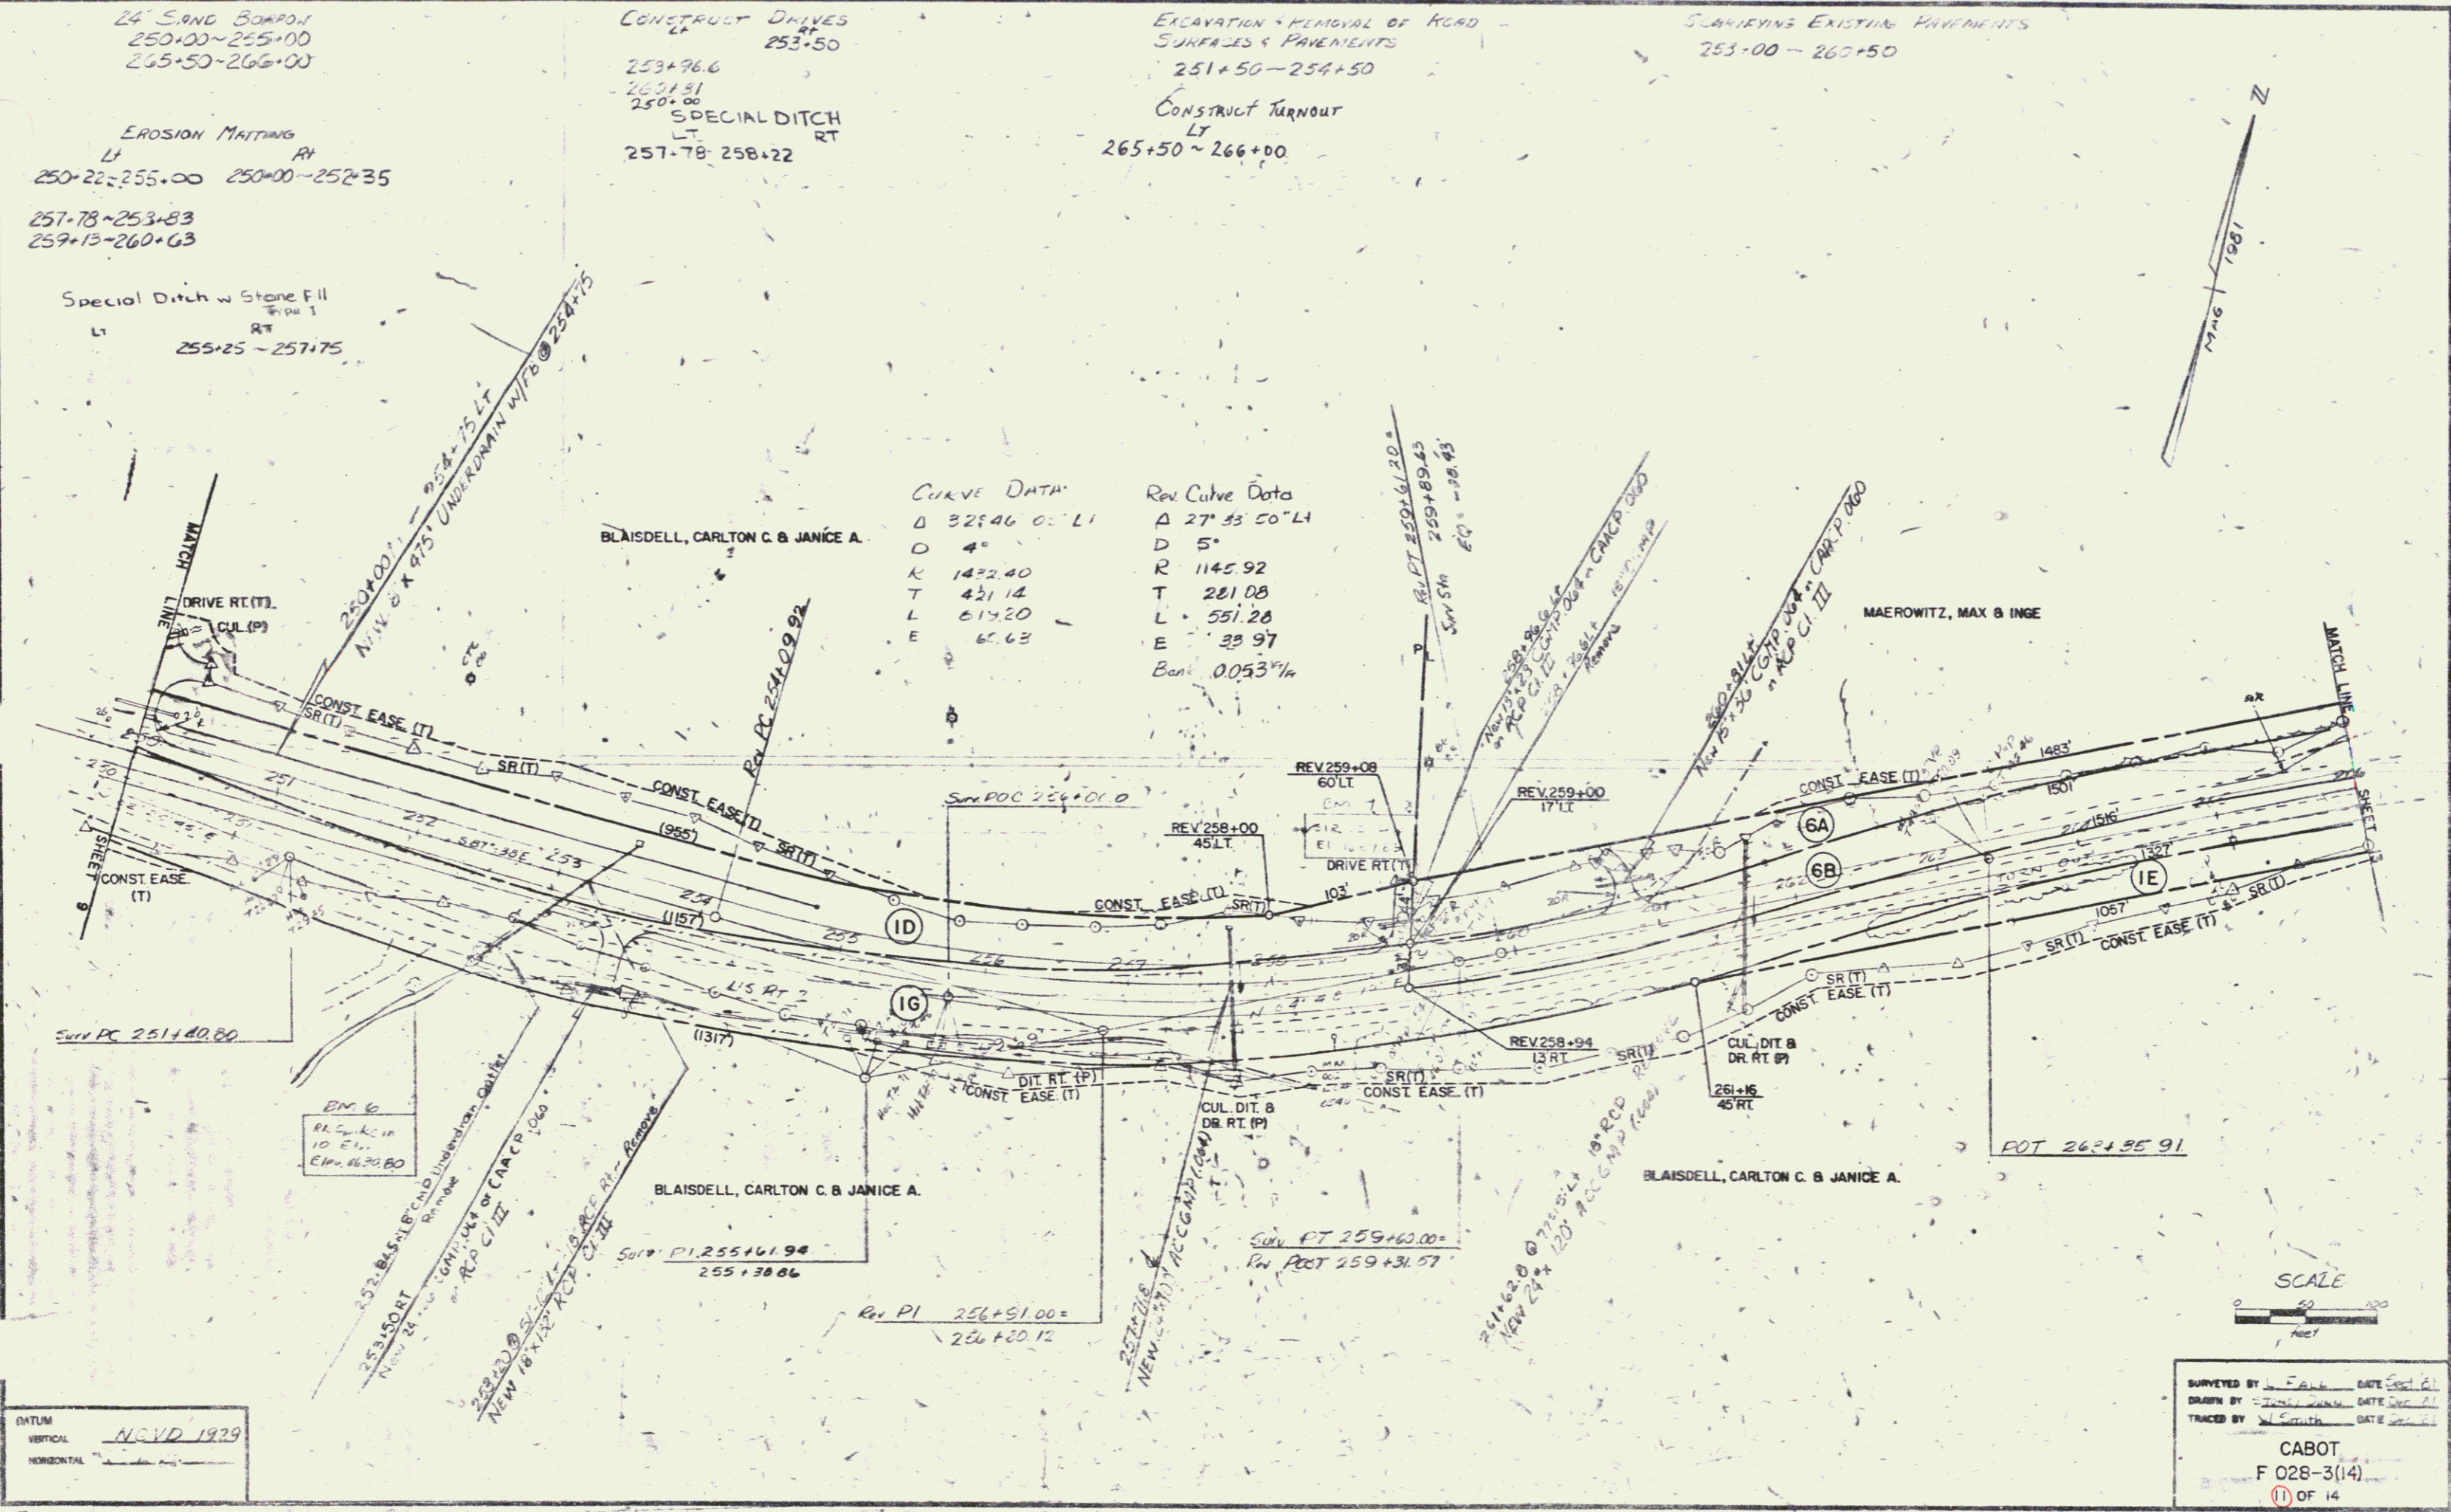

DATE: NOV 19 1979
VERTICAL: AS SHOWN
HORIZONTAL: AS SHOWN

SURVEYED BY: F. A. B. DATE: 10/21/79
DRAWN BY: J. J. S. DATE: 11/1/79
TRACED BY: J. J. S. DATE: 11/1/79
CABOT
F 028-3(14)
1 OF 14