

CONSTRUCT SPECIAL DITCH  
(to be paid under Item 203.15)  
LT  
271+50 ~ 274+00

CONSTRUCT DRIVES  
LT RT  
278+75 268+00  
279+85 271+95  
277+00 ~ 278+00


SCARIFYING EXISTING PAVEMENT  
269+50 ~ 271+00

24" SAND DRAIN  
269+00 ~ 268+50  
275+25 ~ 278+75

CONSTRUCT TURNOUT  
LT  
266+00 ~ 268+50

END ROW PROJECT  
F 028-3(14) STA. 283+00 CL

CURVE DATA  
D 6.46 20 LT  
D 20.90  
R 229.63  
T 175.79  
L 250.89  
E 672  
Bank 0.0467 ft

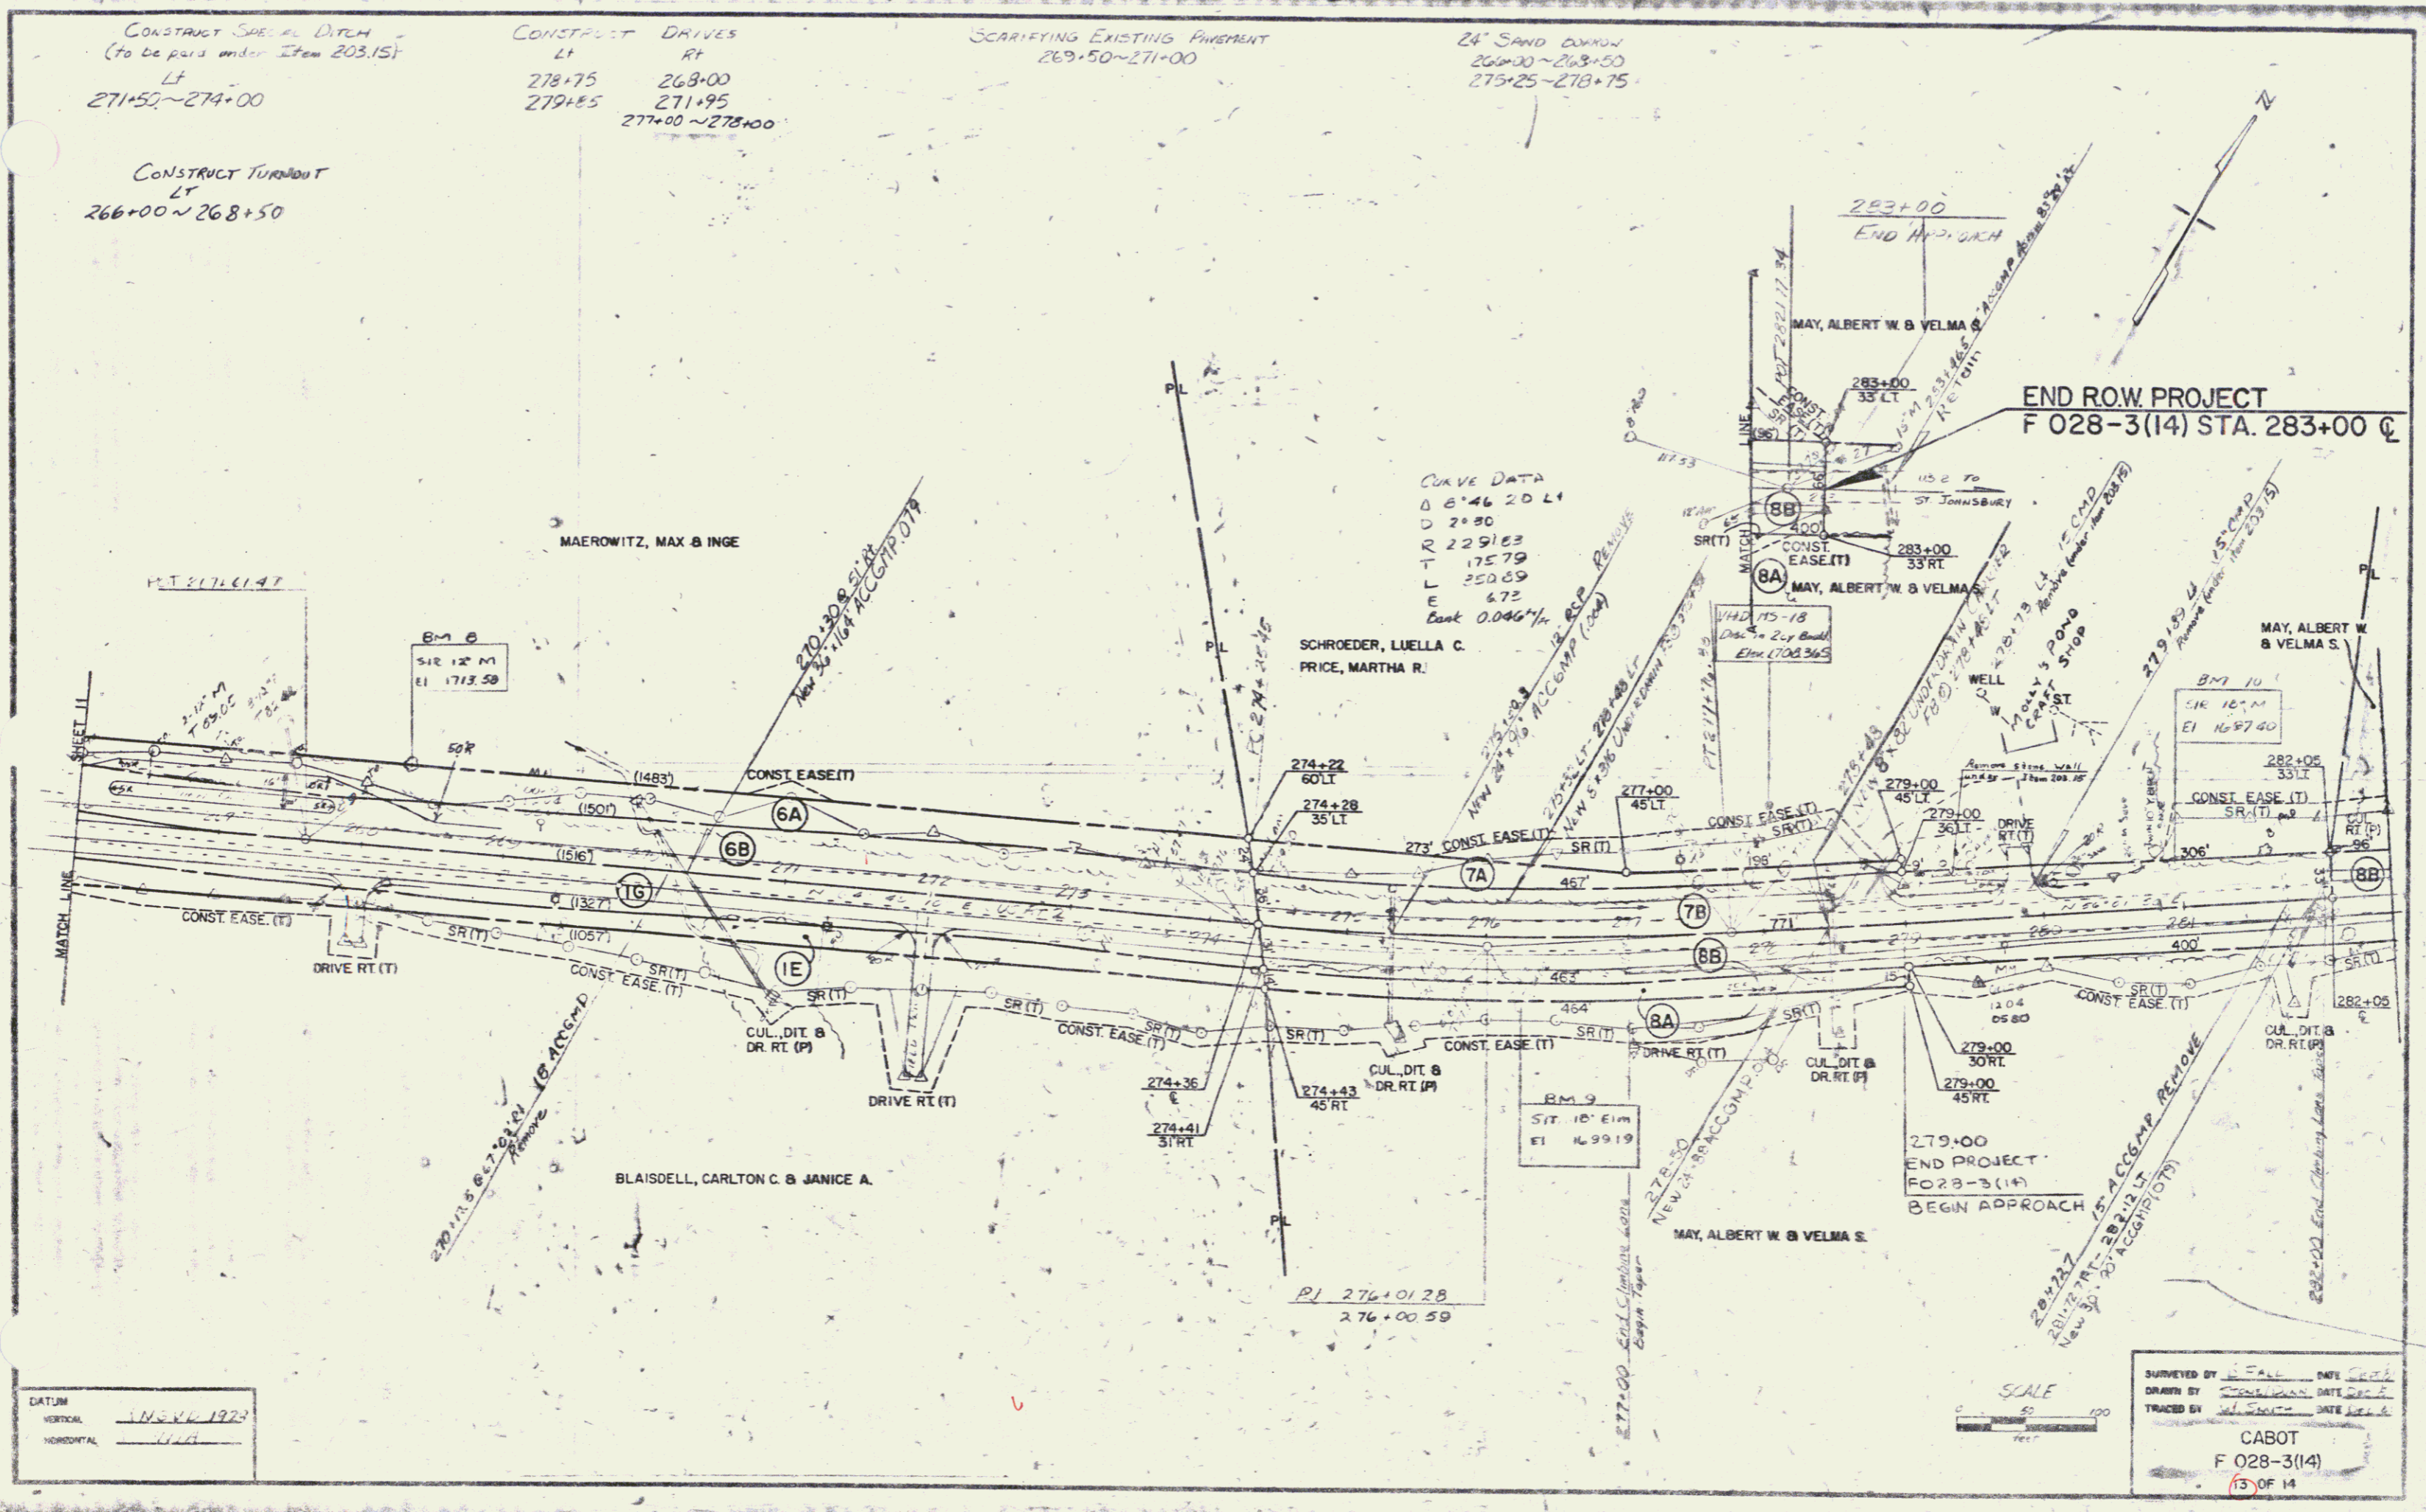

DATUM  
VERTICAL 1985 V.V. 1973  
HORIZONTAL U.T.M.

SCALE  
1" = 100'

SURVEYED BY [Signature] DATE [Date]  
DRAWN BY [Signature] DATE [Date]  
TRACED BY [Signature] DATE [Date]  
CABOT  
F 028-3(14)  
13 OF 14

5