



PLAN
 DRAWN BY: J. W. B. / J. W. B.
 CHECKED BY: J. W. B. / J. W. B.
 DATE: 07-14-94
 SHEET NO. 16 OF 24

DATUM
 VERTICAL NGVD 1929
 HORIZONTAL N/A


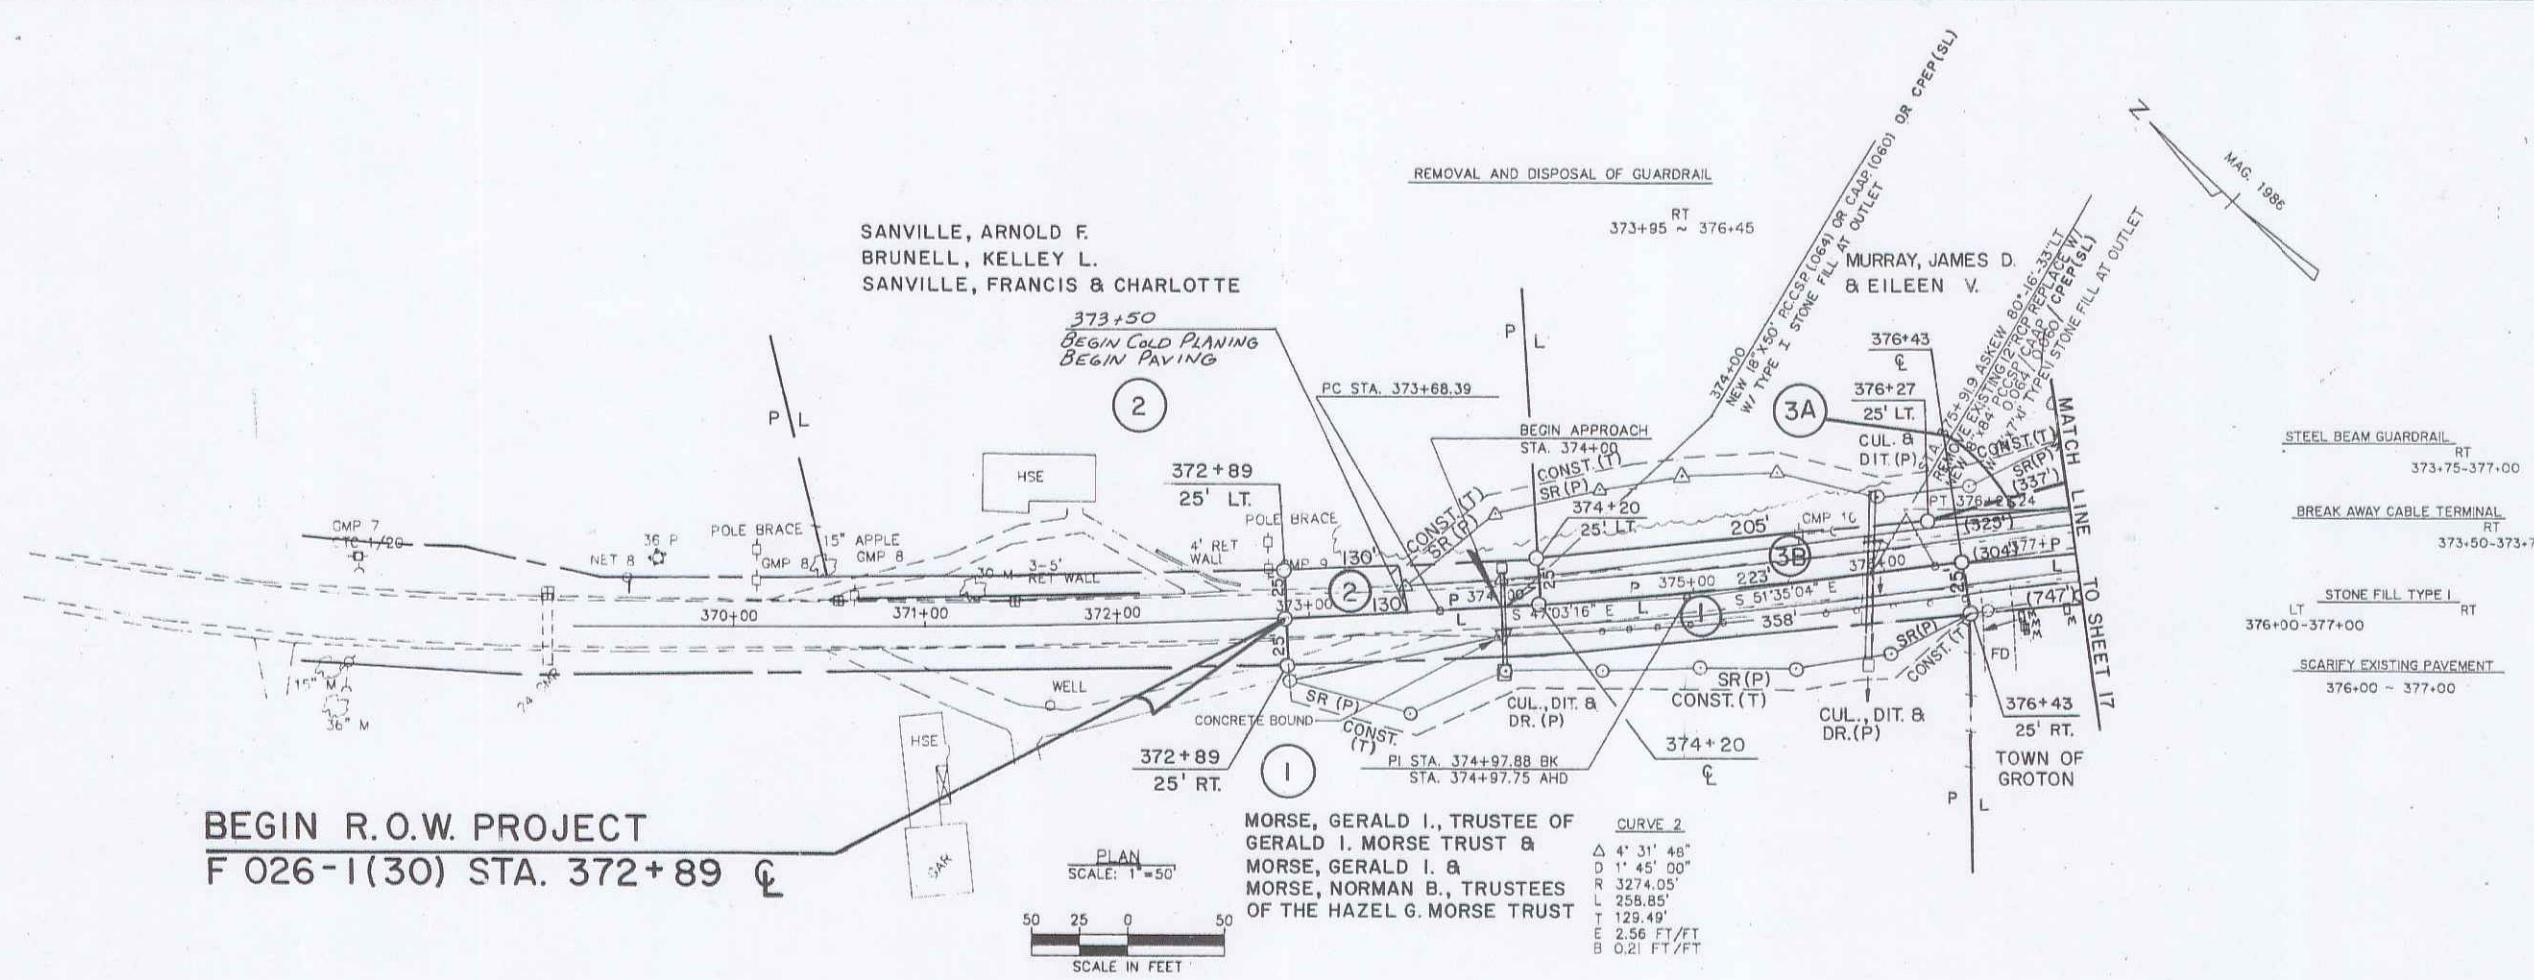


BEGIN R.O.W. PROJECT
 F 026-1(30) STA. 372+89

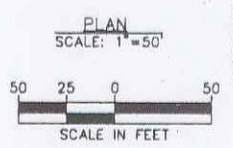

CURVE 2
 Δ 4' 31" 48"
 D 1' 45" 00"
 R 3274.05'
 L 258.85'
 T 123.49'
 E 2.56 FT/FT
 B 0.21 FT/FT

07-14-94 REVISION I

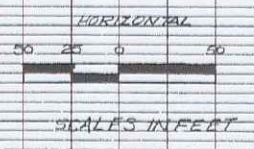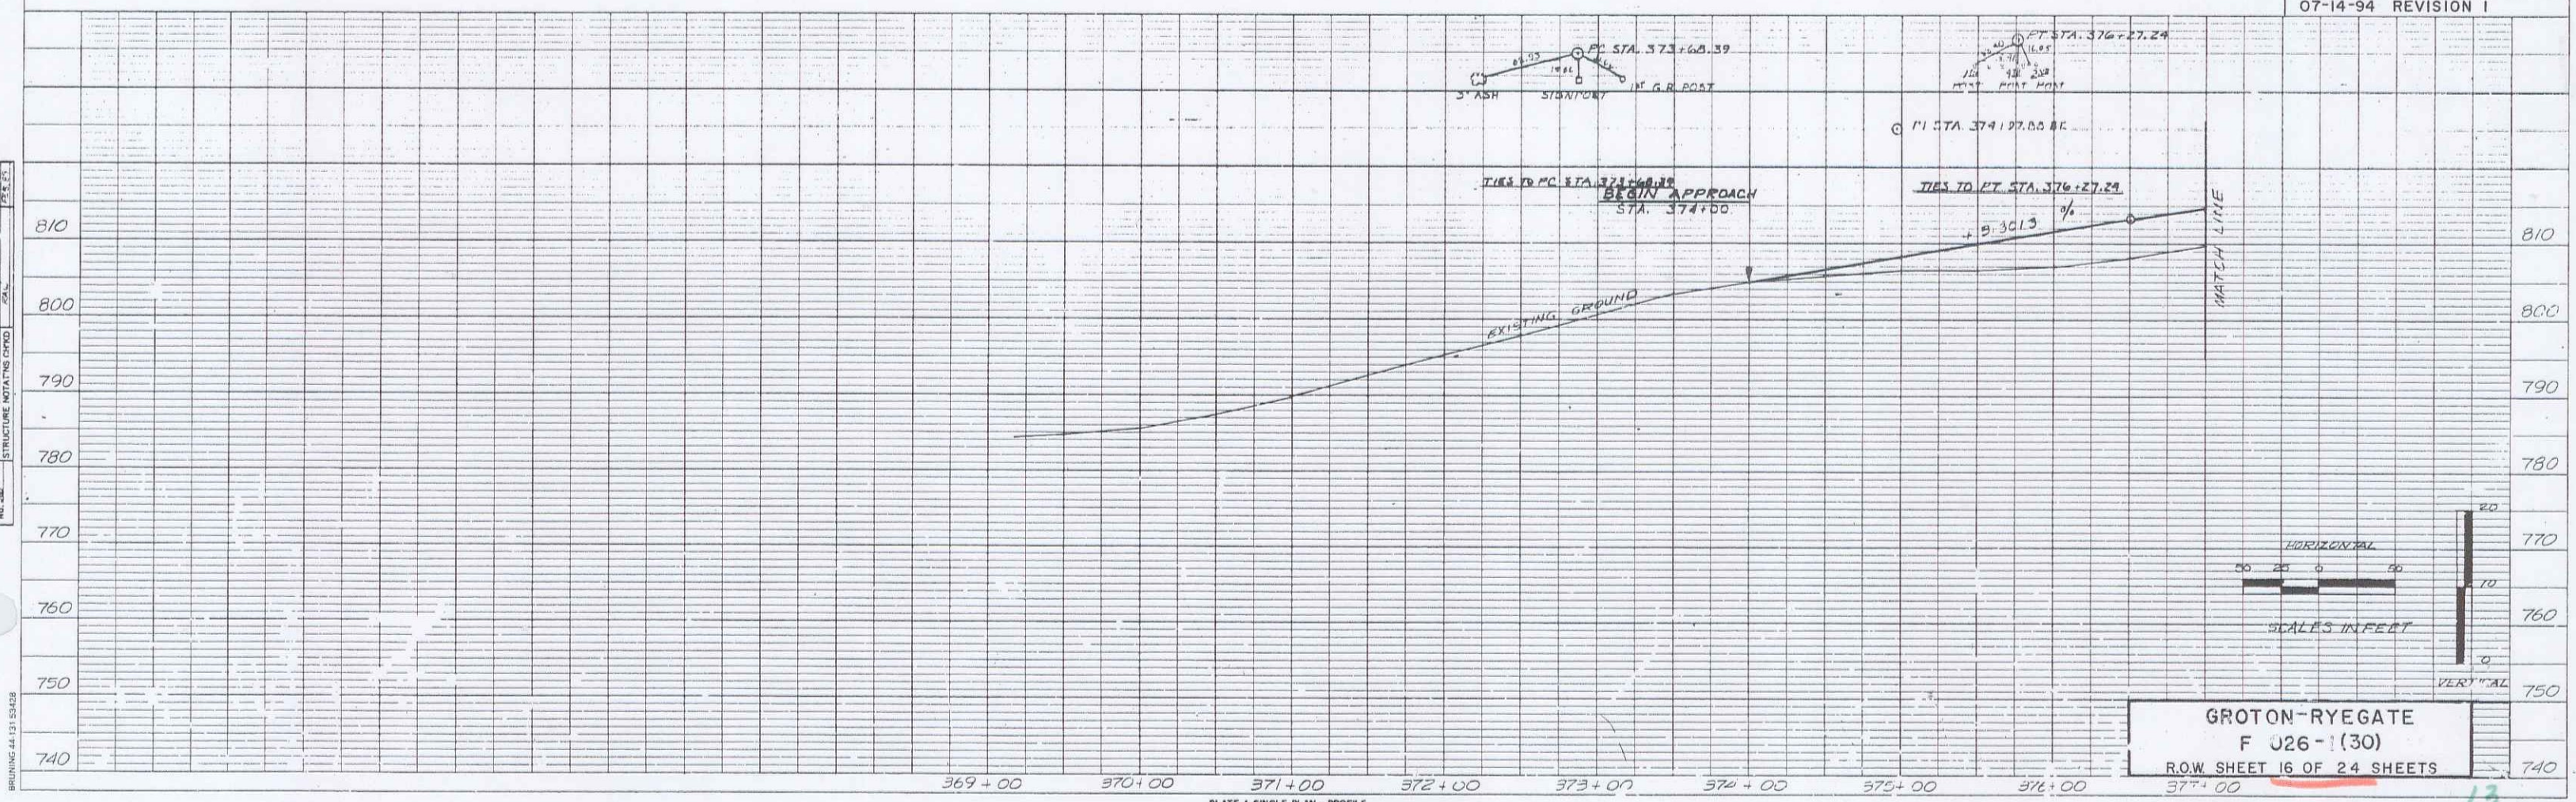

GROTON-RYEGATE
 F 026-1(30)
 R.O.W. SHEET 16 OF 24 SHEETS