
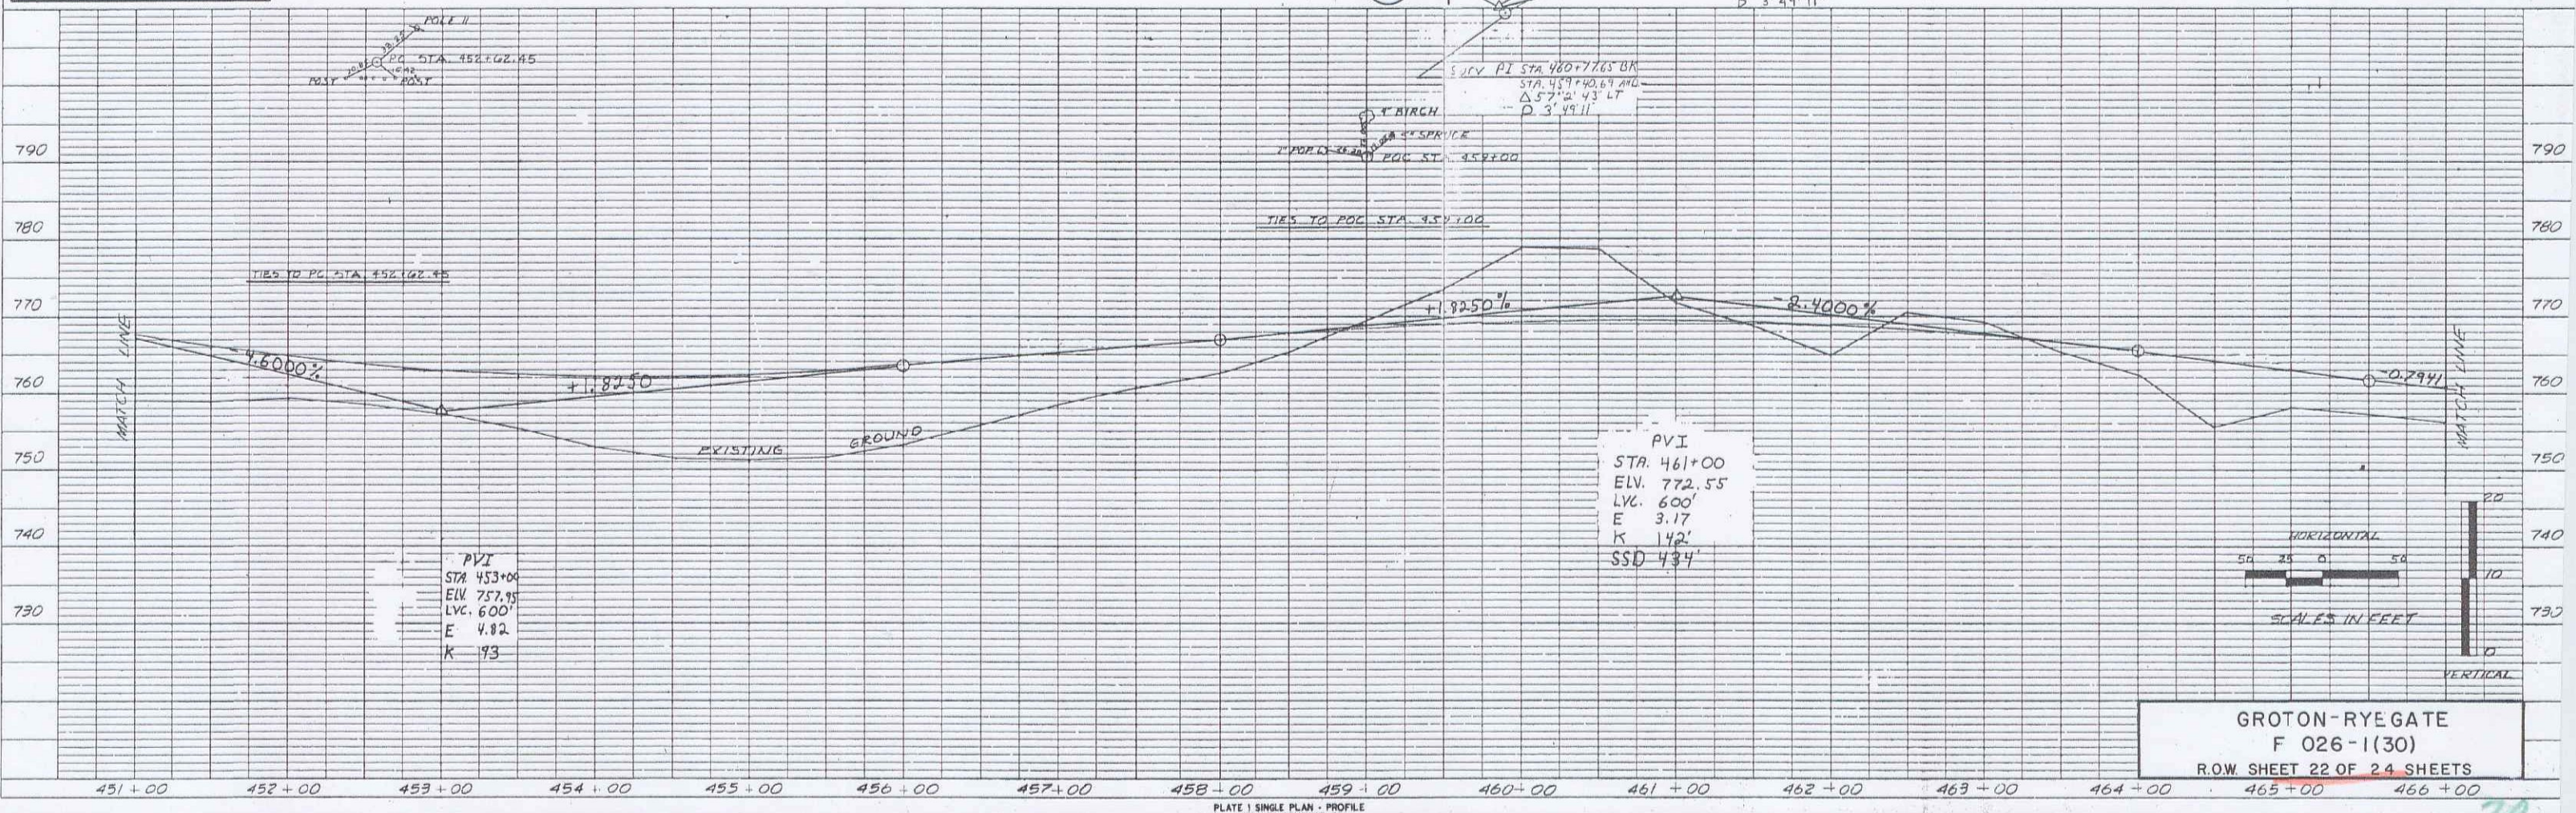


PLAN
 SUBMITTED: []
 DESIGNED: []
 CHECKED: []
 DATE: []

PROFILE
 SUBMITTED: []
 DESIGNED: []
 CHECKED: []
 DATE: []

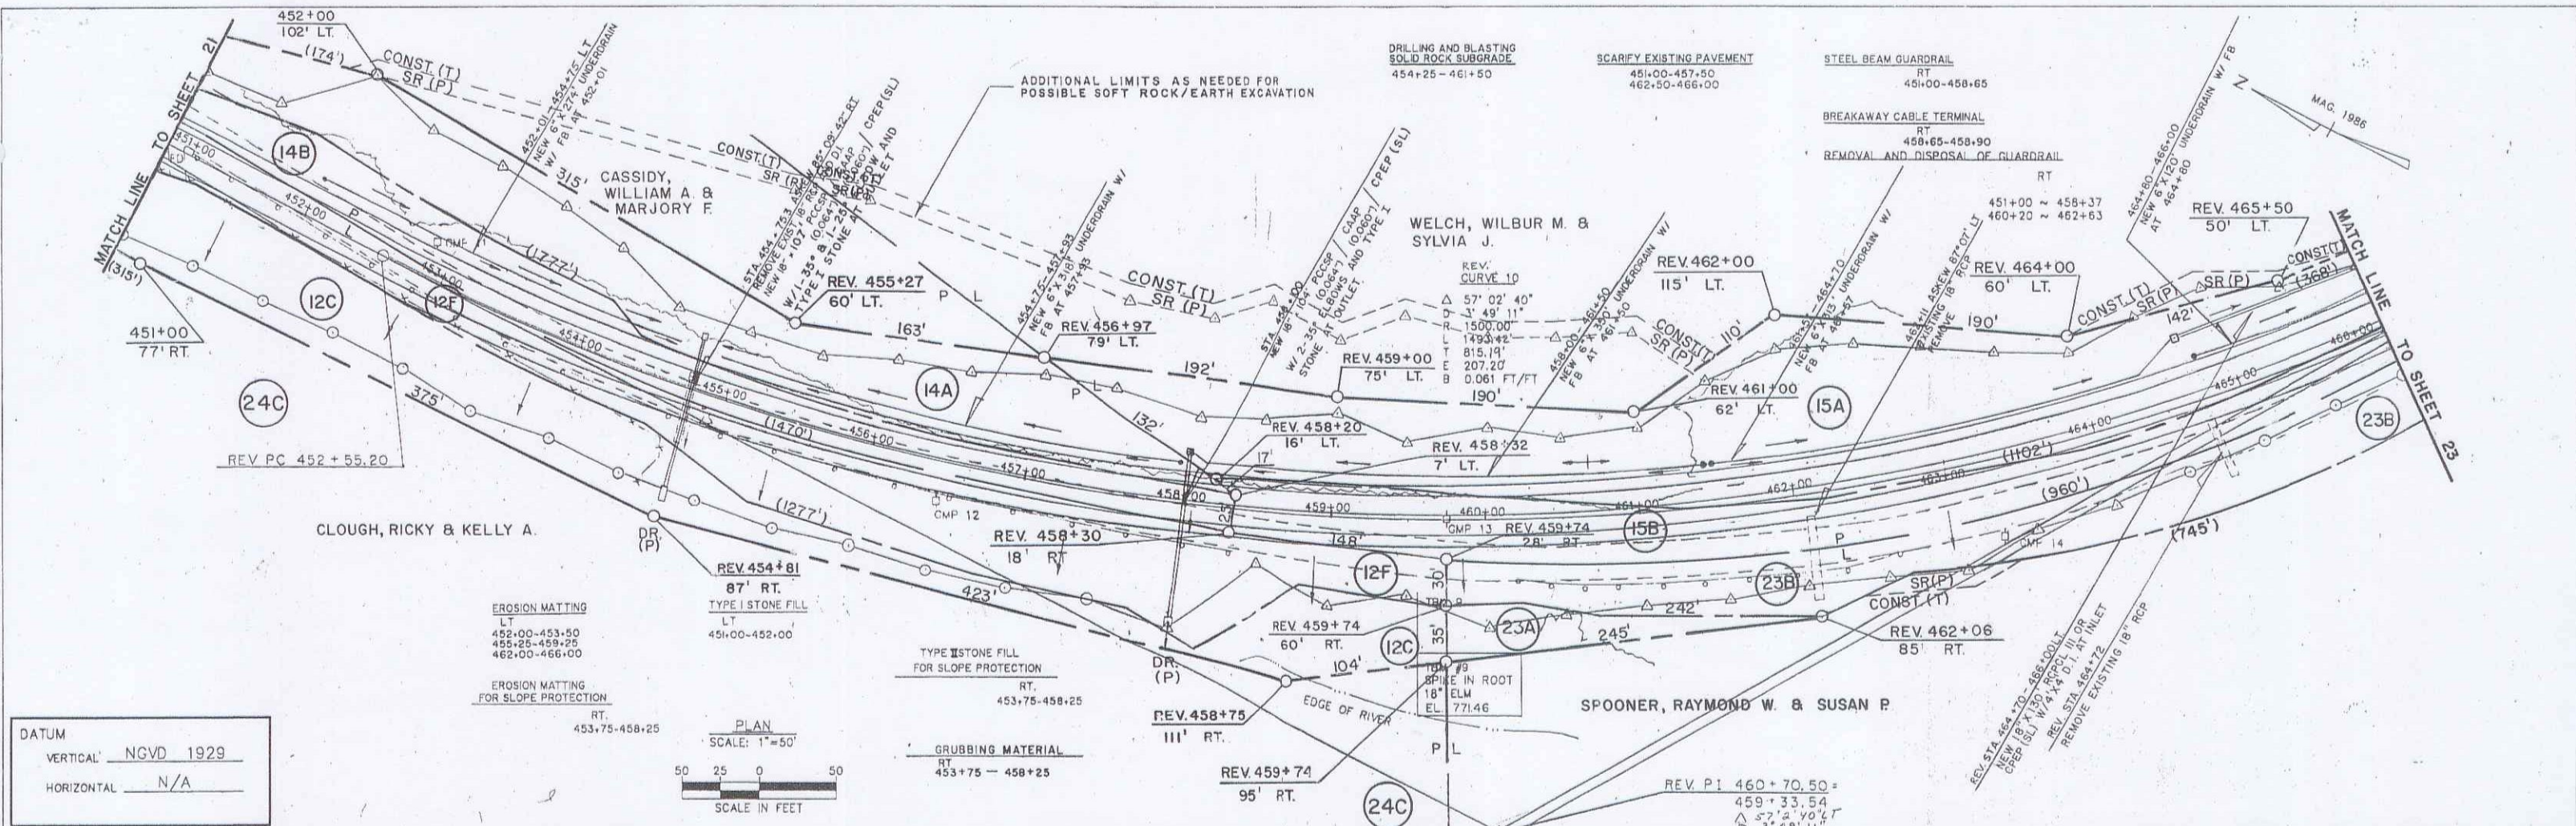

GROTON-RYEGATE
 F 026-1(30)
 R.O.W SHEET 22 OF 24 SHEETS