
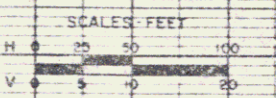


PLAN
 ROUTE BOOK
 SHEET NO. 16

PROFILE
 ROUTE BOOK
 SHEET NO. 16

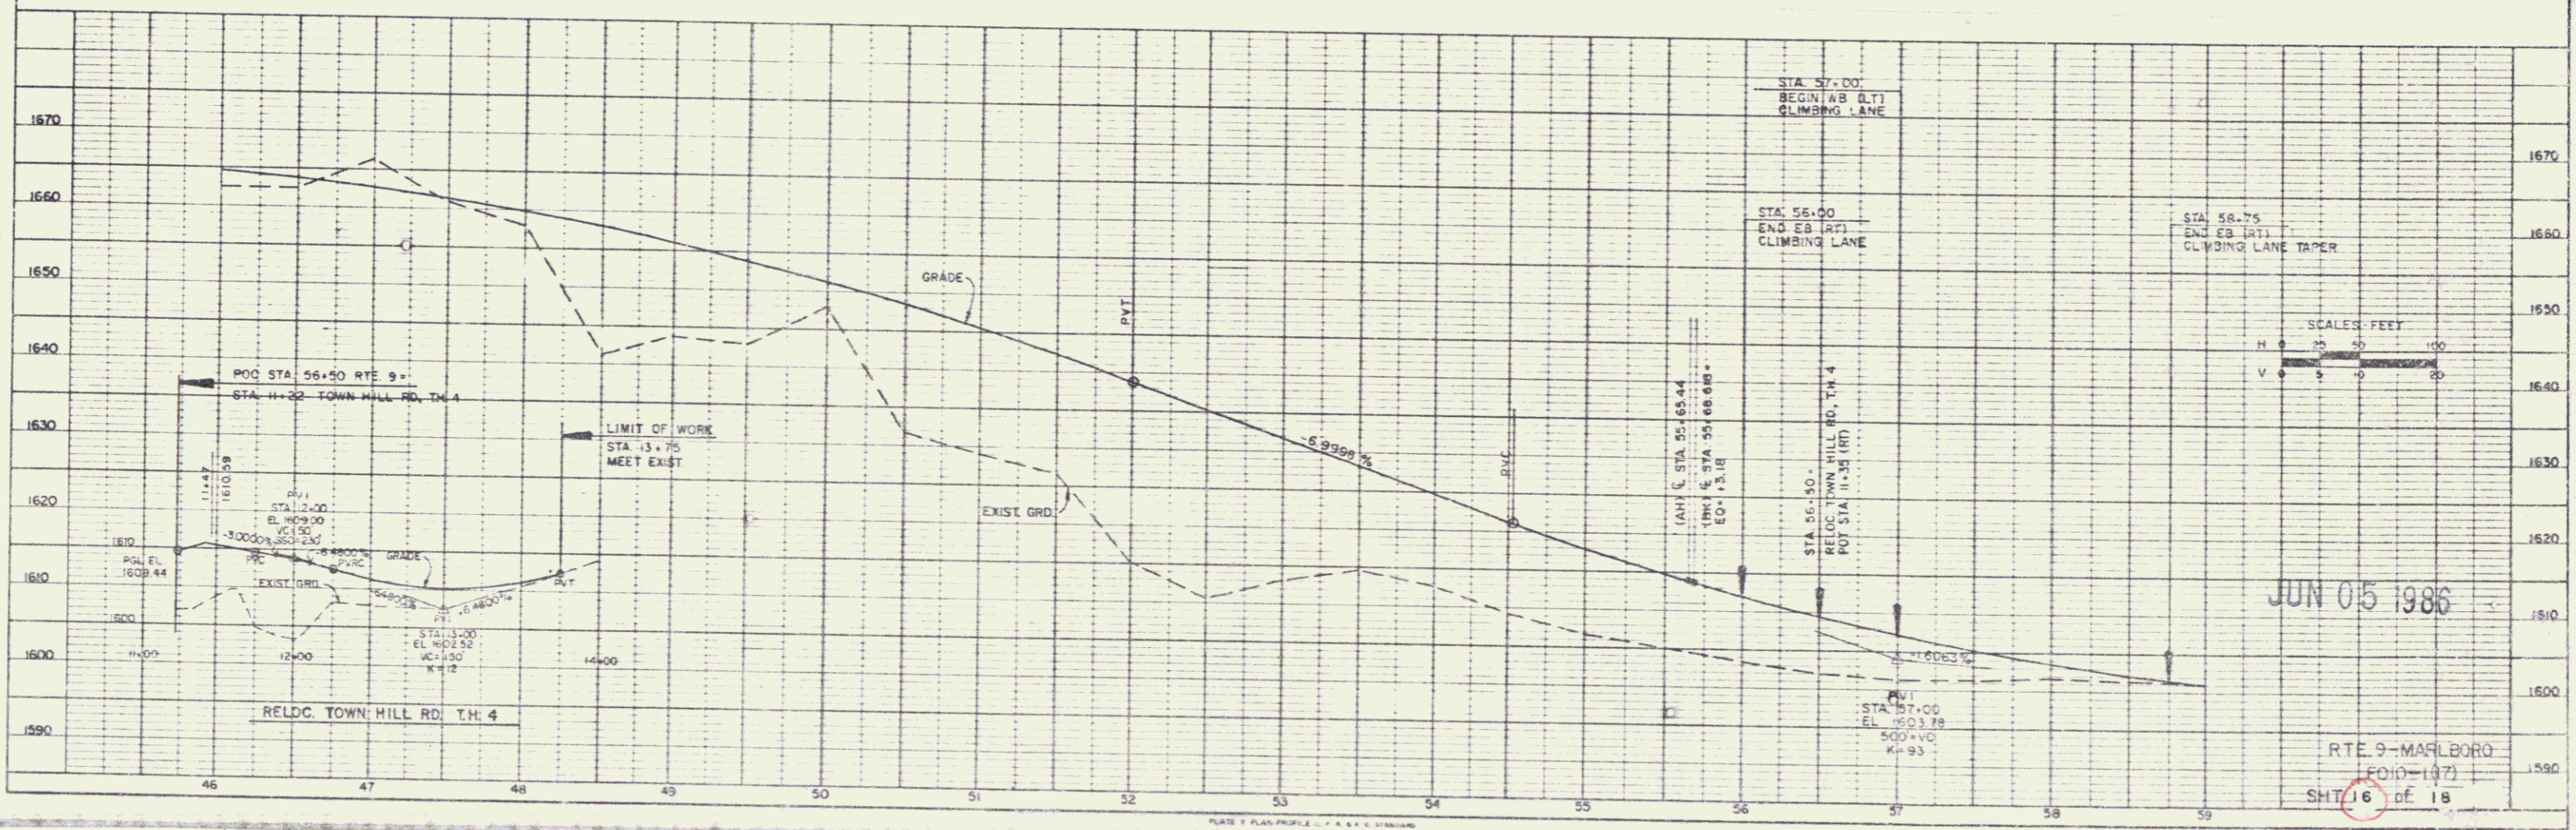

JUN 05 1986

RTE. 9-MARLBORO
 (FOID-107)
 SH. 16 of 18

10