
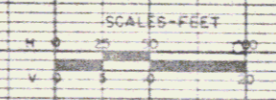


PLAN	NO. 1
DATE	
PROJECT	
BY	
CHECKED	
APPROVED	
SCALE	
DATE	

PROFILE	NO. 2
DATE	
PROJECT	
BY	
CHECKED	
APPROVED	
SCALE	
DATE	

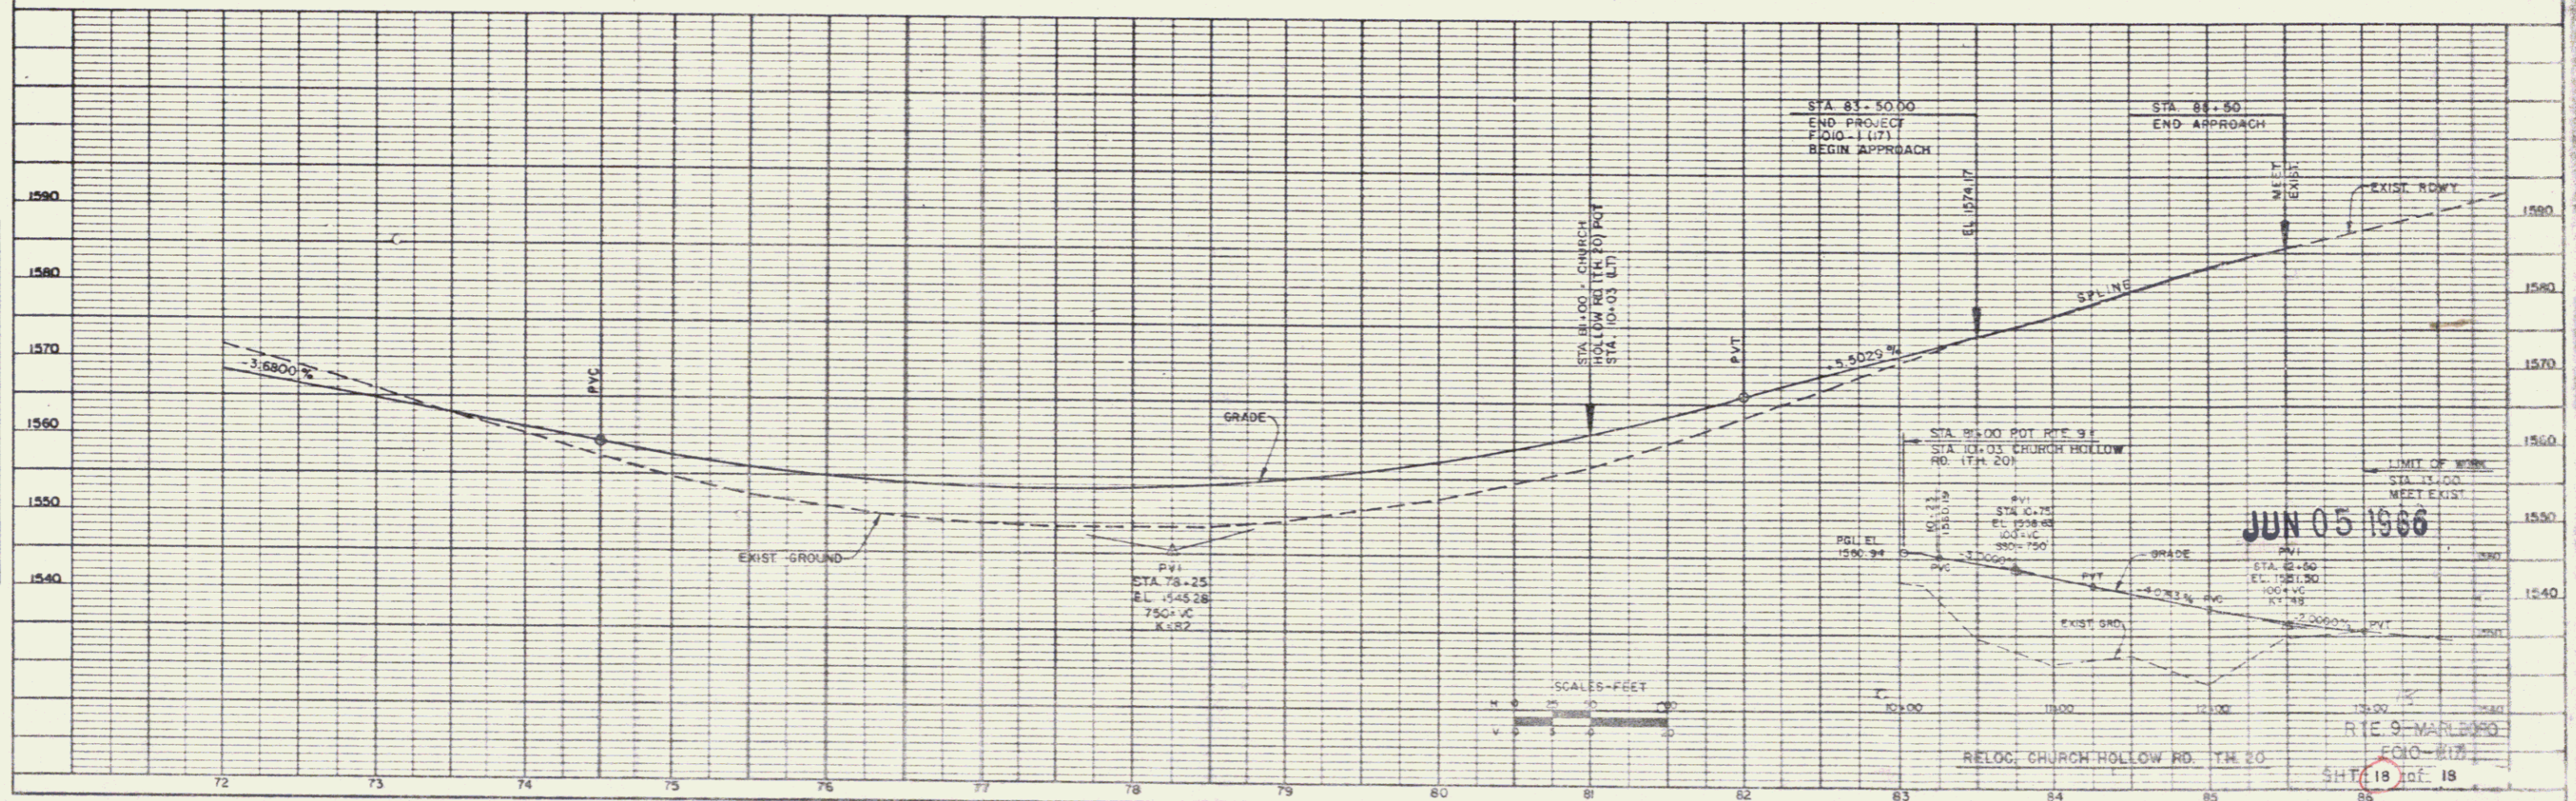

JUN 05 1966

RELOC. CHURCH HOLLOW RD. TH 20  
SHT. 18 of 18