

BEGIN MAINT. AGREE. AREA NO. 2
T.H. 12 0+20 @ (80)

END MAINT. AGREE. AREA NO. 2
BEGIN RELINQUISHMENT NO. VI
T.H. 12 1+00 @ (700)

BEGIN RELINQUISHMENT NO. IV
STA. 522+96 100' RT. (595)

BEGIN RELINQUISHMENT NO. V
T.H. 12 3+70 33' LT. (1022)

END RELINQUISHMENT NO. IV
T.H. 12 4+13 33' RT.

END RELINQUISHMENT NO. VI
T.H. 12 8+00 @


CONTRACT DRIVE
522+00 LT
TH 12 2+00 RT
6+30 RT
6+30 LT
522+30 RB

EXCAVATION AND REMOVAL OF
ROAD SURFACES AND PAVEMENTS
521+50 RT - T.H. 12 2+00 RT. (Good, per Item 1000)

Spilt Cedar Rail Fence
(Installation Only)
520+00 - 536+00 LT

GUARD RAIL & CABLE w/
LIGHT WOOD POSTS
531+00 RT - 536+00 RT

DATUM
VERTICAL
HORIZONTAL

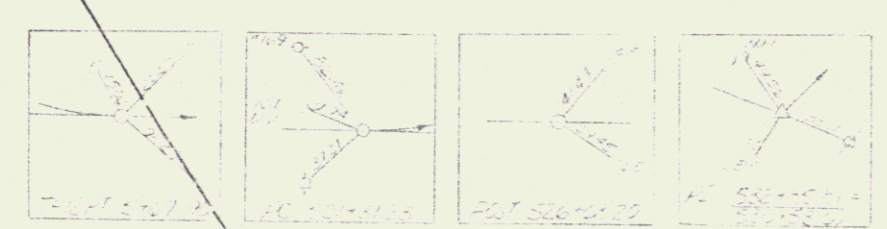

SURVEYED BY DATE
 DRAWN BY DATE
 TRACED BY DATE
 PROJ. NO.
 SHEET 14 OF 19