


CONSTRUCT DOWNS 479+00 TO 480+00
 SURFACE OF DRAIN 480+00 TO 481+00
 THREE CABLES AND ONE 481+00 TO 482+00
 TREATED TRUNK CABLE IN CLAW 482+00 TO 483+00
 LOCATION AND REMOVAL OF LOCAL BUREAU EQUIPMENTS 483+00 TO 484+00

FORB-1(1) 1960
 F123-A V4 1930

POOR ORIGINAL COPY

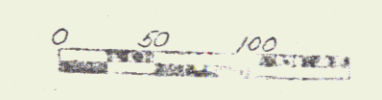

JUN 04 1985

VERMONT DEPARTMENT OF HIGHWAYS
 RIGHT-OF-WAY PLANS
 SHEET: SO. HERO
 PROJECT: FORB-1(1)
 DATE: 78