


POOR ORIGINAL COPY

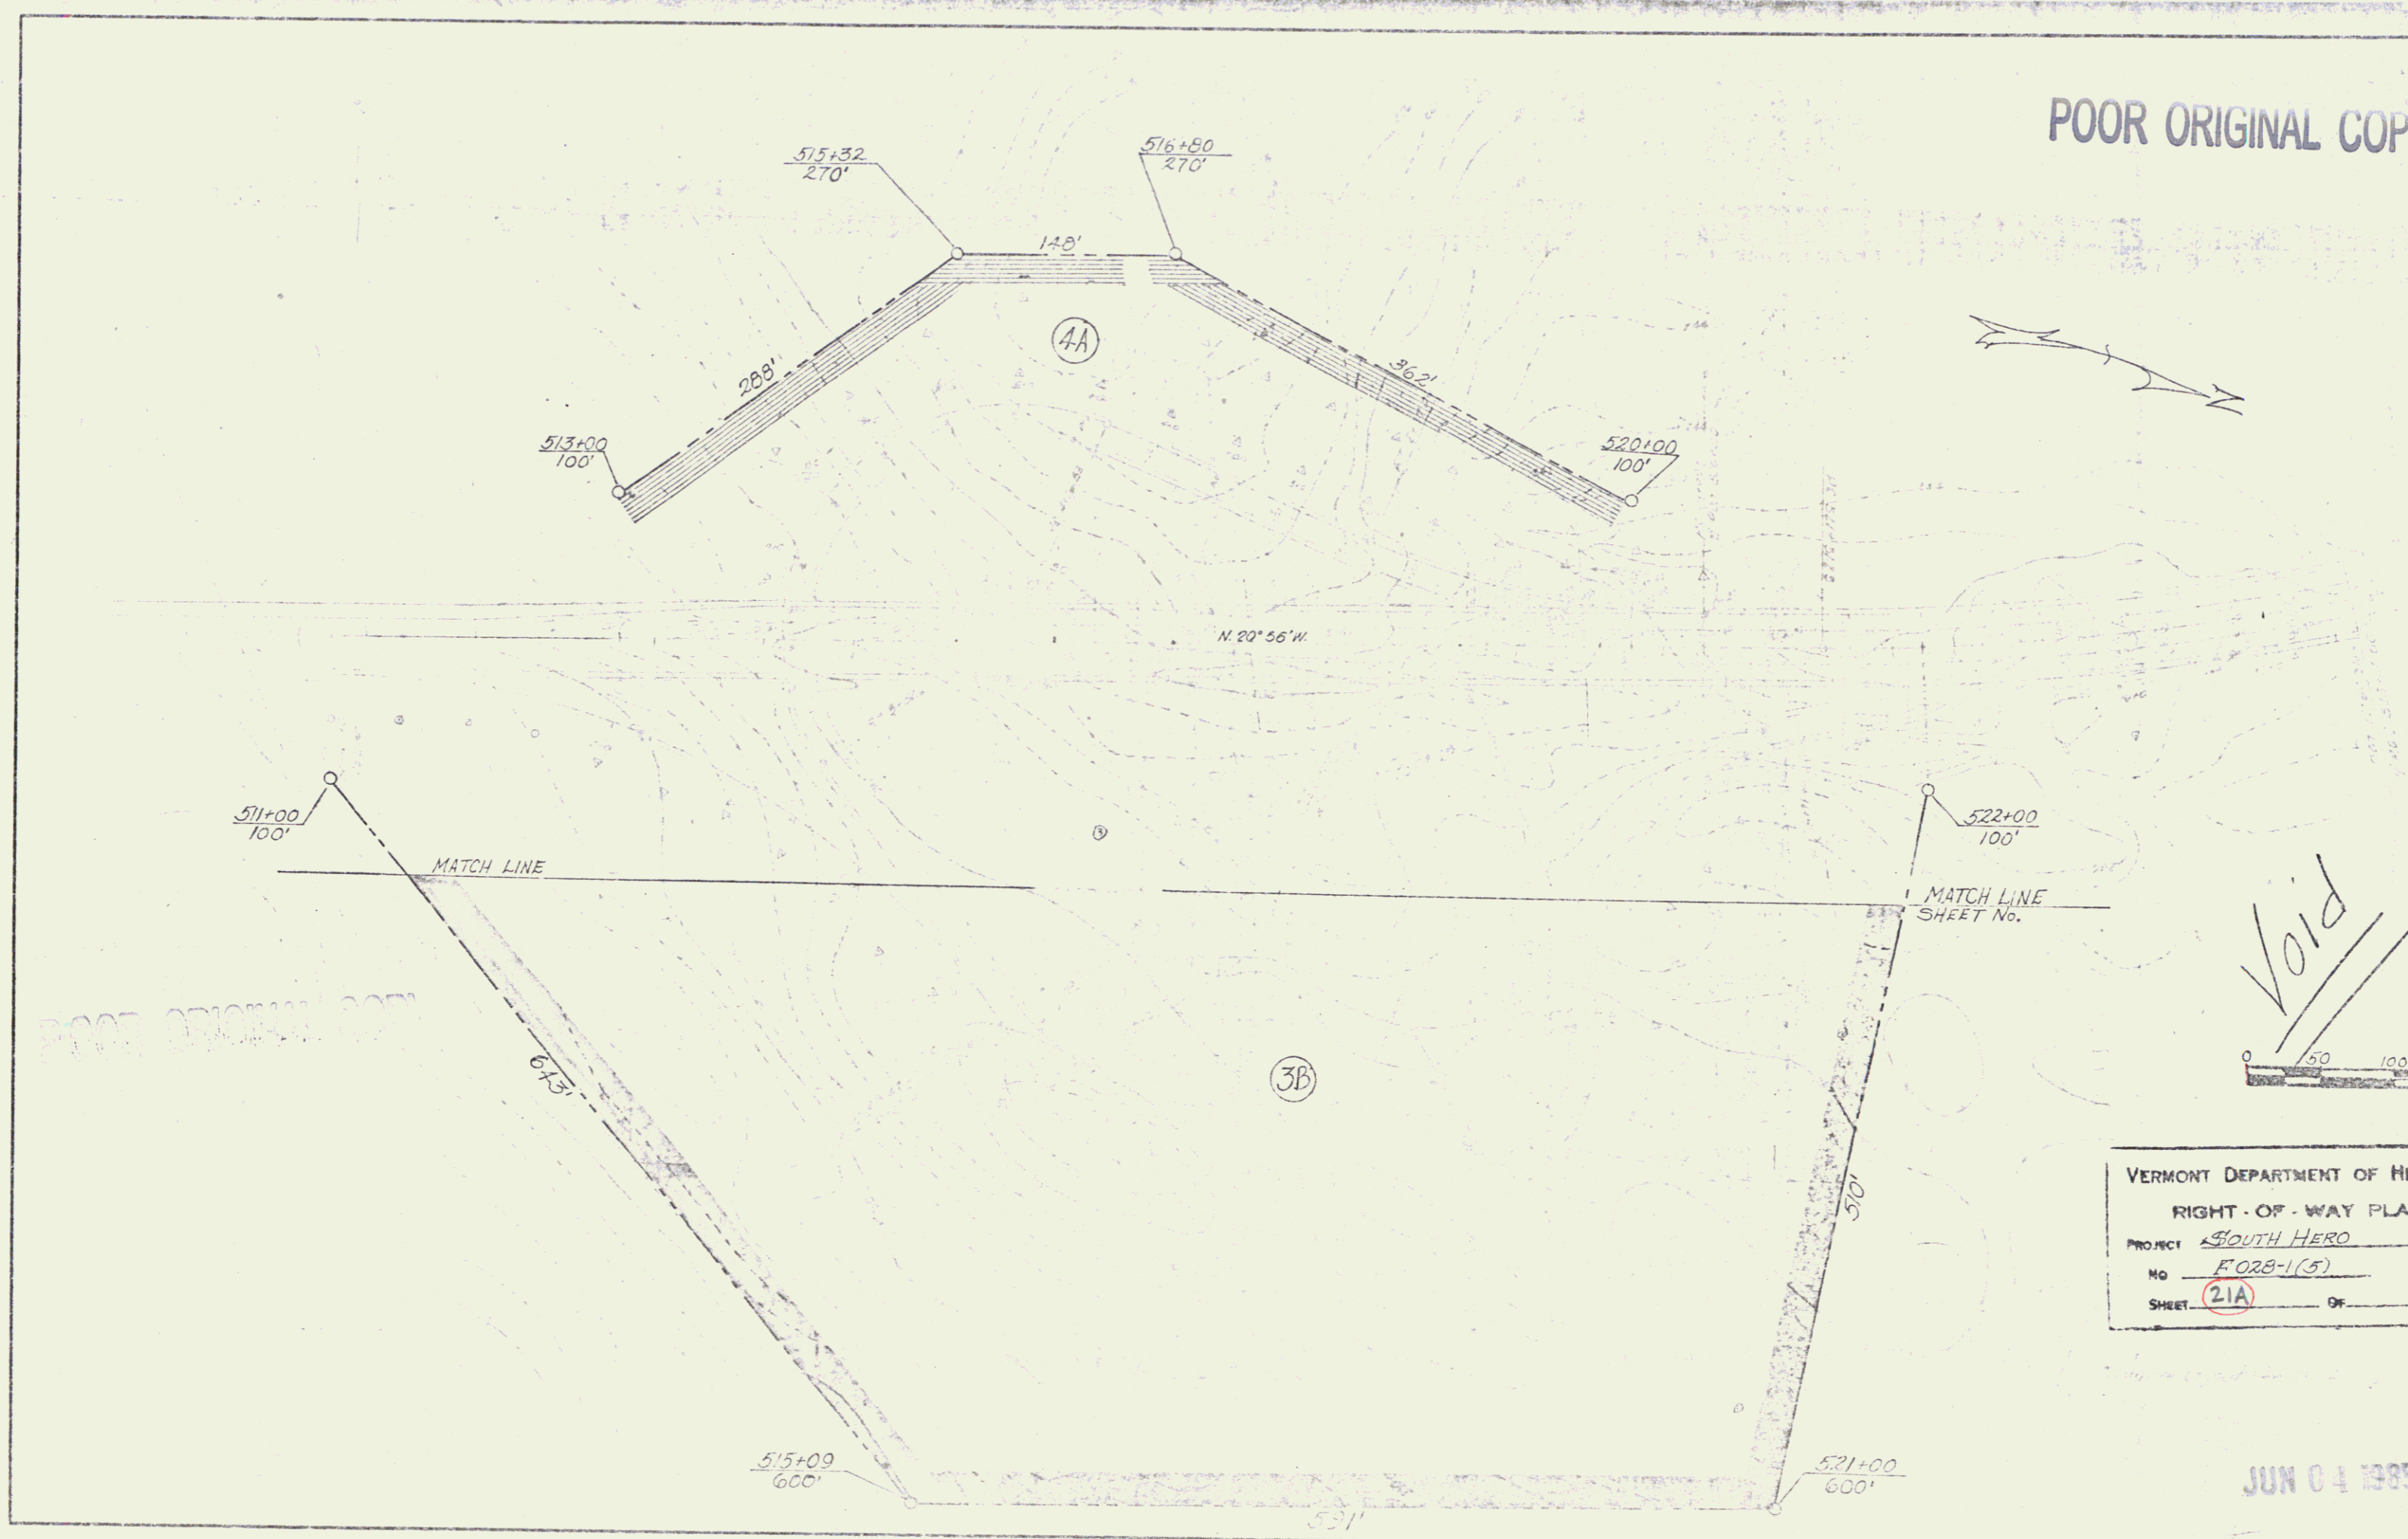

VERMONT DEPARTMENT OF HIGHWAYS
RIGHT-OF-WAY PLANS
PROJECT SOUTH HERO
NO F.028-1(5)
SHEET 21A OF _____

JUN 04 1985

37