


POOR ORIGINAL COPY

DRILLING & BURNING OF SOLID ROCK  
 1. 02' 00" DIA. DRILL  
 2. 20' 00" DIA. DRILL  
 3. 30' 00" DIA. DRILL  
 4. 40' 00" DIA. DRILL  
 100. 1000' 00" DIA. DRILL

JUN 04 1985

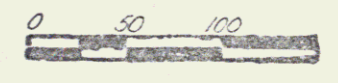

VERMONT DEPARTMENT OF HIGHWAYS  
 RIGHT-OF-WAY PLANS  
 PROJECT 50 Hwy  
 NO. E 028-115  
 SHEET 22 OF 32

38