

581+25
 TR#10 LT
 573+72 (COMM) LT
 575+31 (COMM) LT


581+41

02
 32
 59
 92
 96
 76
 94 0+63 R.H. T.H.#10

0+50 LI T.H.#10 - 580+12
 (30' E)

ITEM # 562 - Mod.
 568+00 - 578+00 EH
 579+40 - 581+00 EH
 579+50 - 581+00 LH
 579+78.5 LH

POOR ORIGINAL COPY

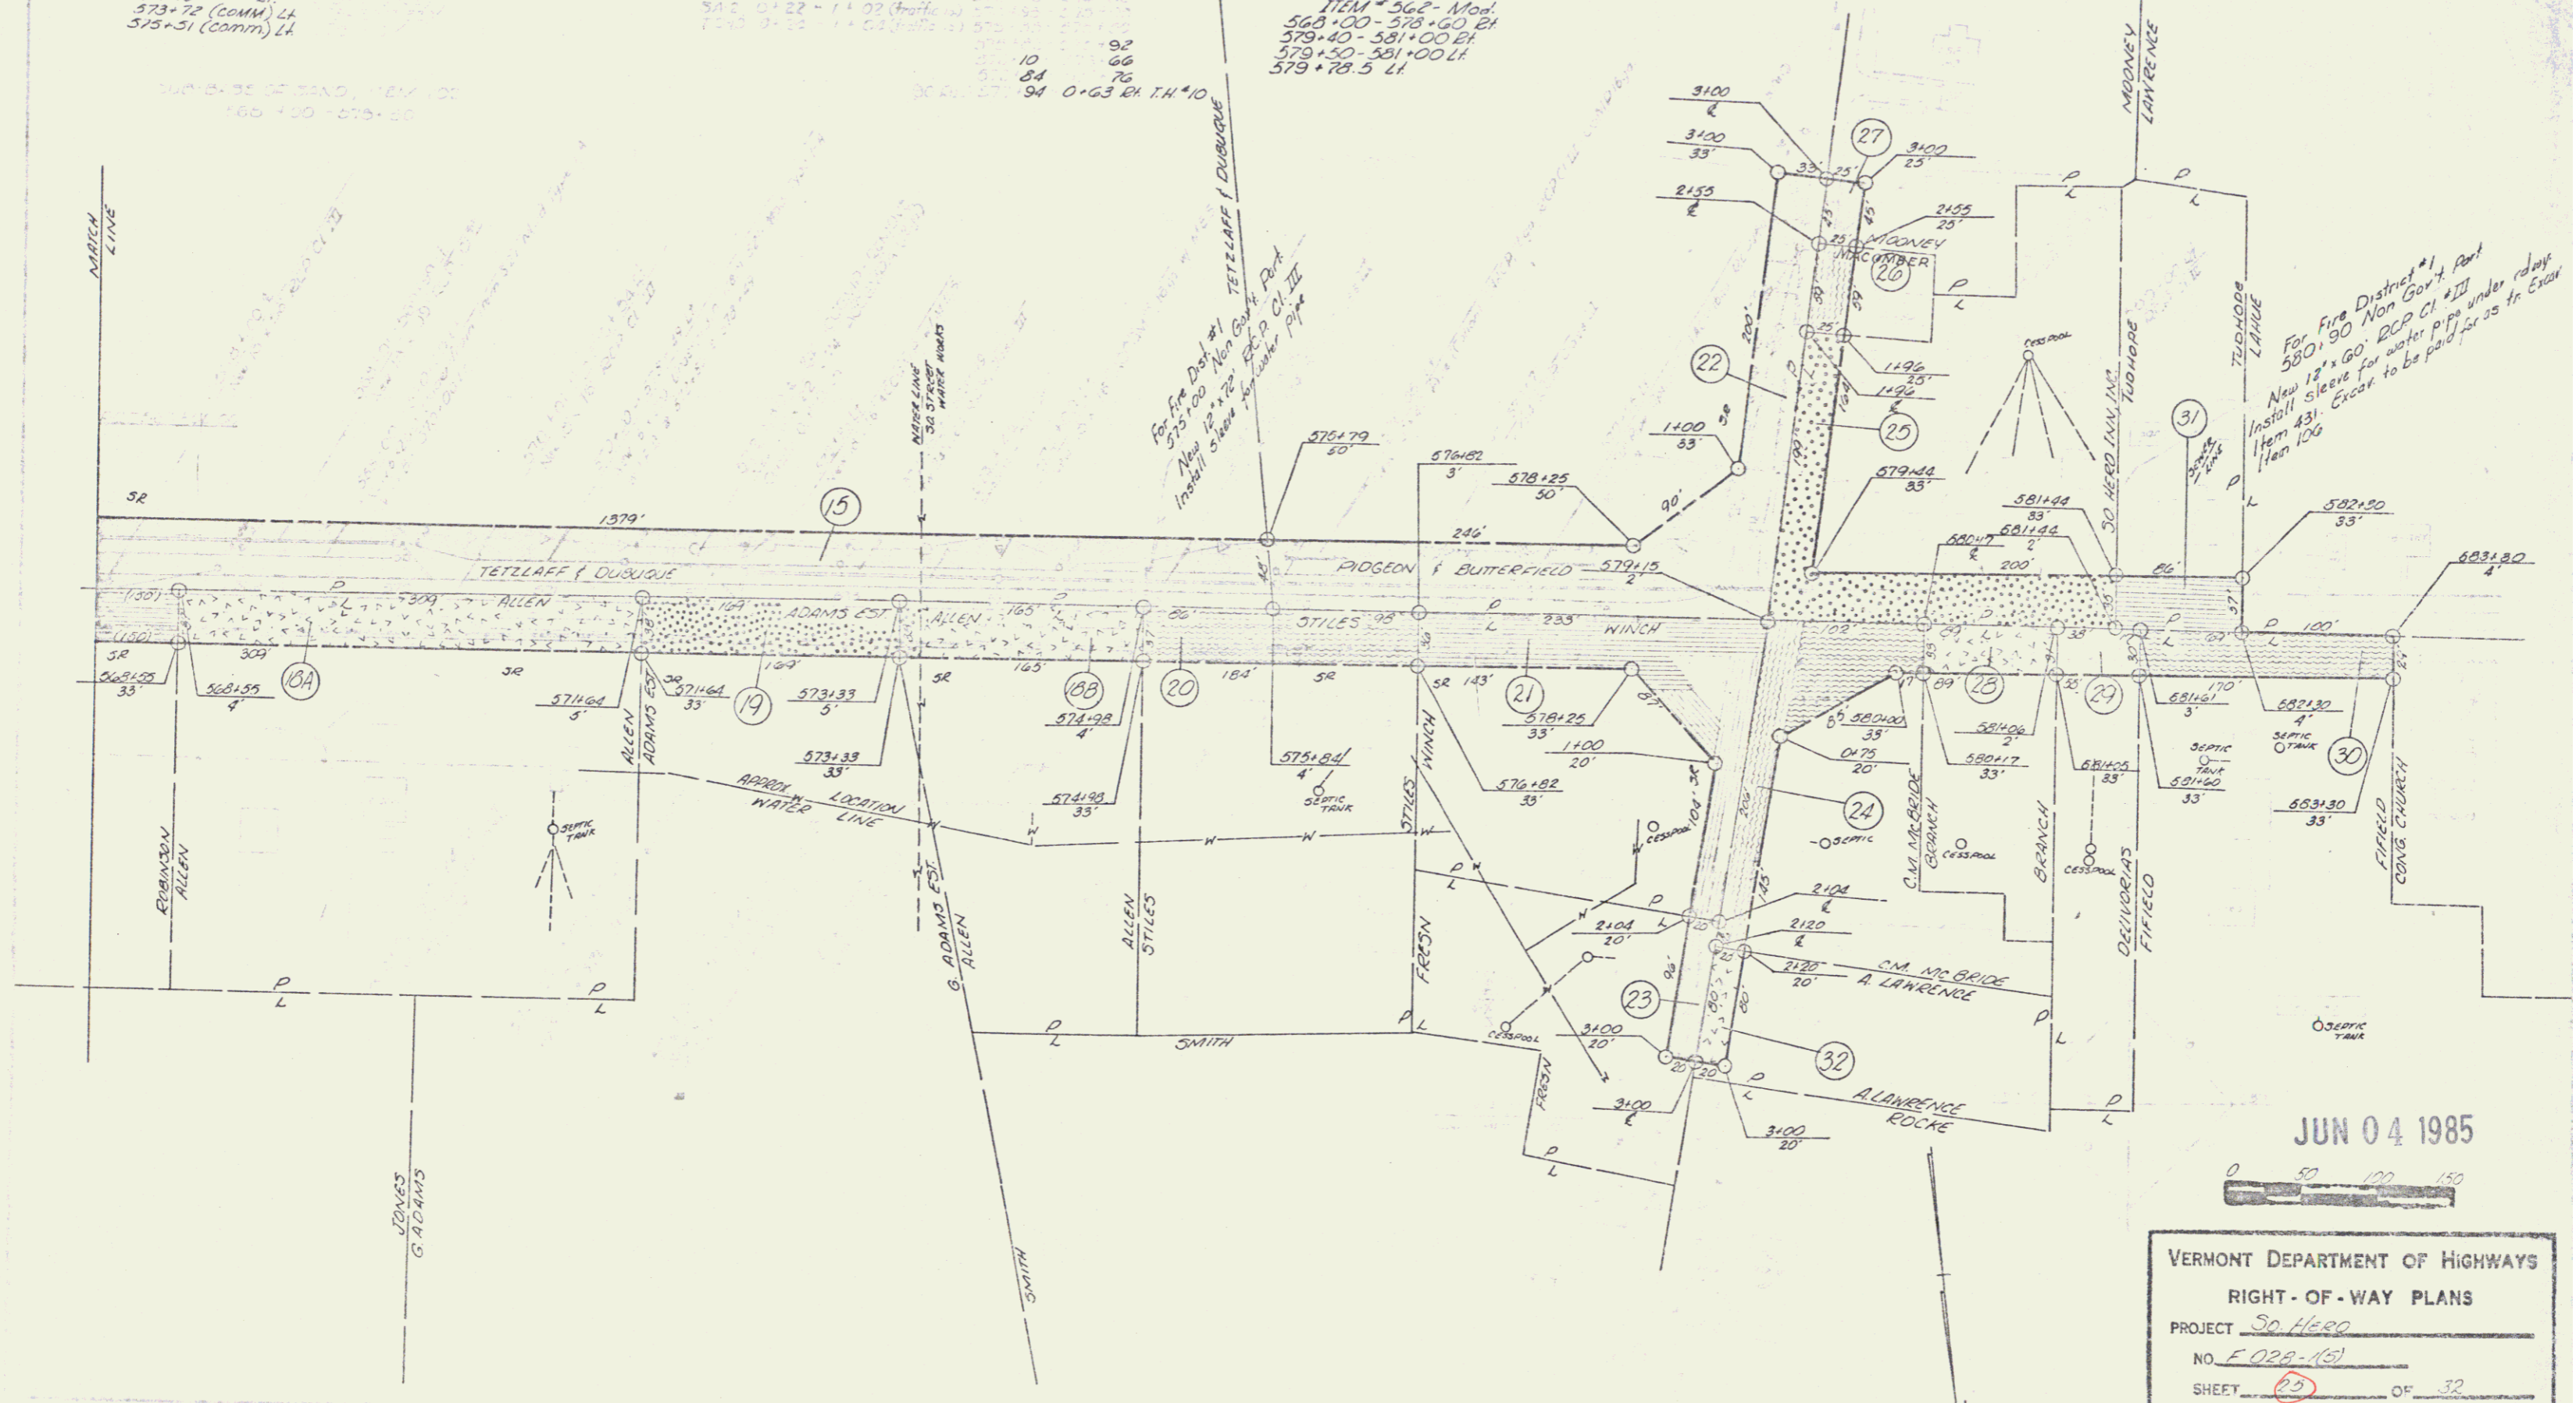

For Fire District #1
 580+90 Non Gov't. Rent
 New 12" x 60' RCP CI #III
 Install sleeve for water pipe under rdwy
 Item #31. Excise to be paid for 25 ft. Excise
 Item 106

JUN 04 1985

VERMONT DEPARTMENT OF HIGHWAYS
 RIGHT-OF-WAY PLANS
 PROJECT 50 H680
 NO. F 028-151
 SHEET 23 OF 32

42