
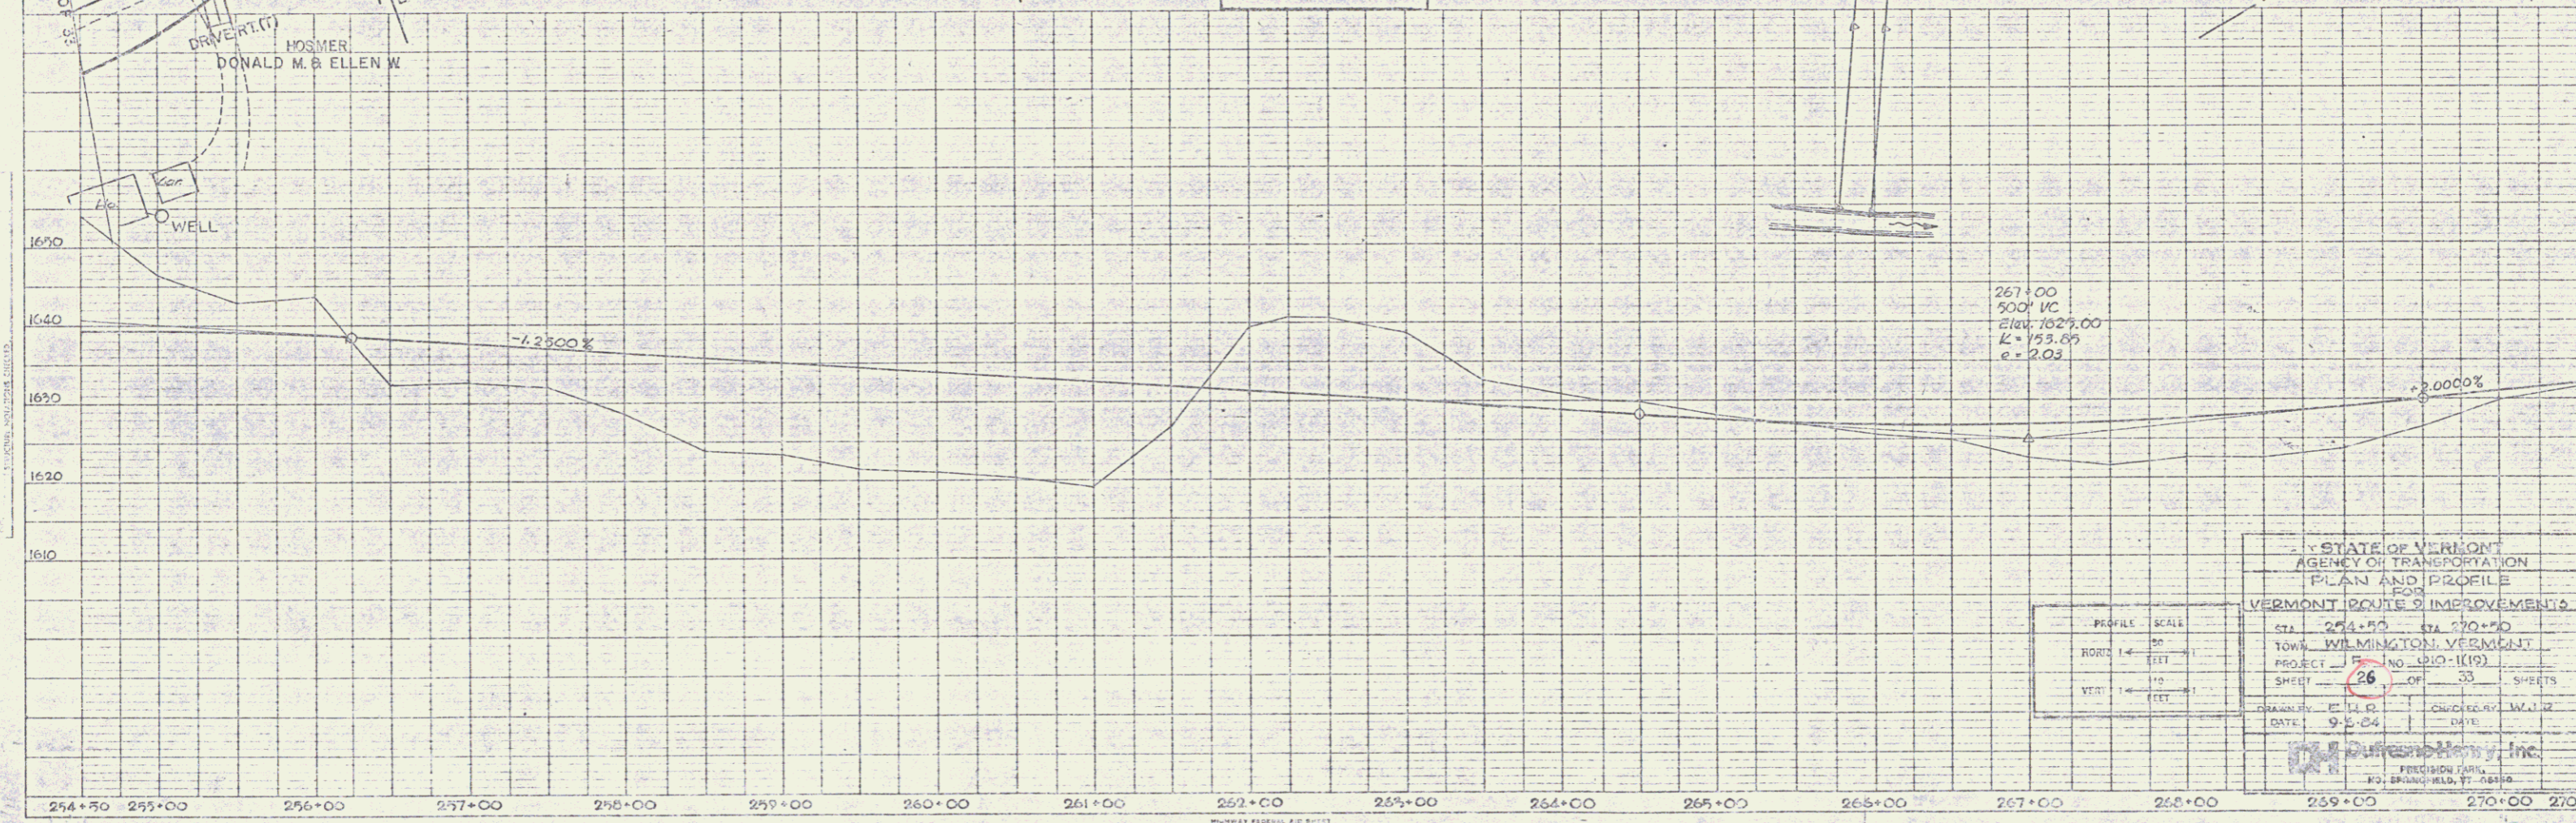
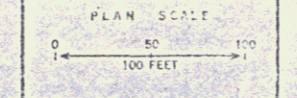


POOR ORIGINAL COPY

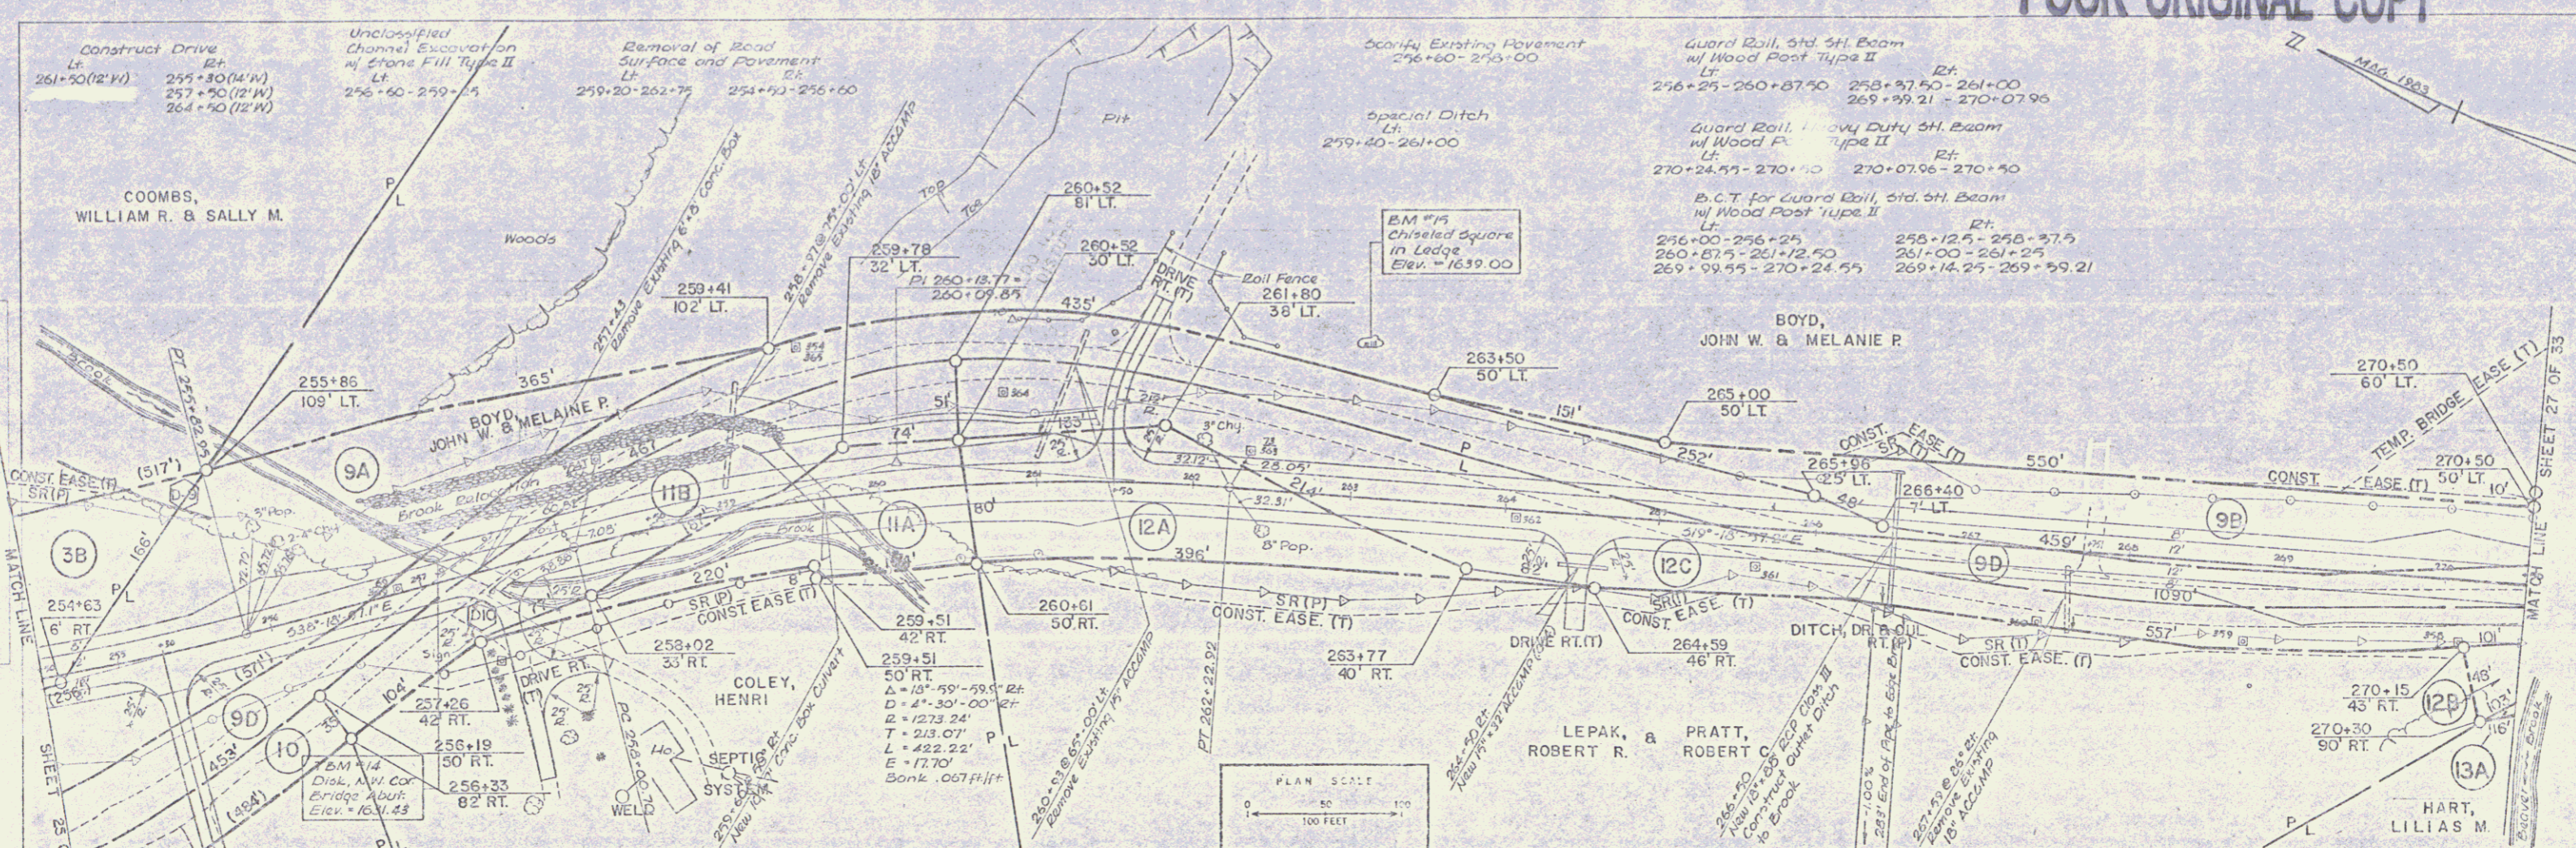

STATE OF VERMONT AGENCY OF TRANSPORTATION PLAN AND PROFILE FOR VERMONT ROUTE 9 IMPROVEMENTS	
STA 264+50	STA 270+50
TOWN WILMINGTON VERMONT	
PROJECT NO. 1010-1010	
SHEET 26	OF 33 SHEETS
DATE 9-5-04	DATE
FREDERICK J. HARRIS, INC. 10 SPRINGFIELD ST. CHESHIRE, VT 05759	