

TYPICAL SECTION - COLLECTOR/DISTRIBUTOR




MATERIAL ITEM	THICKNESS TOLERANCE
PAVEMENT COURSES (TOTAL DEPTH)	+/- 5 mm
BASE COURSES (TOTAL DEPTH)	+/- 15 mm
SUBBASE	+/- 30 mm
SAND BORROW	+/- 30 mm


- 130 mm SUPERPAVE BITUMINOUS CONCRETE PAVEMENT (50 mm TYPE IIS, 80 mm TYPE IIS)
- 100 mm BASE COURSE, SUPERPAVE BITUMINOUS CONCRETE PAVEMENT, TYPE IS
- 600 mm SUBBASE OF DENSE GRADED CRUSHED STONE
- 400 mm SAND BORROW
- SHOULDERS: 130 mm BITUMINOUS CONCRETE PAVEMENT (50 mm TYPE IIS, 80 mm TYPE IIS)

NOTE:
D) DESIGN FROST DEPTH - 1230 MM

- NOTES:
- ELIMINATE TOPSOIL AND SEEDING BEHIND GUARD RAIL TO SUBGRADE CATCH POINT.
 - FOR SLOPES IN SOLID ROCK EXCAVATION AND DRILLING AND BLASTING OF SOLID ROCK SUBGRADE, SEE STD. SHEET A-60M AND A-62M AND DETAILS.
 - REFER TO TYPICAL SECTION SHEET, TS-15 FOR SEEDING FORMULA AND ADDITIONAL GENERAL NOTES AND PARABOLIC DETAIL.
 - SEE BANKING DIAGRAM ON PROFILES FOR CROSS SLOPE

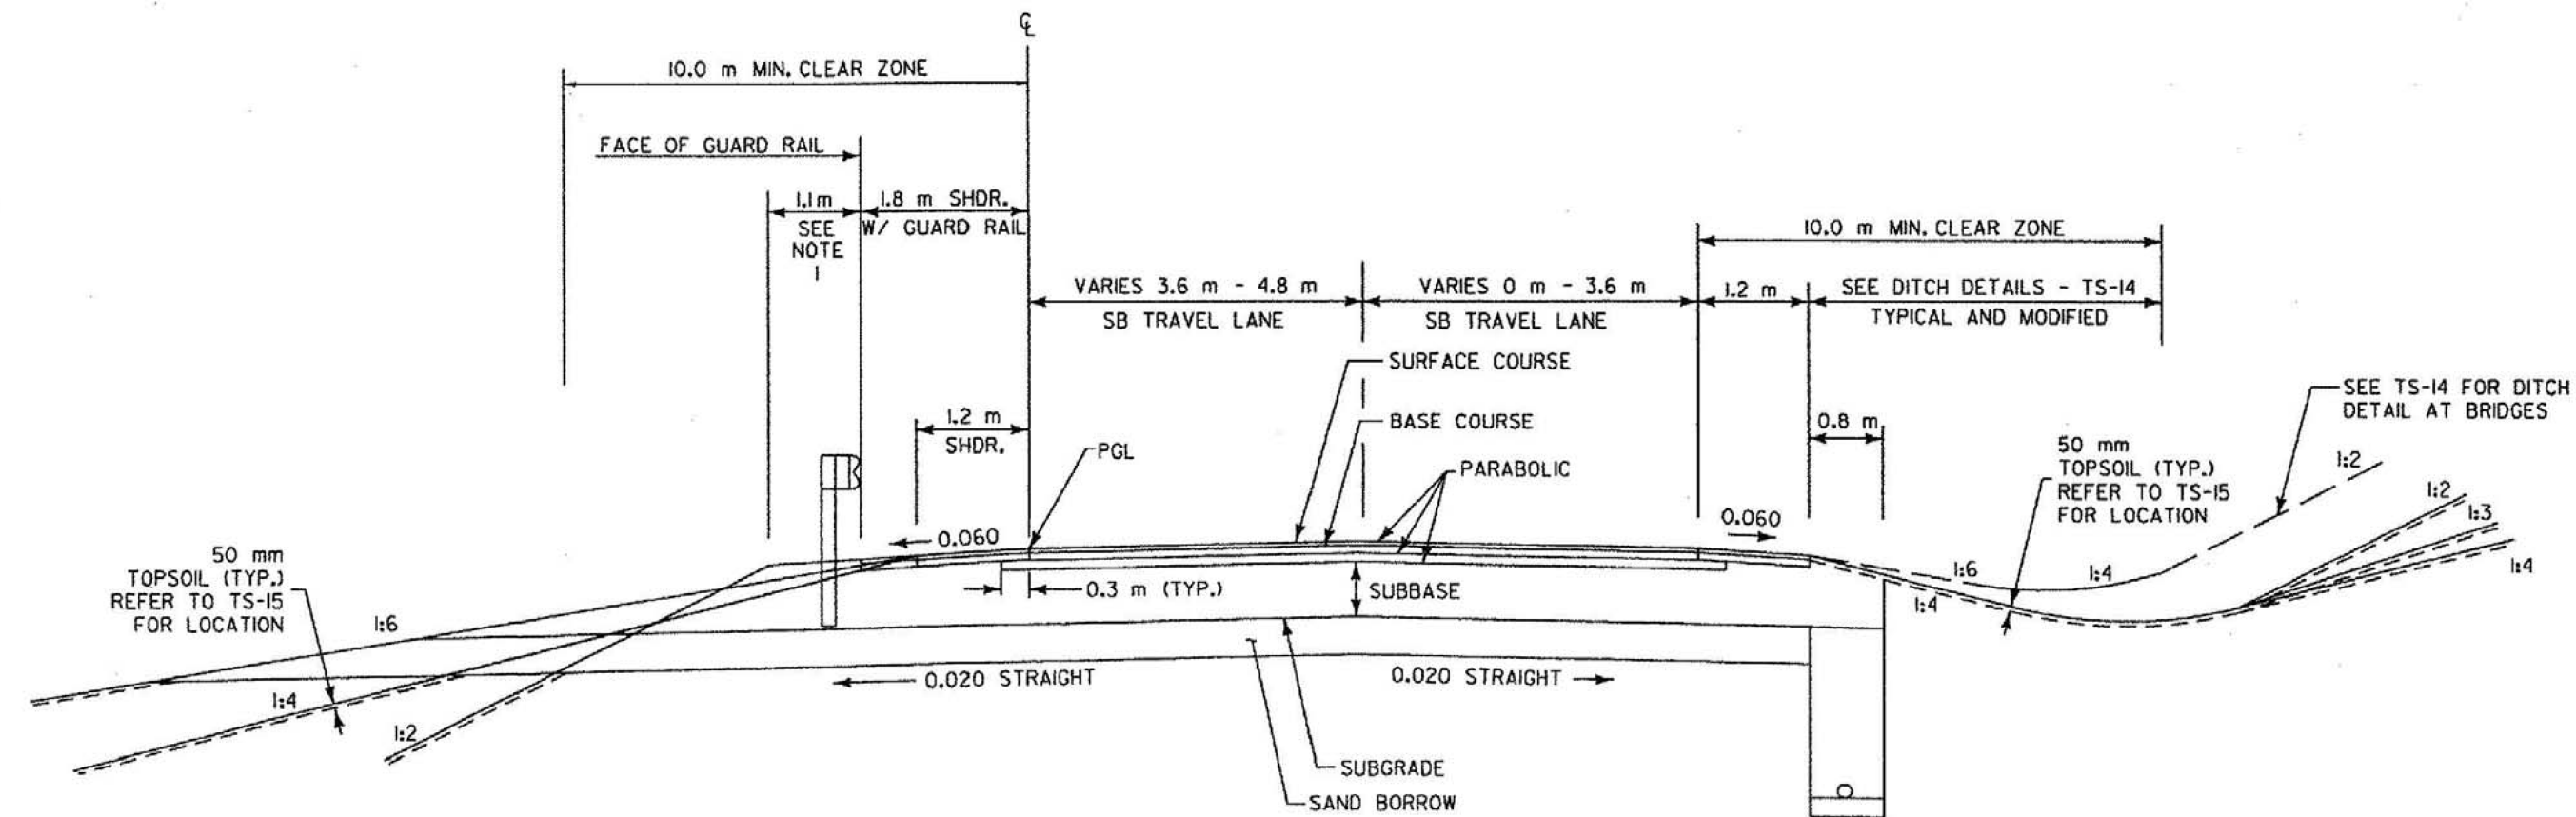

NORMAL SECTION

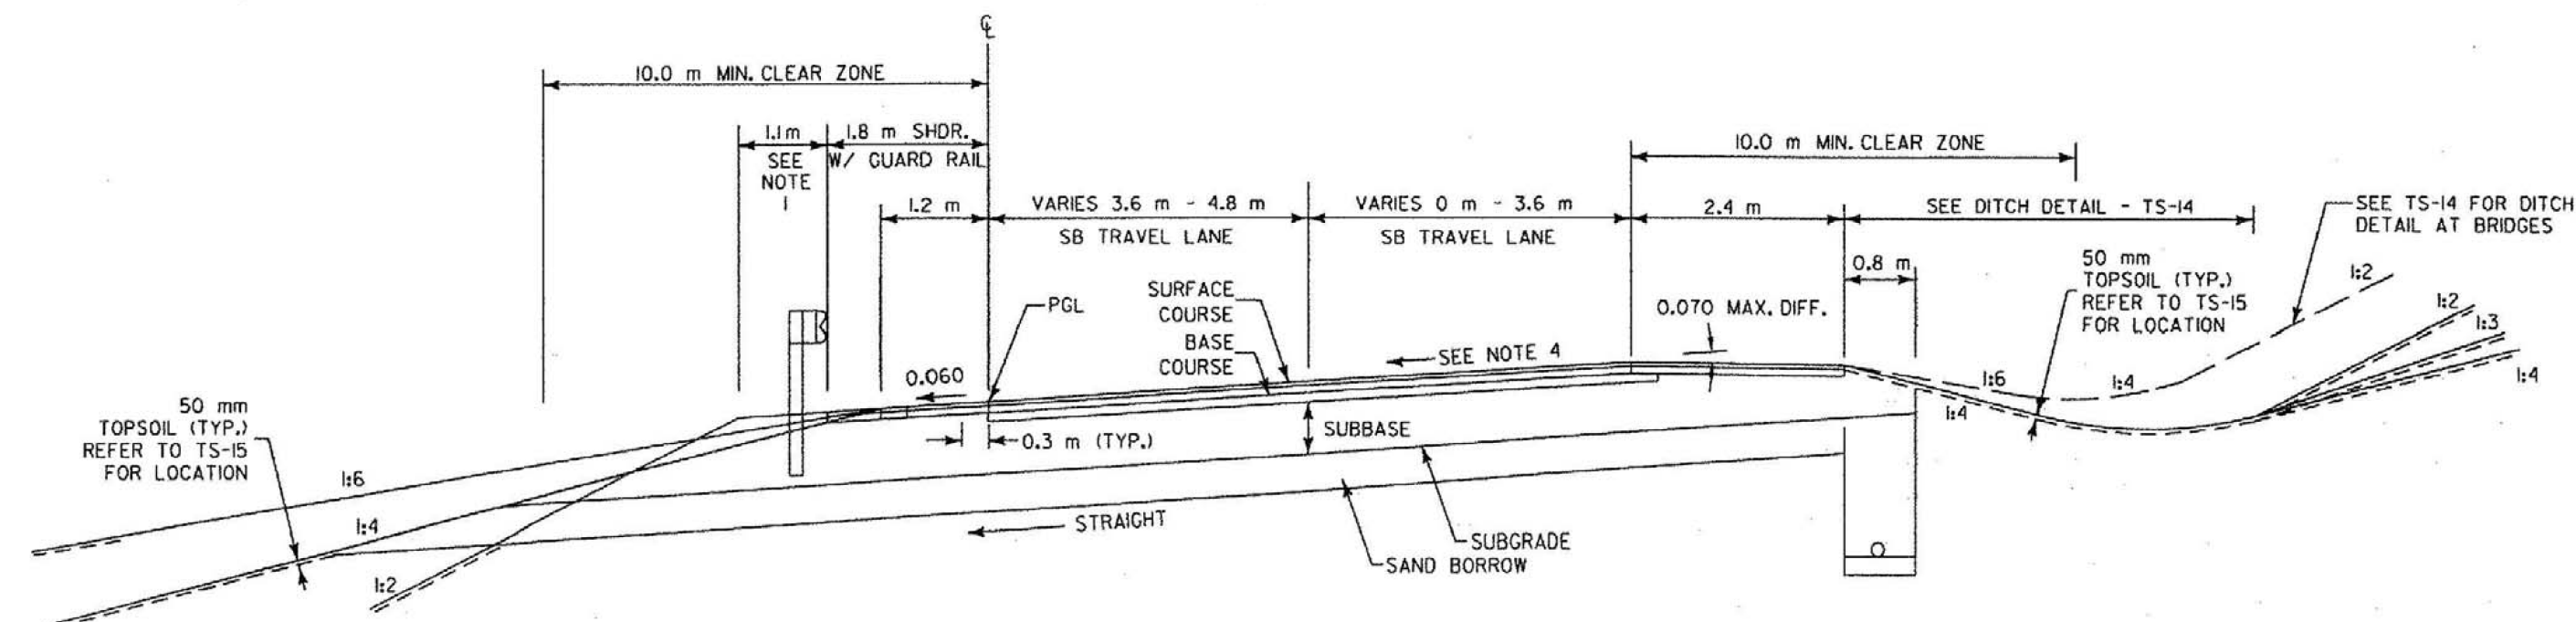

BANKED SECTION
SLOPE VARIES, SEE BANKING DIAGRAM ON PROFILE SHEETS.

VERMONT AGENCY OF TRANSPORTATION



PROJECT NAME: BENNINGTON
PROJECT NUMBER: NH F019-1(5) **REVISED**

FILE NAME: ...Highway\PlotFiles\typicals.prf PLOT DATE: 11/20/2004
DESIGN SUPERVISOR: GREG EDWARDS DRAWN BY: DUFRESNE-HENRY
DESIGNED BY: MARC FOISY CHECKED BY: GARY SANTY
TYPICAL TS-09 SHEET 12 OF 112

PGL = PROFILE GRADE LINE

K:\030020 - Bennington\030020\PlotFiles\Typical\Typical.dwg