



CURVE CH1
 PI STA. CH 1-348.535
 DELTA = 13°20'29.3"
 R = 315.411 m
 T = 36.889 m
 L = 73.444 m
 E = 2.150 m
 BANK = 0.044

CURVE NB7
 PI STA. NB 8-360.674
 DELTA = 90°45'02.2"
 R = 575.000 m
 T = 582.583 m
 L = 910.741 m
 E = 243.552 m
 BANK = 0.078

X - RADIAL DIMENSIONS
PLAN
 0 10 20 m
 SCALE 1:250

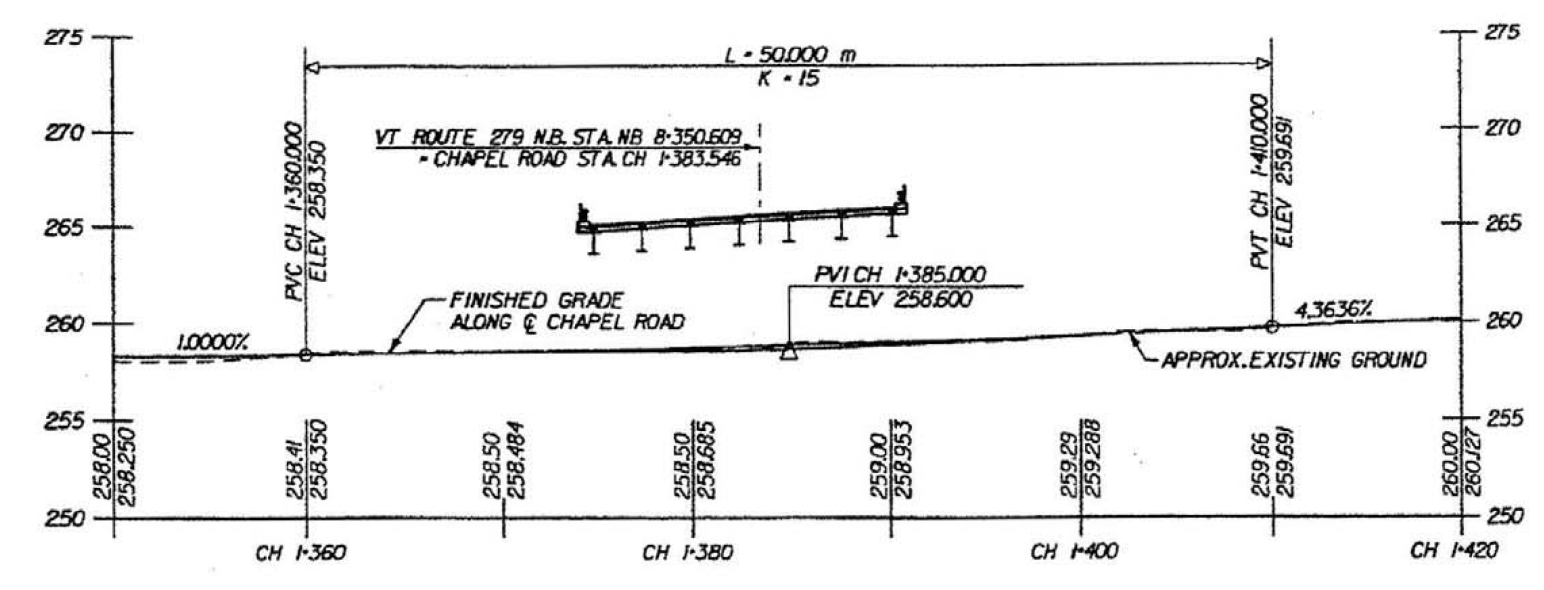

CHAPEL ROAD PROFILE
 0 10 20 m
 SCALE 1:250

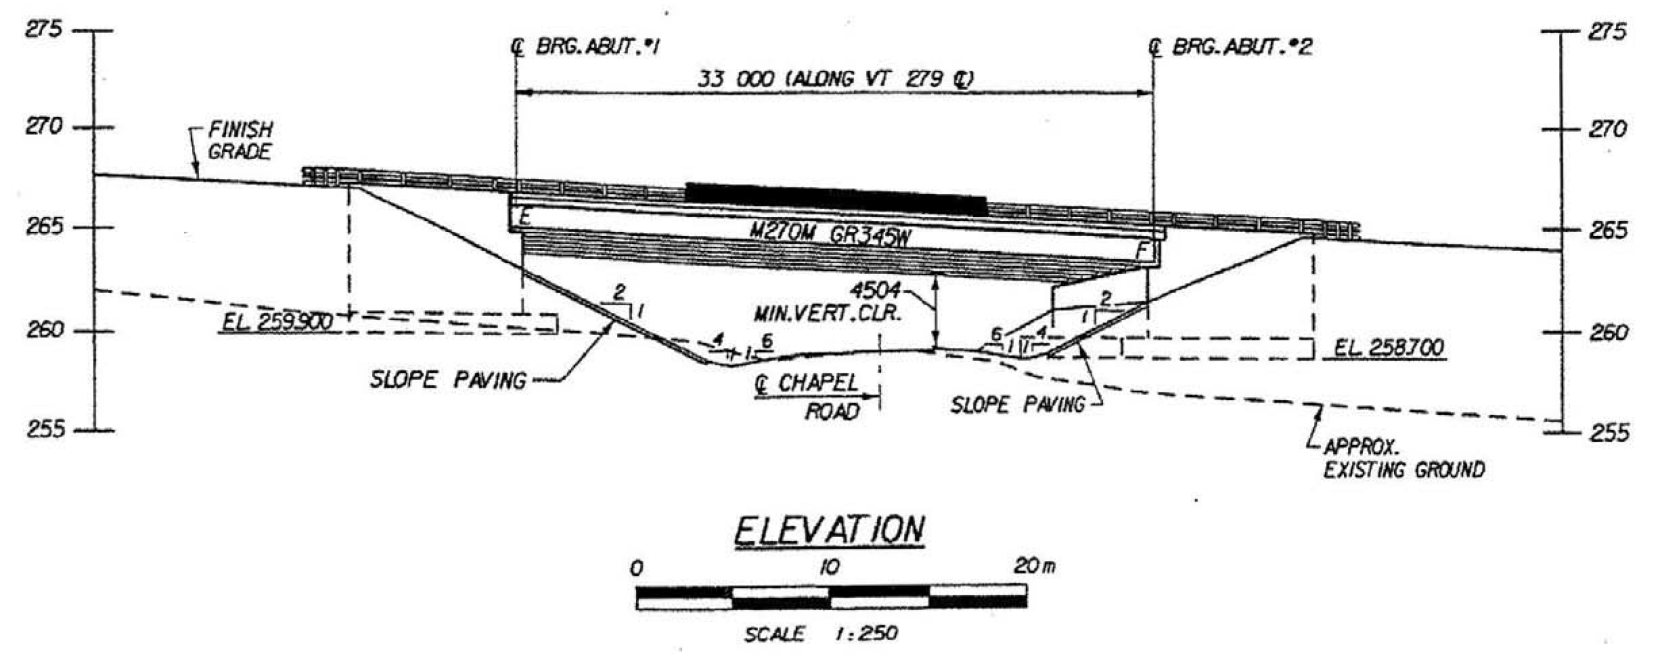

ELEVATION
 0 10 20 m
 SCALE 1:250

REVISED

**STATE OF VERMONT
 AGENCY OF TRANSPORTATION**

Town Of	BENNINGTON	Bridge No.	
Highway No.		Log Sta.	
		Surv. Sta.	
VT ROUTE 279 OVER CHAPEL ROAD			
PLAN AND ELEVATION			
Designed By	T. KNIGHT	Drawn By	T. KNIGHT
Checked By	M. CHENETTE	Bridge Design Supervisor	G. BOGUE
	11/04	Date	
PROJECT	BENNINGTON	PROJECT NO.	NH F019-1(5)
DH CAD Drawing Name: ... \PlotFiles\CH\CH-PR10 Date: 11/17/2004			
Bridge Sheet No. BR401		Sheet 25 of 112	

