


K:\ASB0200 (Barrow)\Highways\North\Asv\Drawings\mp002517



NOTE: FINISH GRADE SHOWN IS FOR FUTURE BUILD III. THIS PROJECT WILL BUILD TO SUBGRADE TO STATION NB 6+574.000

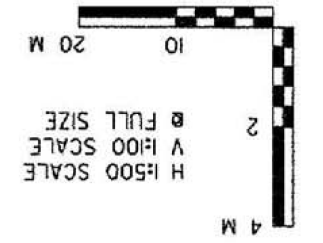

VERMONT AGENCY OF TRANSPORTATION  
 PROJECT NAME: BENNINGTON  
 PROJECT NUMBER: NH F019-(K5)  
 FILE NAME: ... \mp002517.dwg  
 DESIGN SUPERVISOR: GREG EDWARDS  
 DESIGNED BY: BJM/MARC FOISY  
 DRAWN BY: DUFRESNE-HENRY  
 CHECKED BY: GARY SANTY  
 PLOT DATE: 05/27/2003  
 SHEET 32 OF 112  
 NORTHBOUND - PR-3

