


+0.080
+0.060
+0.040
+0.020
LEVEL
-0.020
-0.040
-0.060
-0.080

K:\18\180200_Bennington\Profile\ProfileRampK.plt

VERMONT AGENCY OF TRANSPORTATION

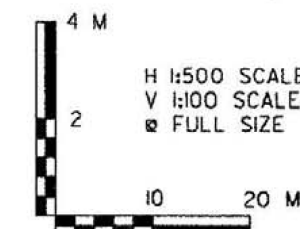

PROJECT NAME: BENNINGTON
PROJECT NUMBER: NH F019-K(5)

FILE NAME: ... \RompK.plt
DESIGN SUPERVISOR: GREG EDWARDS
DESIGNED BY: BJM/MARC FOISY

PLOT DATE: 05/27/2003
DRAWN BY: DUFRESNE-HENRY
CHECKED BY: GARY SANTY

RAMP K - PR-46

SHEET 43 OF 112