


REVISED CURVE DATA  
 Δ 7°15' RT.  
 D 2°00'  
 R 2864.79'  
 T 181.49'  
 L 362.50'  
 E 5.74'

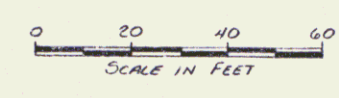

SURVEYED BY \_\_\_\_\_ DATE \_\_\_\_\_  
 DRAWN BY B.E.B. DATE 7-78  
 TRACED BY B.E.B. DATE 7-78  
 BERLIN TRUCK ESCAPE RAMP  
 PROJ. HHS NO. 0203(5)  
 SHEET 8 OF 41  
 D-7

5