


T.H. 7&9 TYPICAL SECTIONS

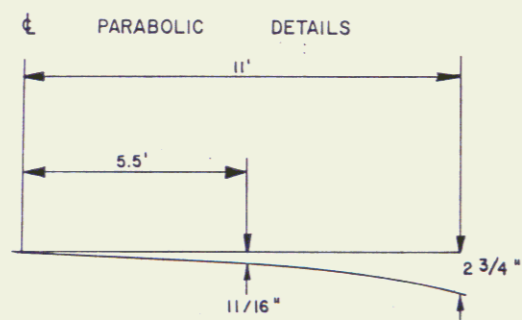

- 1 1/4" ($\pm 1/4$ ") BITUMINOUS CONCRETE PAVEMENT ITEM 406.25 TYPE III
 - 1 3/4" ($\pm 1/4$ ") BITUMINOUS CONCRETE PAVEMENT ITEM 406.25 TYPE II
 - 3" ($\pm 1/2$ ") PLANT MIXED BASE COURSE ITEM 303.25
 - 24" (± 1 ") SUBBASE OF DENSE GRADED CRUSHED STONE ITEM 301.35
 - SHOULDERS: 1 1/4" ($\pm 1/4$ ") BITUMINOUS CONCRETE PAVEMENT ITEM 406.25 TYPE III
 - 0-24" (± 1 ") SAND BORROW ITEM 203.31 (IN CUT)
 - 0-12" (± 1 ") GRANULAR BORROW ITEM 203.32 (IN FILL)
- } TO BE PLACED AS SHOWN ON PLANS
OR AS DIRECTED BY THE ENGINEER

SEEDING FORMULA, ITEM 651.10
RURAL AREAS


% WT	LBS./A	NAME	PUR %	GERM %
3.33	2	CROWN VETCH	97	75
50.00	30	CREeping RED FESCUE	98	85
8.33	5	TIMOTHY	99	85
16.67	10	PERENNIAL RYE GRASS (VAR. PENNFINE)	95	85
8.34	5	ALFALFA (VAR. SARANAC)	99	85
8.33	5	BIRDFOOT TREFOIL (VAR. EMPIRE)	98	85
5.00	3	HIGHLAND BENT GRASS	92	85
100.00	60			

THE SEED MIXTURE SHALL NOT HAVE A WEED CONTENT EXCEEDING 0.40% BY WEIGHT AND SHALL BE FREE FROM ALL NOXIOUS WEED SEED.
HAY MULCH, ITEM 651.25, TO BE PLACED ON ALL EARTH SLOPES AT THE RATE OF TWO TONS PER ACRE.


FERTILIZER, ITEM 651.15, SHALL BE MIXED AS FOLLOWS:

NITROGEN	PHOSPHORUS	POTASH
10%	20%	10%

FERTILIZER SHALL BE DELIVERED IN BAGS OF NOT TO EXCEED 100 LBS. EACH AND IS TO BE APPLIED AT THE RATE OF 500 LBS. PER ACRE.
AGRICULTURAL LIMESTONE, ITEM 651.20, TO BE APPLIED TO ALL EARTH SLOPES AT THE RATE OF TWO TONS PER ACRE OR AS DIRECTED BY THE ENGINEER.
WOOD MARKER POSTS, ITEM 619.15, TO BE PLACED AS DIRECTED BY THE ENGINEER FOR ROUNDING OF SLOPES, SEE STANDARD SHEET B-5.

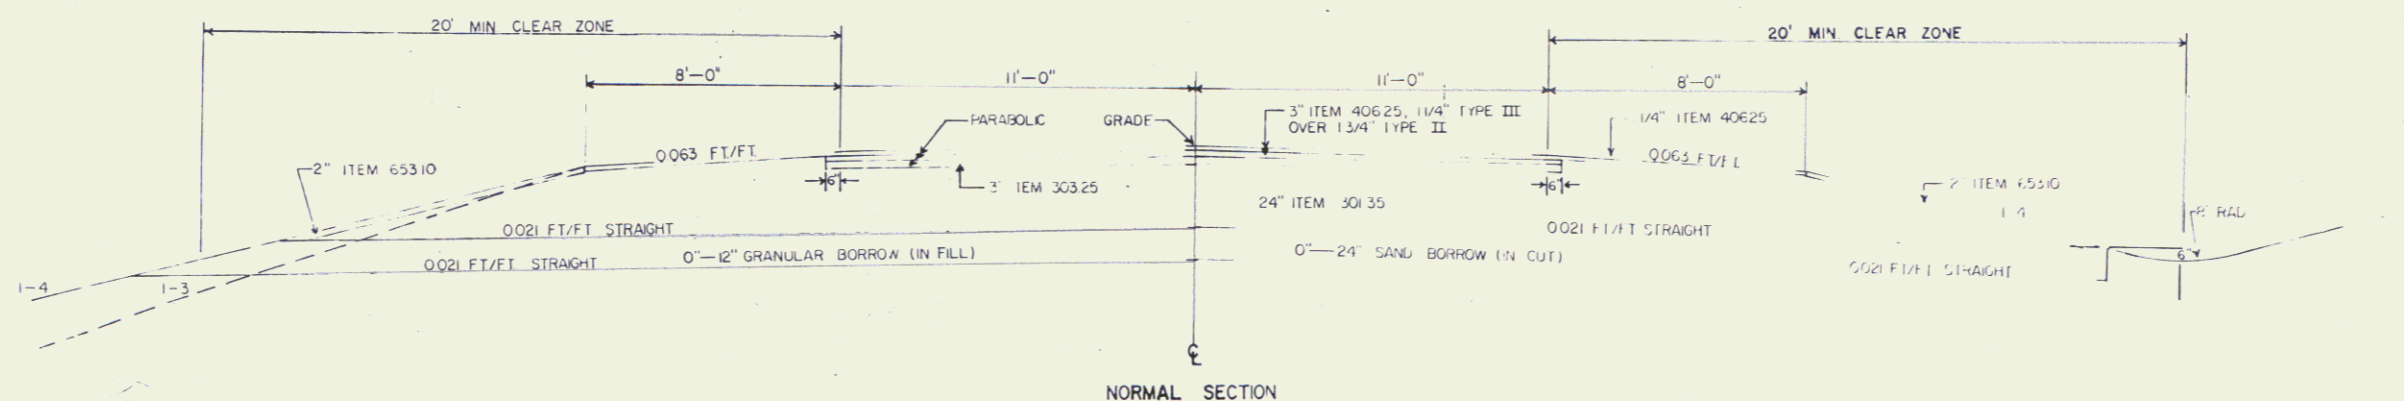

NORMAL SECTION

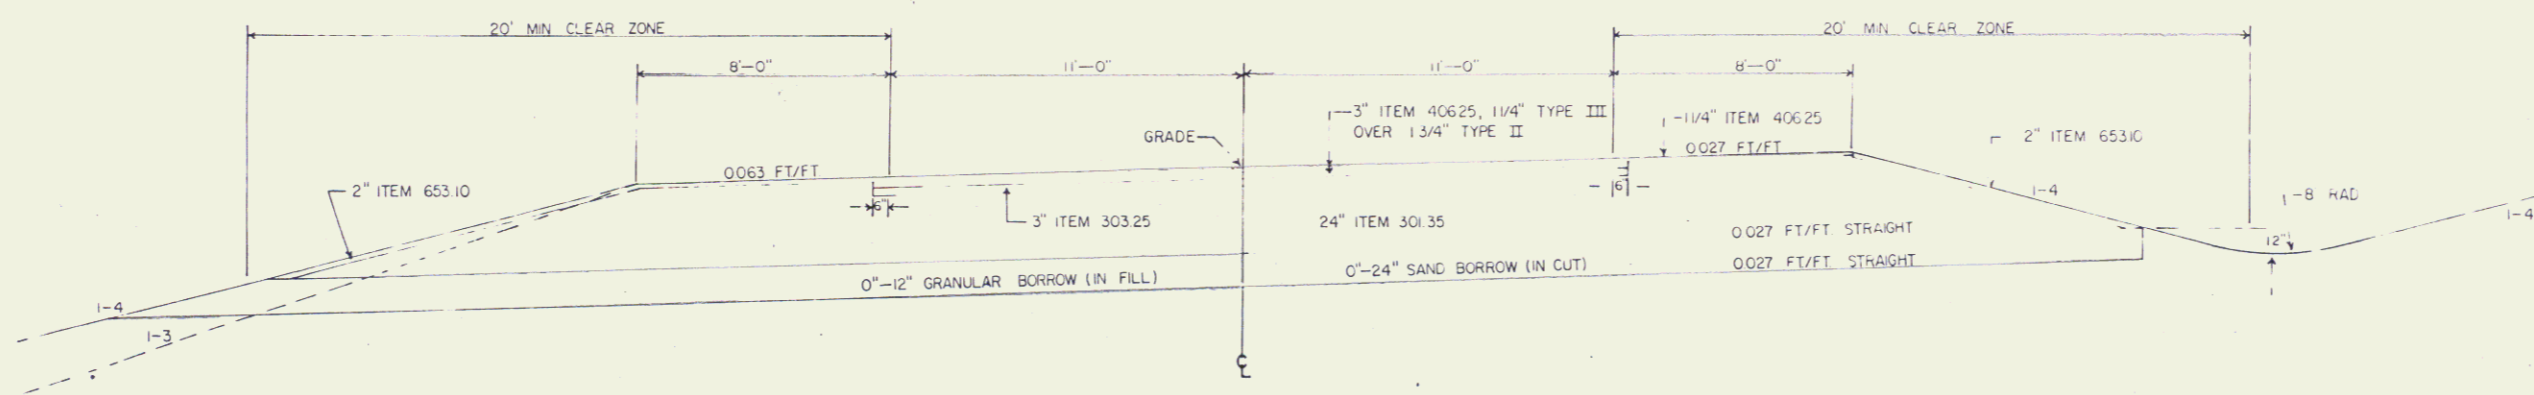

MAXIMUM BANKED SECTION 0.027 FT./FT.

JUL 16 1997

COLCHESTER
RS 0285 (5)
SHEET 2 OF 8 SHEETS