

PLAN

DATE: _____

PROJECT: _____

NOTE BOOK: _____

NO. OF PAGES: _____


PROFILE

DATE: _____

PROJECT: _____

NOTE BOOK: _____

NO. OF PAGES: _____

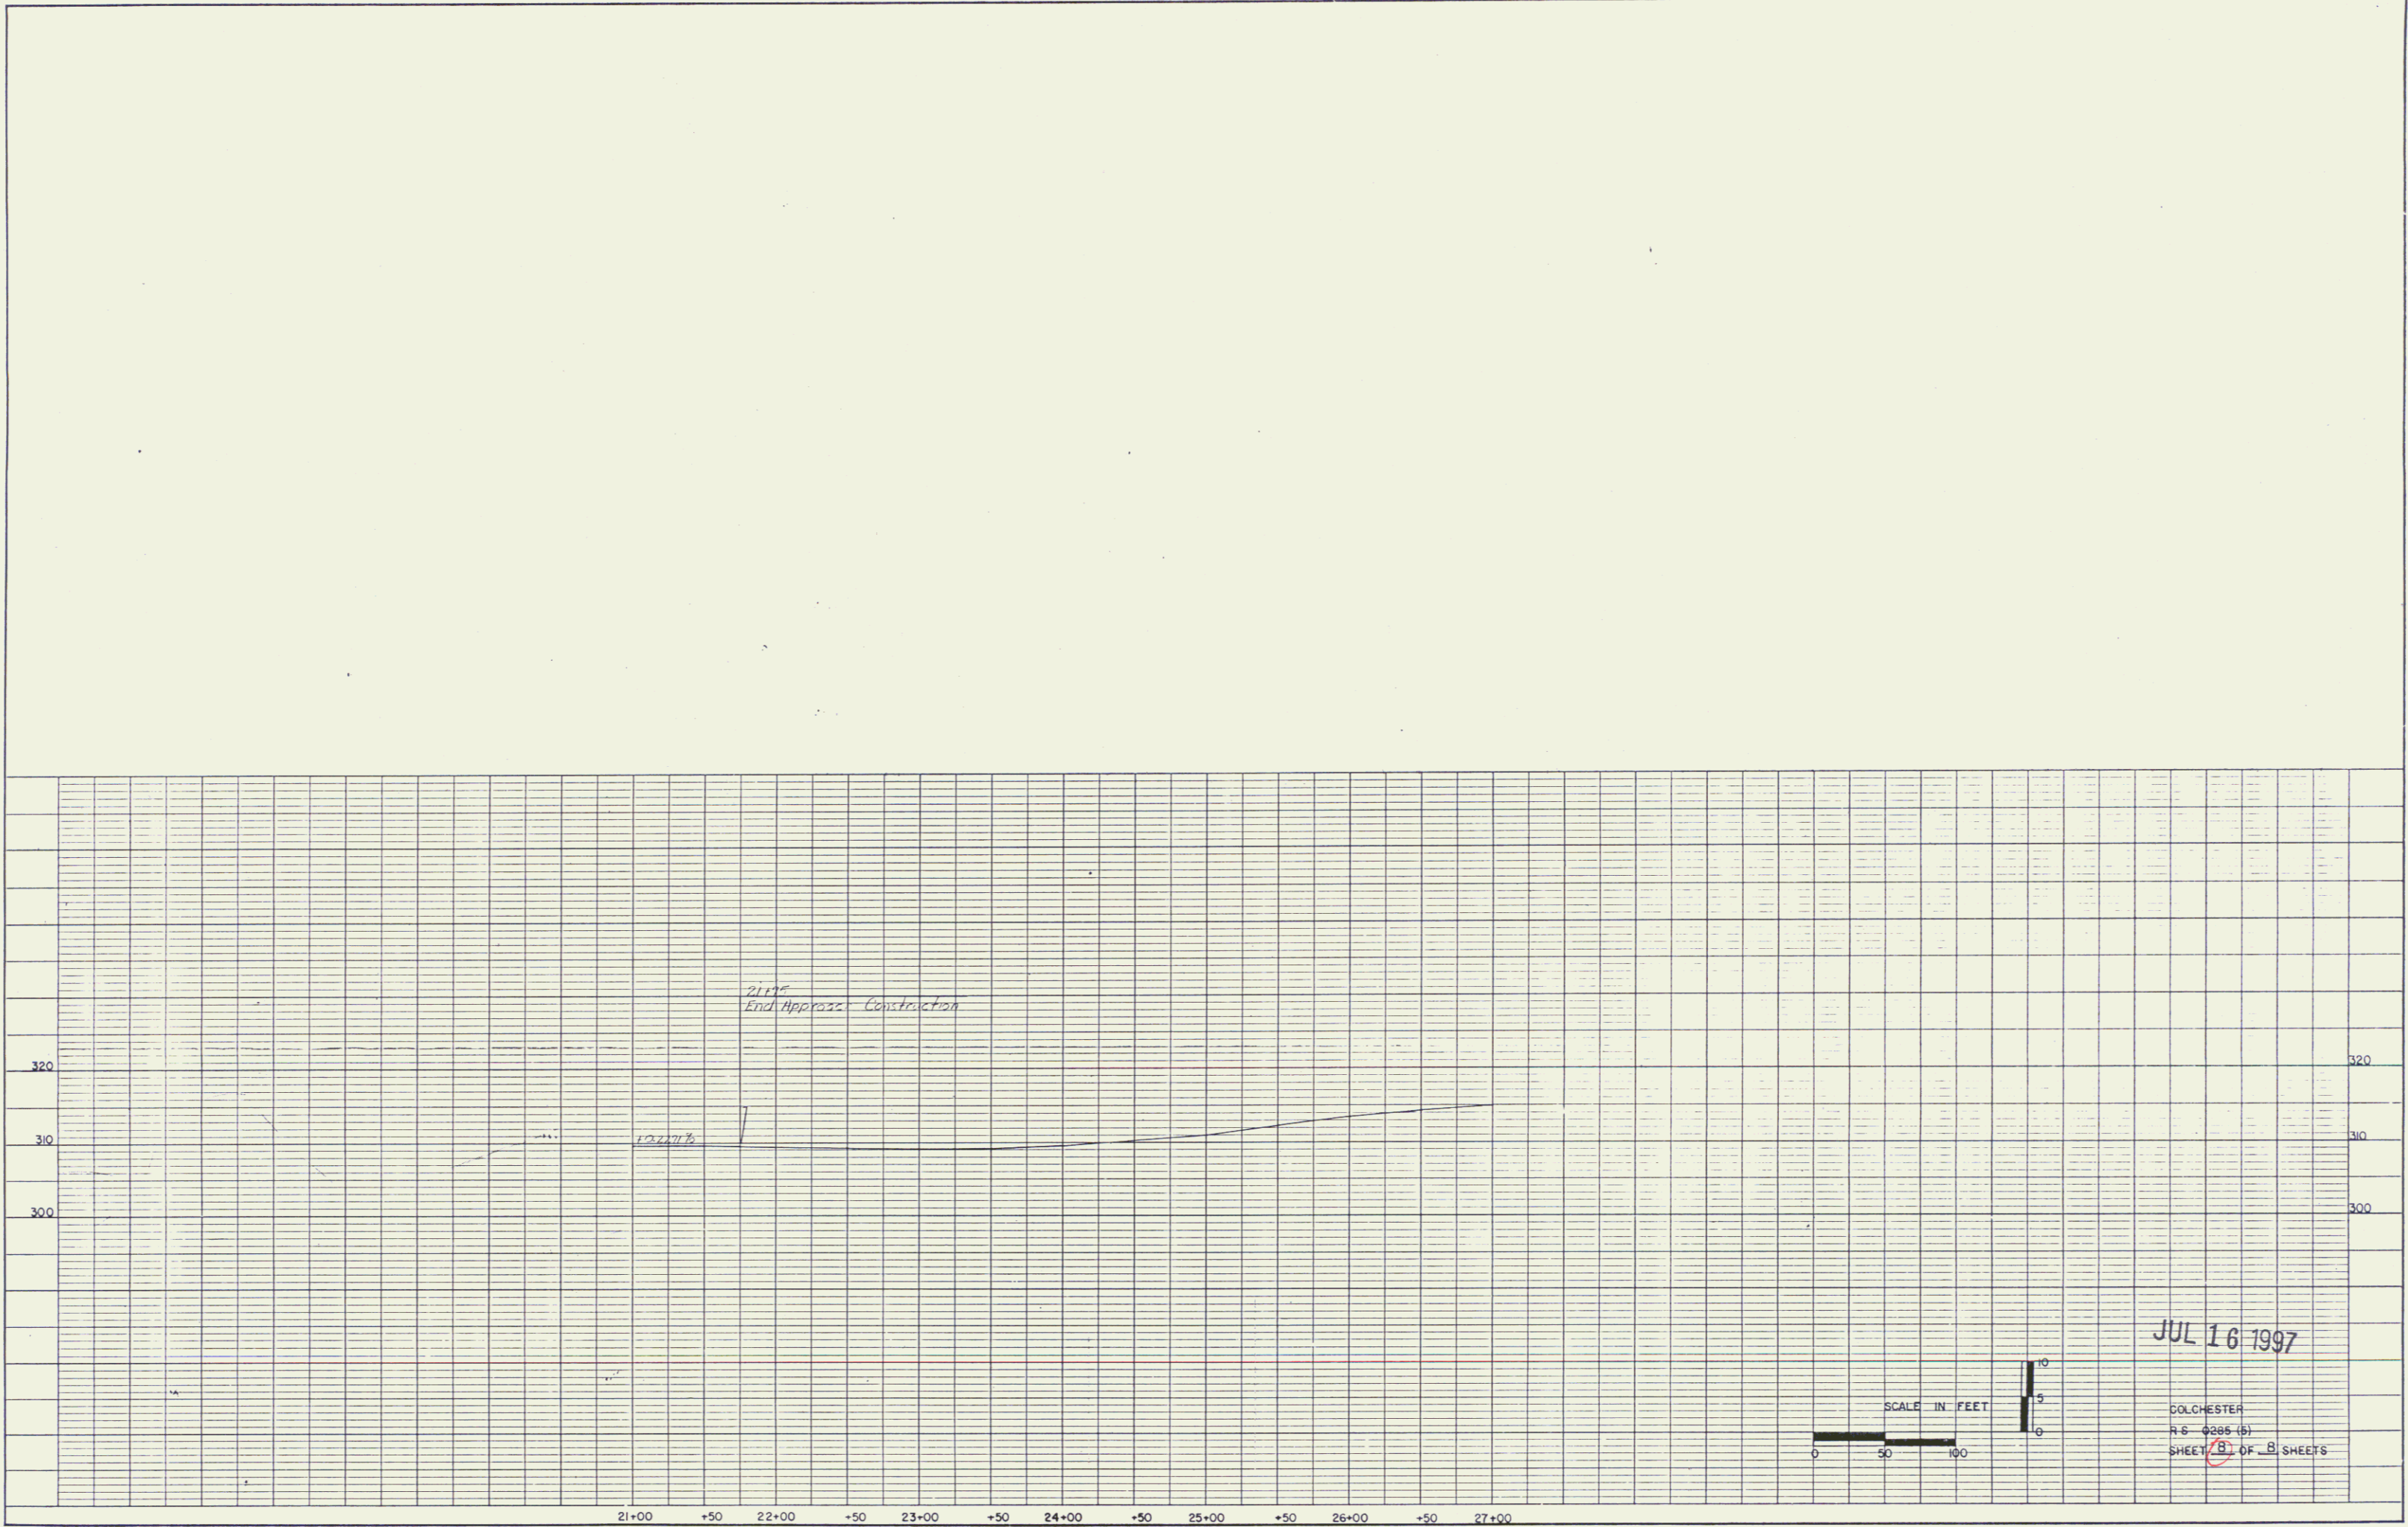

K&E PLATE 1, PLAN-PROFILE
 EQUIP & ENR CO.

JUL 16 1997

DOLCHESTER
 R. E. 0285 (b)
 SHEET 8 OF 8 SHEETS

9