

DRILLS AND BLASTING OF  
SOLID ROCK SUBGRADE  
13+50 ~ 16+50


STANDARD STEEL BEAM GUARD RAIL  
W/ WOOD POST, TYPE II  
LT RT  
21+00-23+93 19+82 ~ 24+00

CONSTRUCT SPECIAL DITCH  
W/ STONE FILL, TYPE I  
(Excavation To be paid under Item 203.15)

LT 10+95 ~ 19+75  
RT 20+25 ~ 24+00

TREATED TIMBER CURB  
RT 19+06 ~ 23+35

UNCLASSIFIED CHANNEL EXCAVATION  
RT 10+40 ~ 22+10

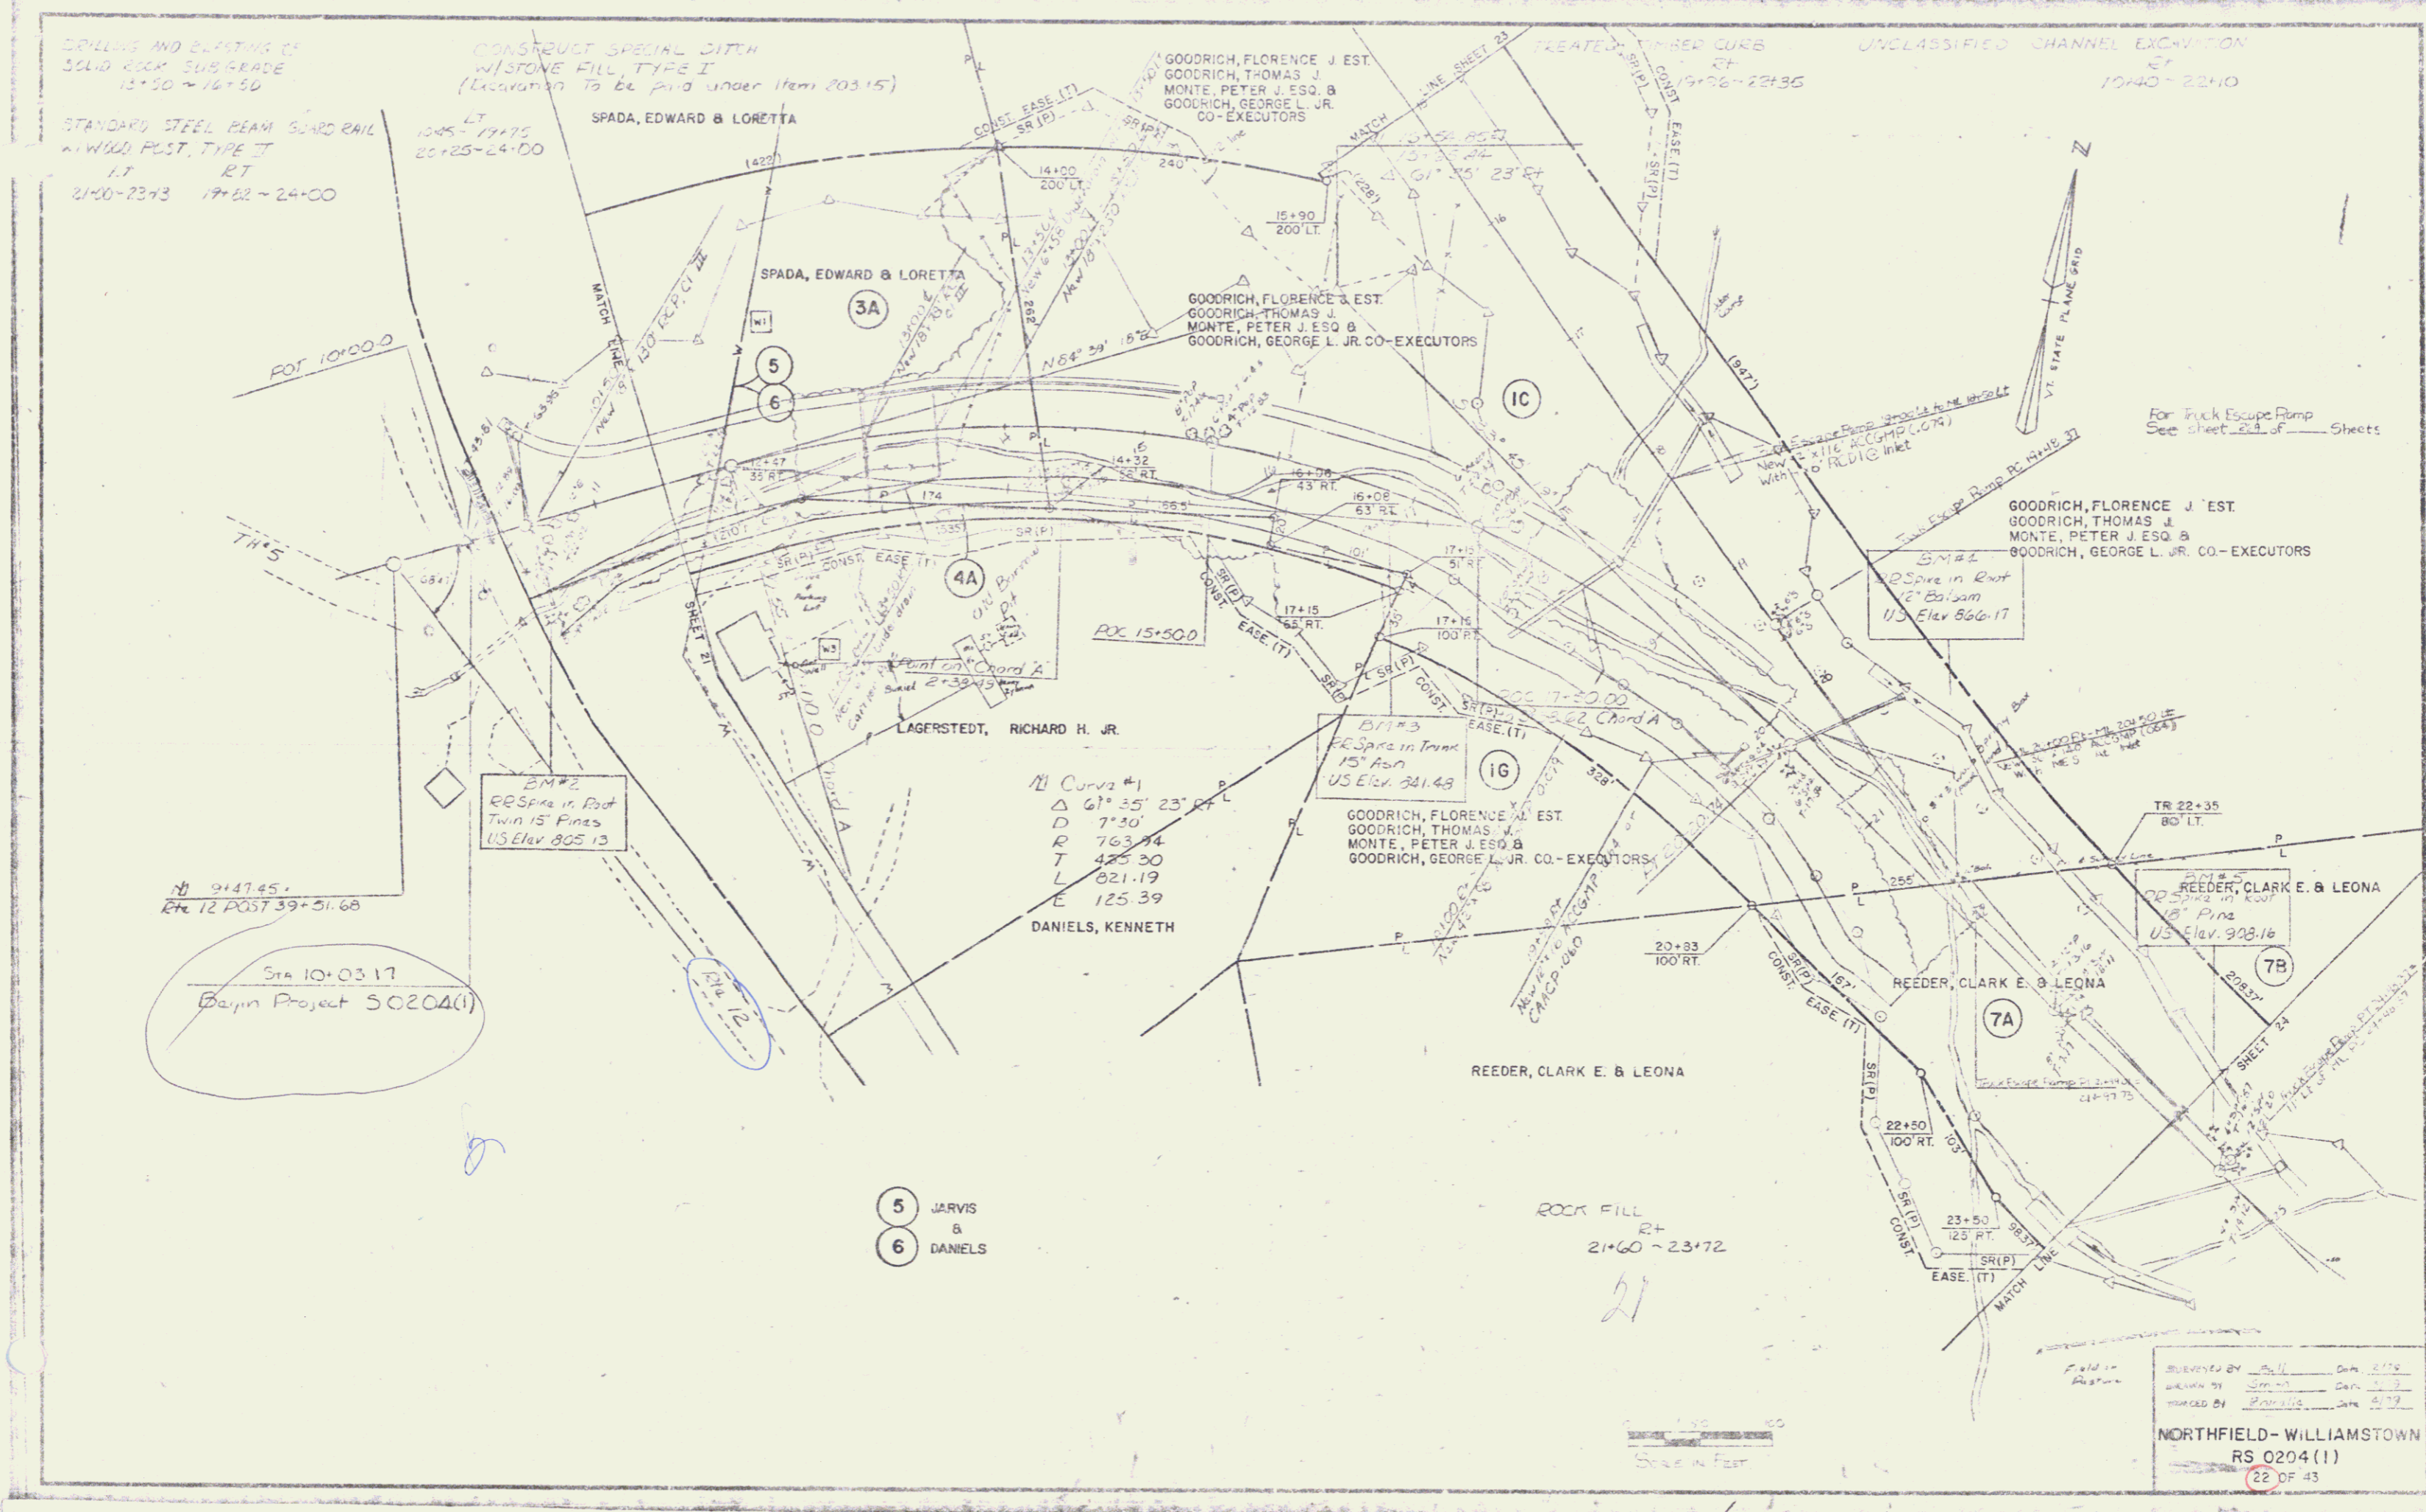

N 9147.45  
Sta 12 POST 39+51.68

Sta 10+03.17  
Begin Project 50204(1)

Curve #1  
Δ 67° 35' 23" RT  
D 7+30'  
R 763.74  
T 425.30  
E 125.39  
DANIELS, KENNETH

B71#3  
RE Spoke in Tank  
15" Radn  
US Elev. 341.48

BM #2  
RS Spoke in Post  
12" Balsam  
US Elev. 866.17

BM #5  
RS Spoke in Post  
15" Pins  
US Elev. 908.16

Field Notes  
Checked by  
Reviewed by  
Planned by

DATE 8/19  
DATE 8/19  
DATE 8/19

NORTHFIELD-WILLIAMSTOWN  
RS 0204(1)  
22 OF 43

For Truck Escape Ramp  
See sheet 21 of 32 Sheets

ROCK FILL  
RT  
21+60 ~ 23+72

Scale in Feet