

DRILLING AND BLASTING OF
SOLID ROCK SUBGRADE
40+00 ~ 41+00
54+00 ~ 56+00

STANDARD STEEL BEAM GUARDRAIL
W/ WOOD POST TYPE II
LT RT
40+00 ~ 56+00

TREATED TIMBER CURB
LT RT
40+00 ~ 45+30

CONSTRUCT SPECIAL DITCH
W/ STONE FILL, TYPE I
(EXCAVATION TO BE PAID AS
ITEM 203.15)
LT RT
40+00 ~ 40+75



CONSTRUCT SPECIAL DITCH
(EXCAVATION TO BE PAID AS
ITEM 204.20)
LT RT
47+25 ~ 47+75

ROCK FILL
(Rox Encountered on Project)
41+75 ~ 52+75

EROSION MATTING
LT
40+75 ~ 42+00
45+25 ~ 56+00

CONSTRUCT SPECIAL DITCH
W/ STONE FILL, TYPE I
(EXCAVATION TO BE PAID AS
ITEM 204.20)
LT
42+00 ~ 43+75

GOODRICH, THOMAS J.
GOODRICH, FLORENCE J. EST.
COLLINS, CARLIE G.
SCHWAGER, CHLOE G.
MONTE, PETER J. ESQ. &
GOODRICH, GEORGE L. JR. CO.-EXECUTORS

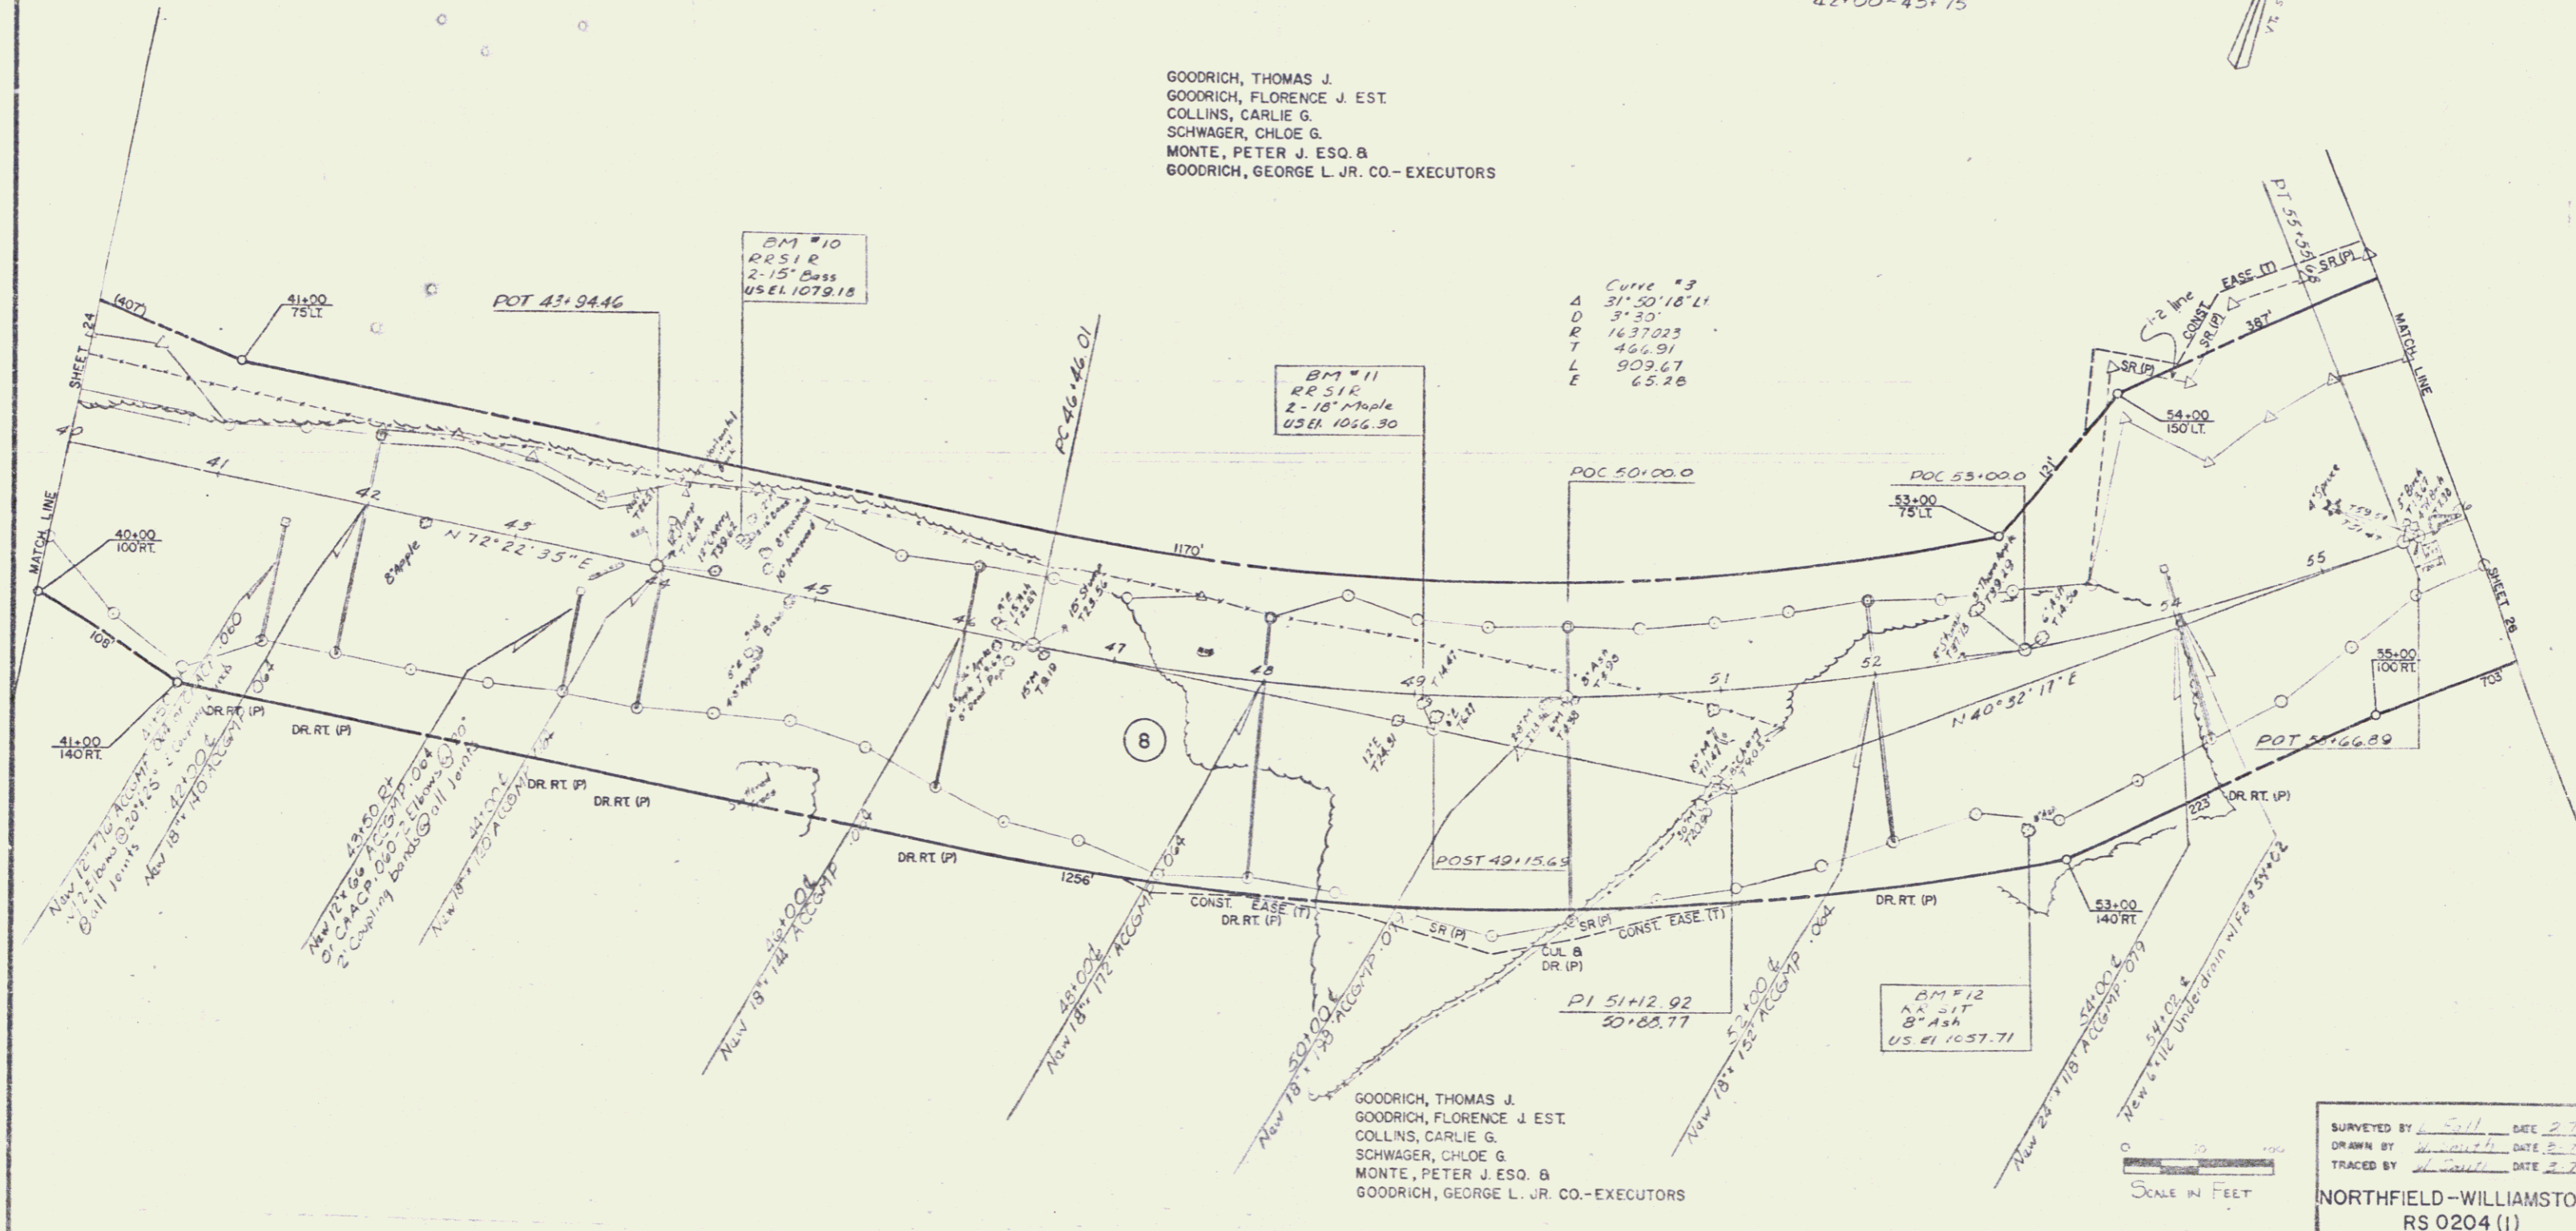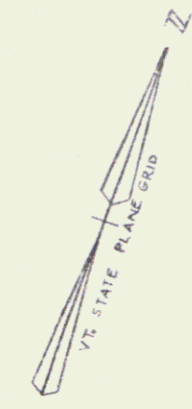

BM #10
RRSIR
2-15" Brass
US EL 1079.15

BM #11
RRSIR
2-18" Maple
US EL 1016.30

BM #12
AA 2" IT
8" Ash
US EL 1057.71

GOODRICH, THOMAS J.
GOODRICH, FLORENCE J. EST.
COLLINS, CARLIE G.
SCHWAGER, CHLOE G.
MONTE, PETER J. ESQ. &
GOODRICH, GEORGE L. JR. CO.-EXECUTORS

SURVEYED BY Full DATE 2.79
DRAWN BY Full DATE 2.79
TRACED BY Full DATE 2.79

SCALE IN FEET

NORTHFIELD-WILLIAMSTOWN
RS 0204 (1)
25 OF 43