


GUARD RAIL STANDARD STEEL BEAM
 WOOD POSTS TYPE II
 87+00 ~ 88+00 LT

PLAN

DATE	7/1/00
PROJECT	RS 0204 (1)
SCALE	AS SHOWN
BY	...
CHECKED	...
APPROVED	...

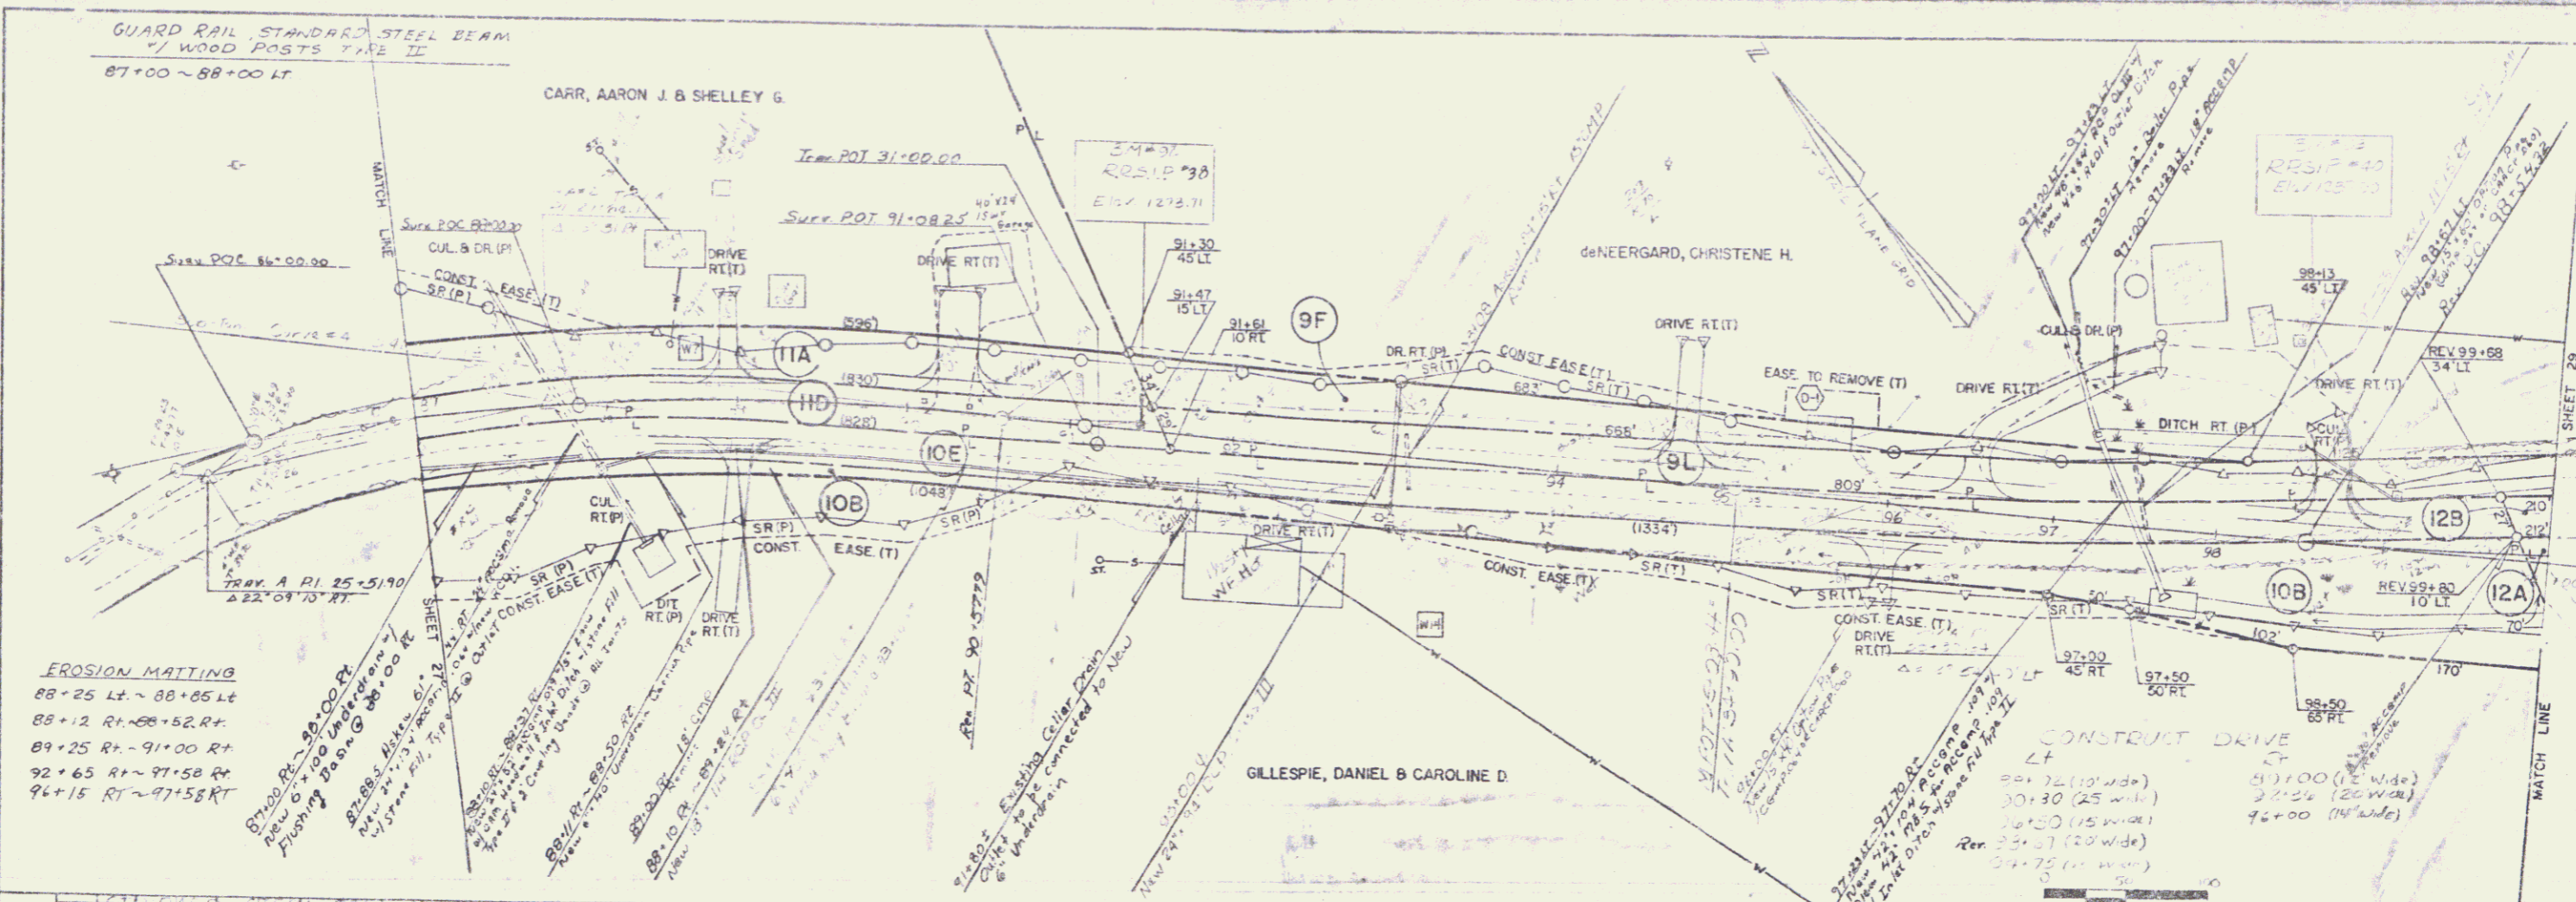


EROSION MATTING
 88+25 Lt ~ 88+25 Lt
 88+12 Rt ~ 88+52 Rt
 89+25 Rt ~ 91+00 Rt
 92+65 Rt ~ 91+58 Rt
 96+15 Rt ~ 97+58 Rt

CONSTRUCT DRIVE
 LT
 88+75 (10' wide)
 90+30 (25' wide)
 96+00 (15' wide)
 96+00 (20' wide)
 96+75 (11' wide)

PROFILE

DATE	7/1/00
PROJECT	RS 0204 (1)
SCALE	AS SHOWN
BY	...
CHECKED	...
APPROVED	...

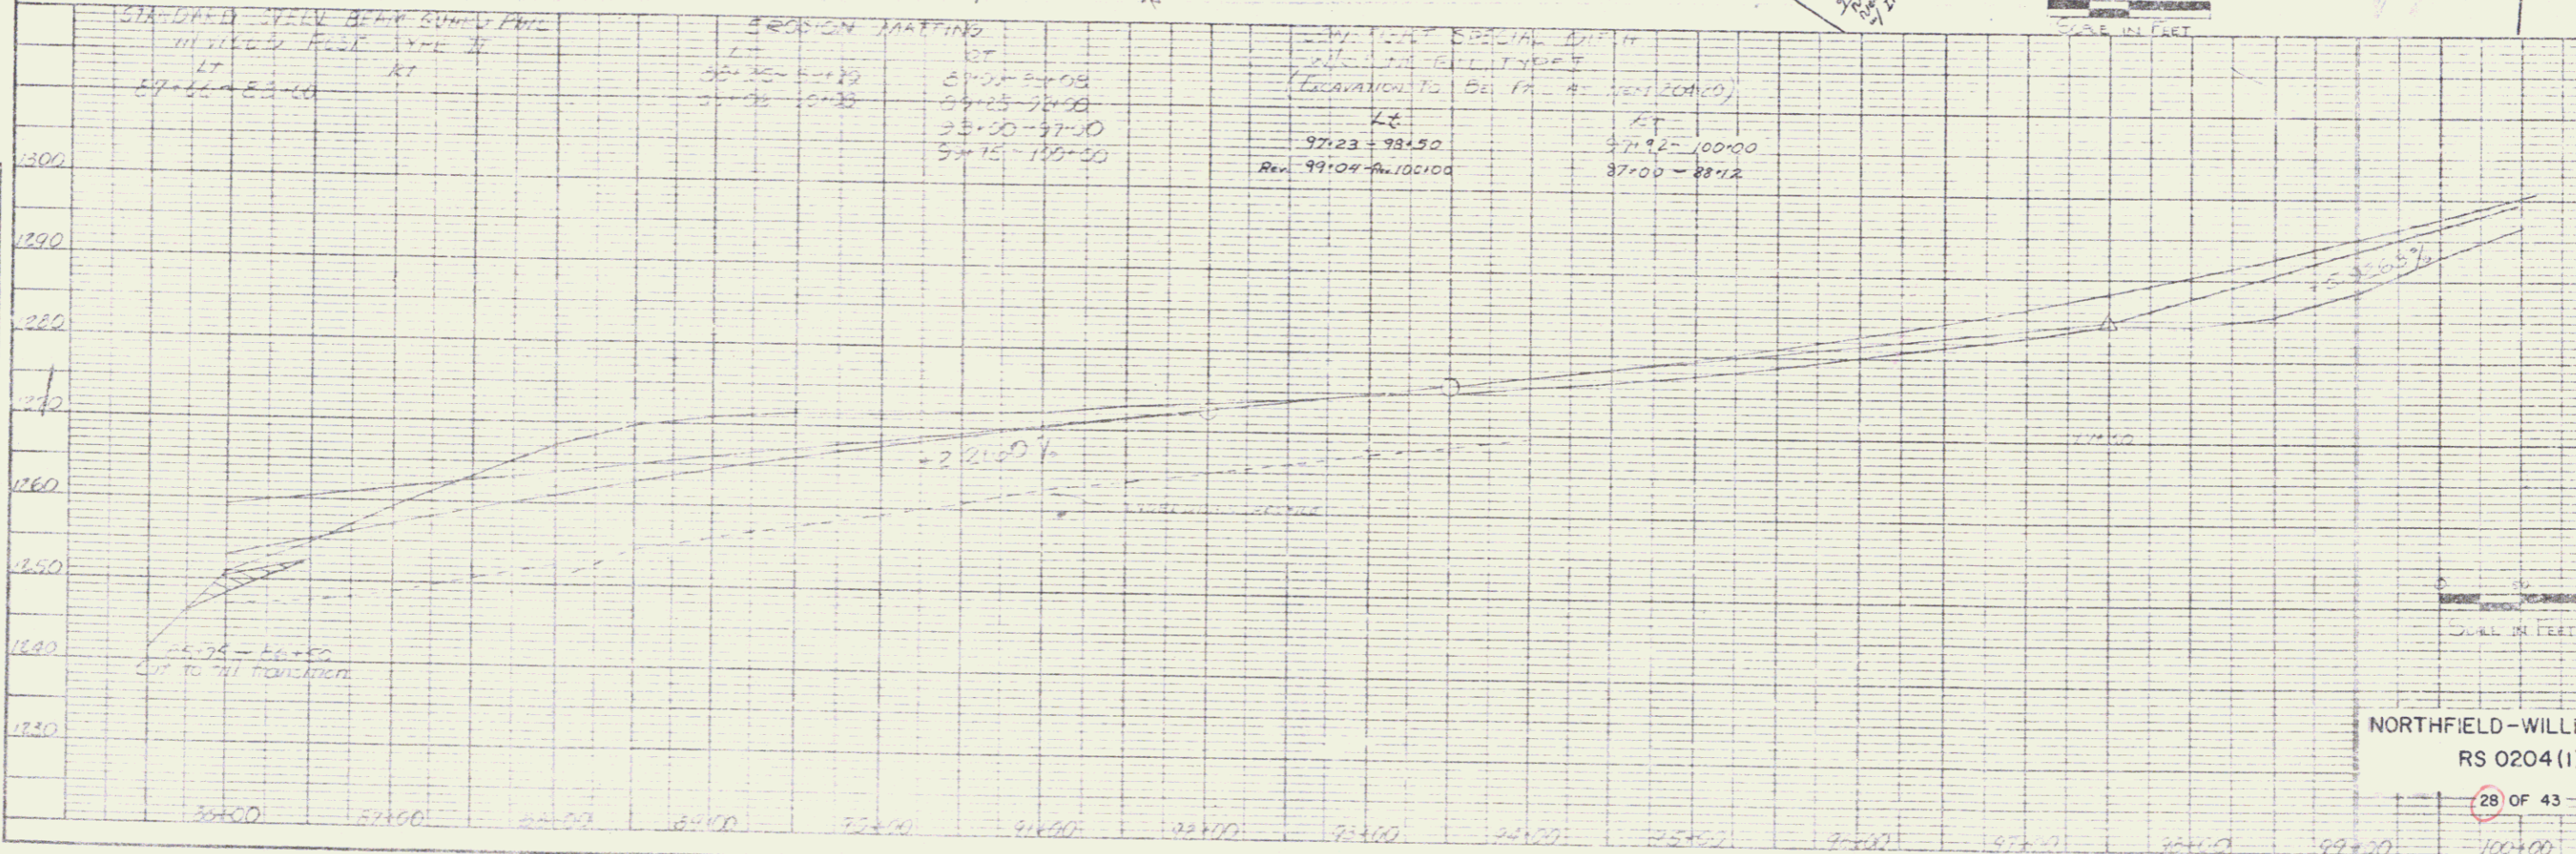

NORTHFIELD-WILLIAMSTOWN
 RS 0204 (1)