
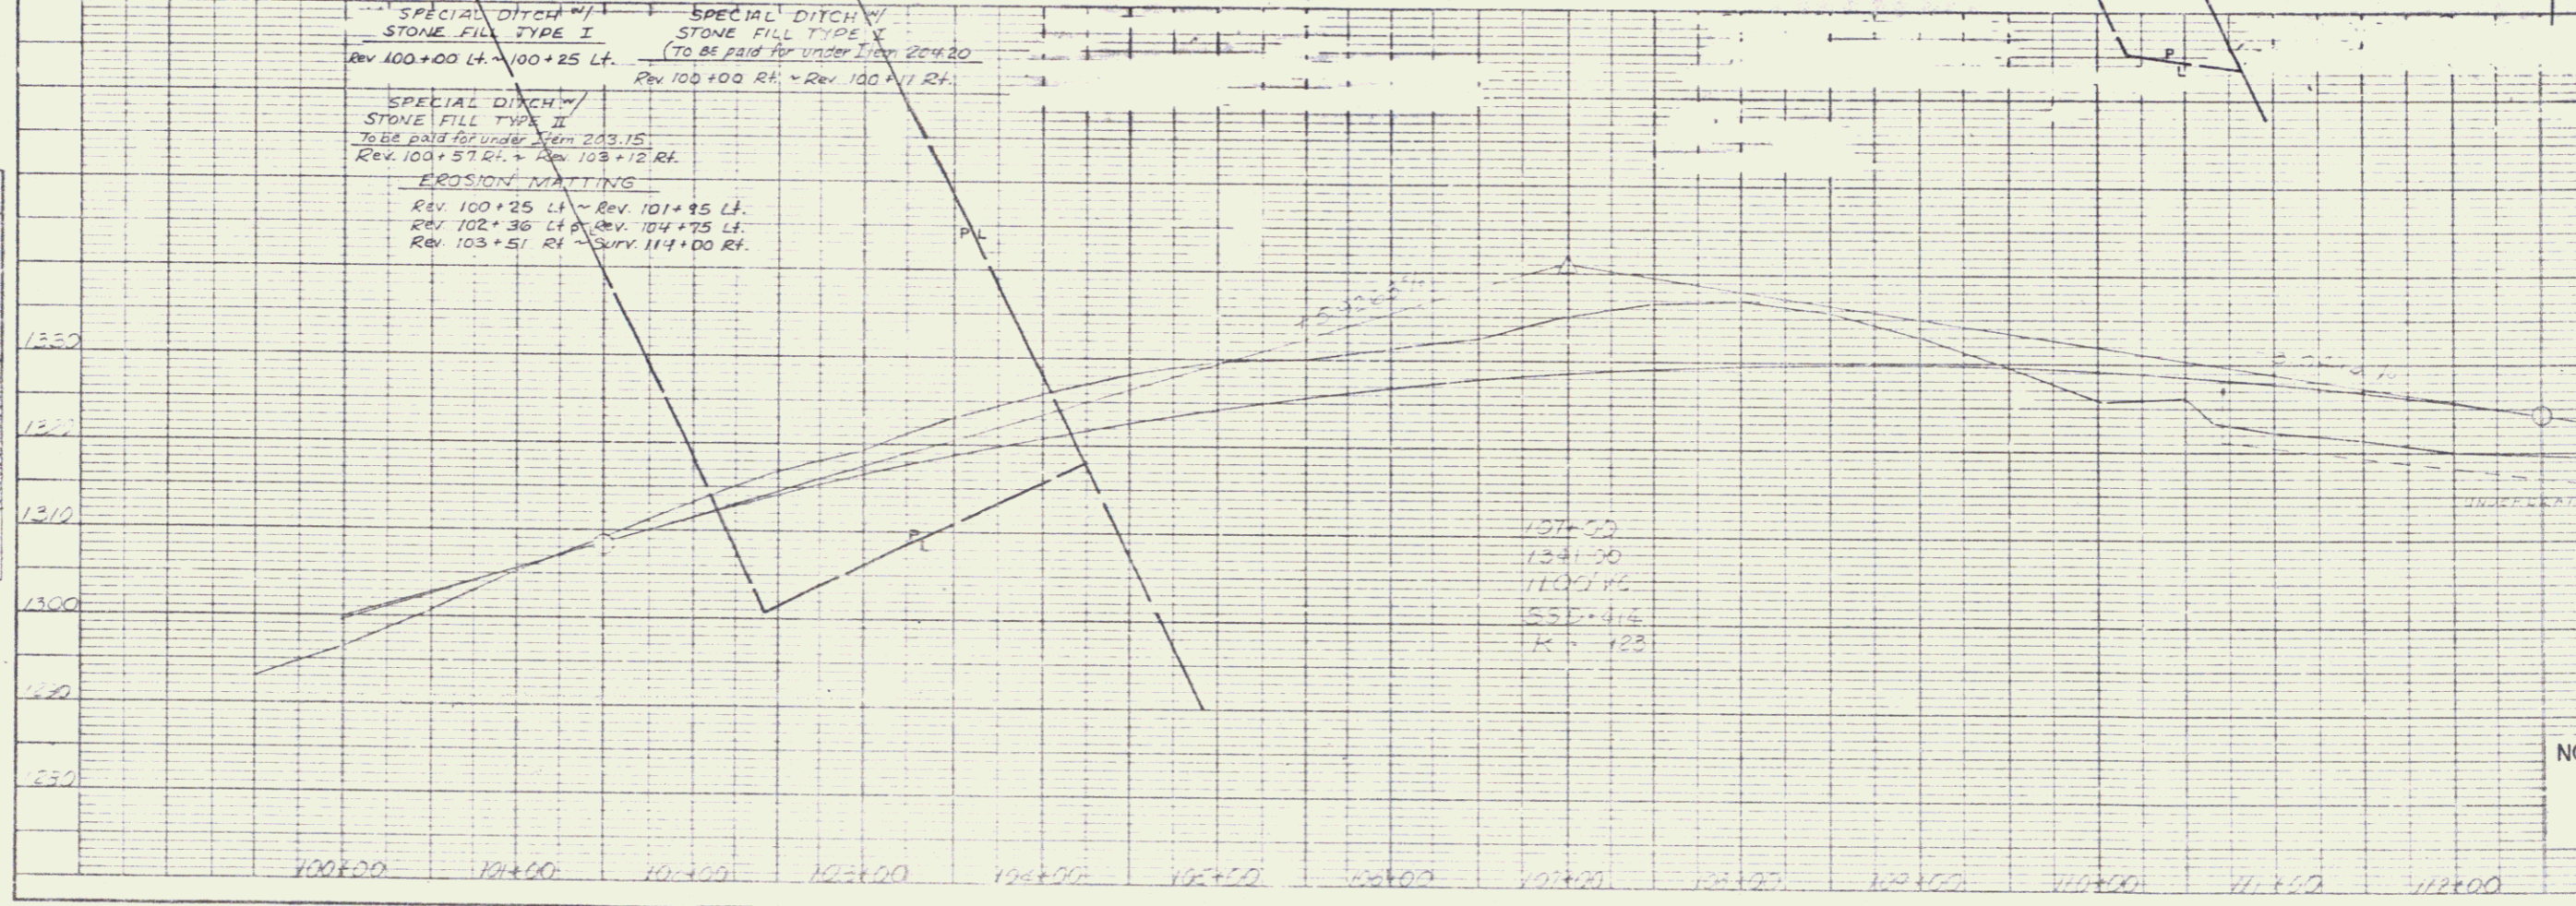


**PLAN**  
 DATE: 11/11/11  
 DRAWN BY: J. J. [unclear]  
 CHECKED BY: [unclear]  
 PROJECT: [unclear]

**PROFILE**  
 DATE: 11/11/11  
 DRAWN BY: J. J. [unclear]  
 CHECKED BY: [unclear]  
 PROJECT: [unclear]

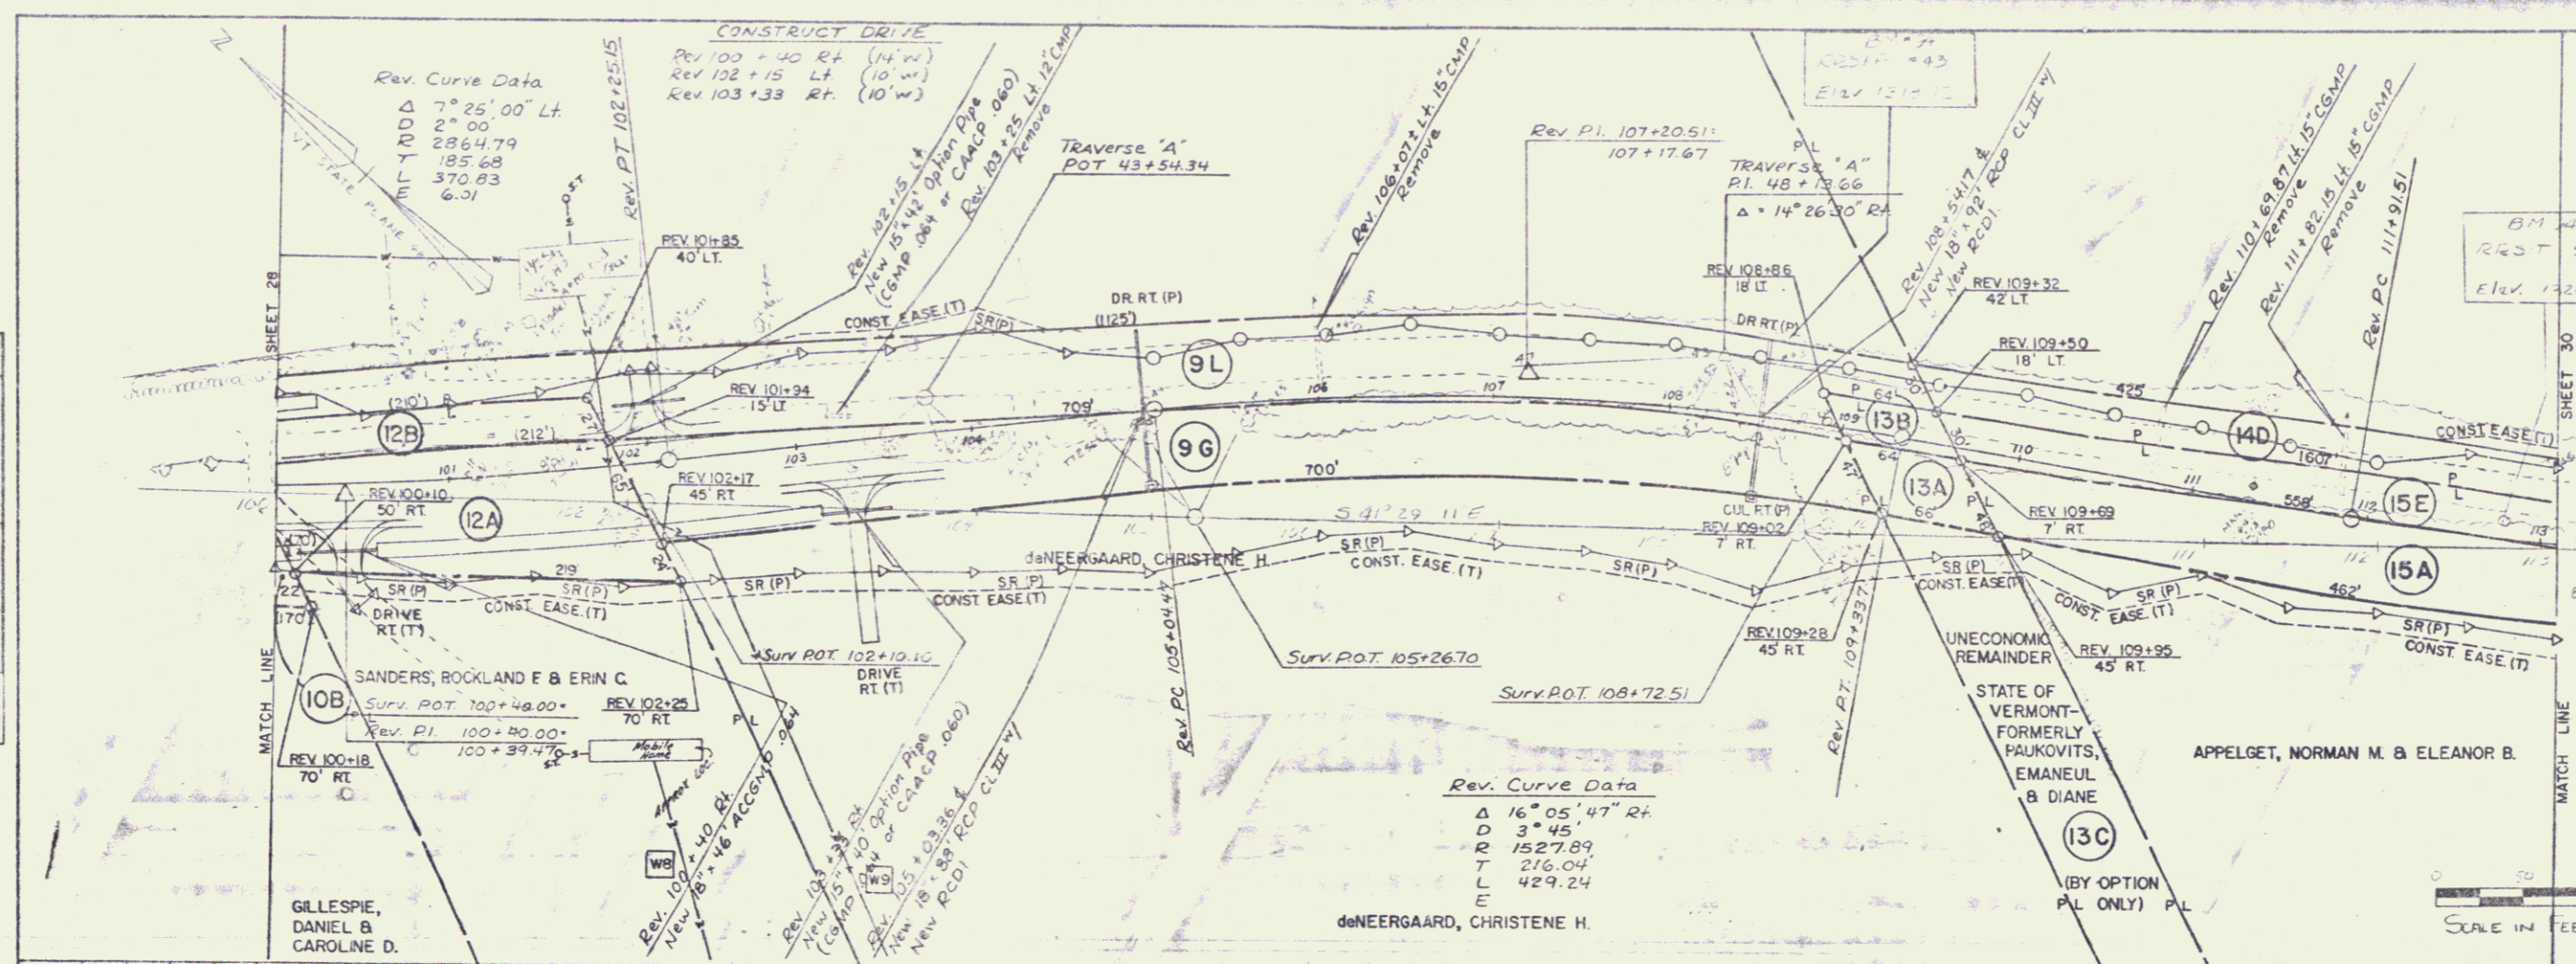

NORTHFIELD - WILLIAMSTOWN  
 RS 0204 (1)  
 29 OF 43