

PLAN  
 SHEET NO. 32 OF 43  
 DATE 10/15/10  
 DRAWN BY [illegible]  
 CHECKED BY [illegible]

UNCLASSIFIED CHANNEL  
 W/STONE FILL, TYPE II  
 RT  
 19+50-21+75

DRILLING AND BLASTING OF  
 SOLID ROCK SUBGRADE  
 22+50-26+00

CONSTRUCT SPECIAL DITCH  
 W/STONE FILL, TYPE I  
 (Excavation To Be Paid as Item 20315)  
 LT  
 21+25-24+00      24+75-26+25

STANDARD STEEL BEAM GUARD RAIL  
 W/ WOOD POSTS, TYPE II  
 RT  
 19+00-20+85

SM+00  
 RES. L.P.  
 ELEV. 1390.00

DODGE, RICHARD F.  
 & MARGARET S.


HUFFMAN, CLETJUS M.  
 & ZELLA L.

SM+11  
 RES. L.P.  
 ELEV. 1397.04

CONST. SPECIAL DITCH  
 W/STONE FILL, TYPE I  
 (Excavation To Be Paid as Item 20315)  
 LT  
 19+75-20+27 (East)


STATE OF VERMONT  
 AGENCY OF TRANSPORTATION

END R.O.W. PROJECT  
 RS 0204 (1) STA. 25+49 C.

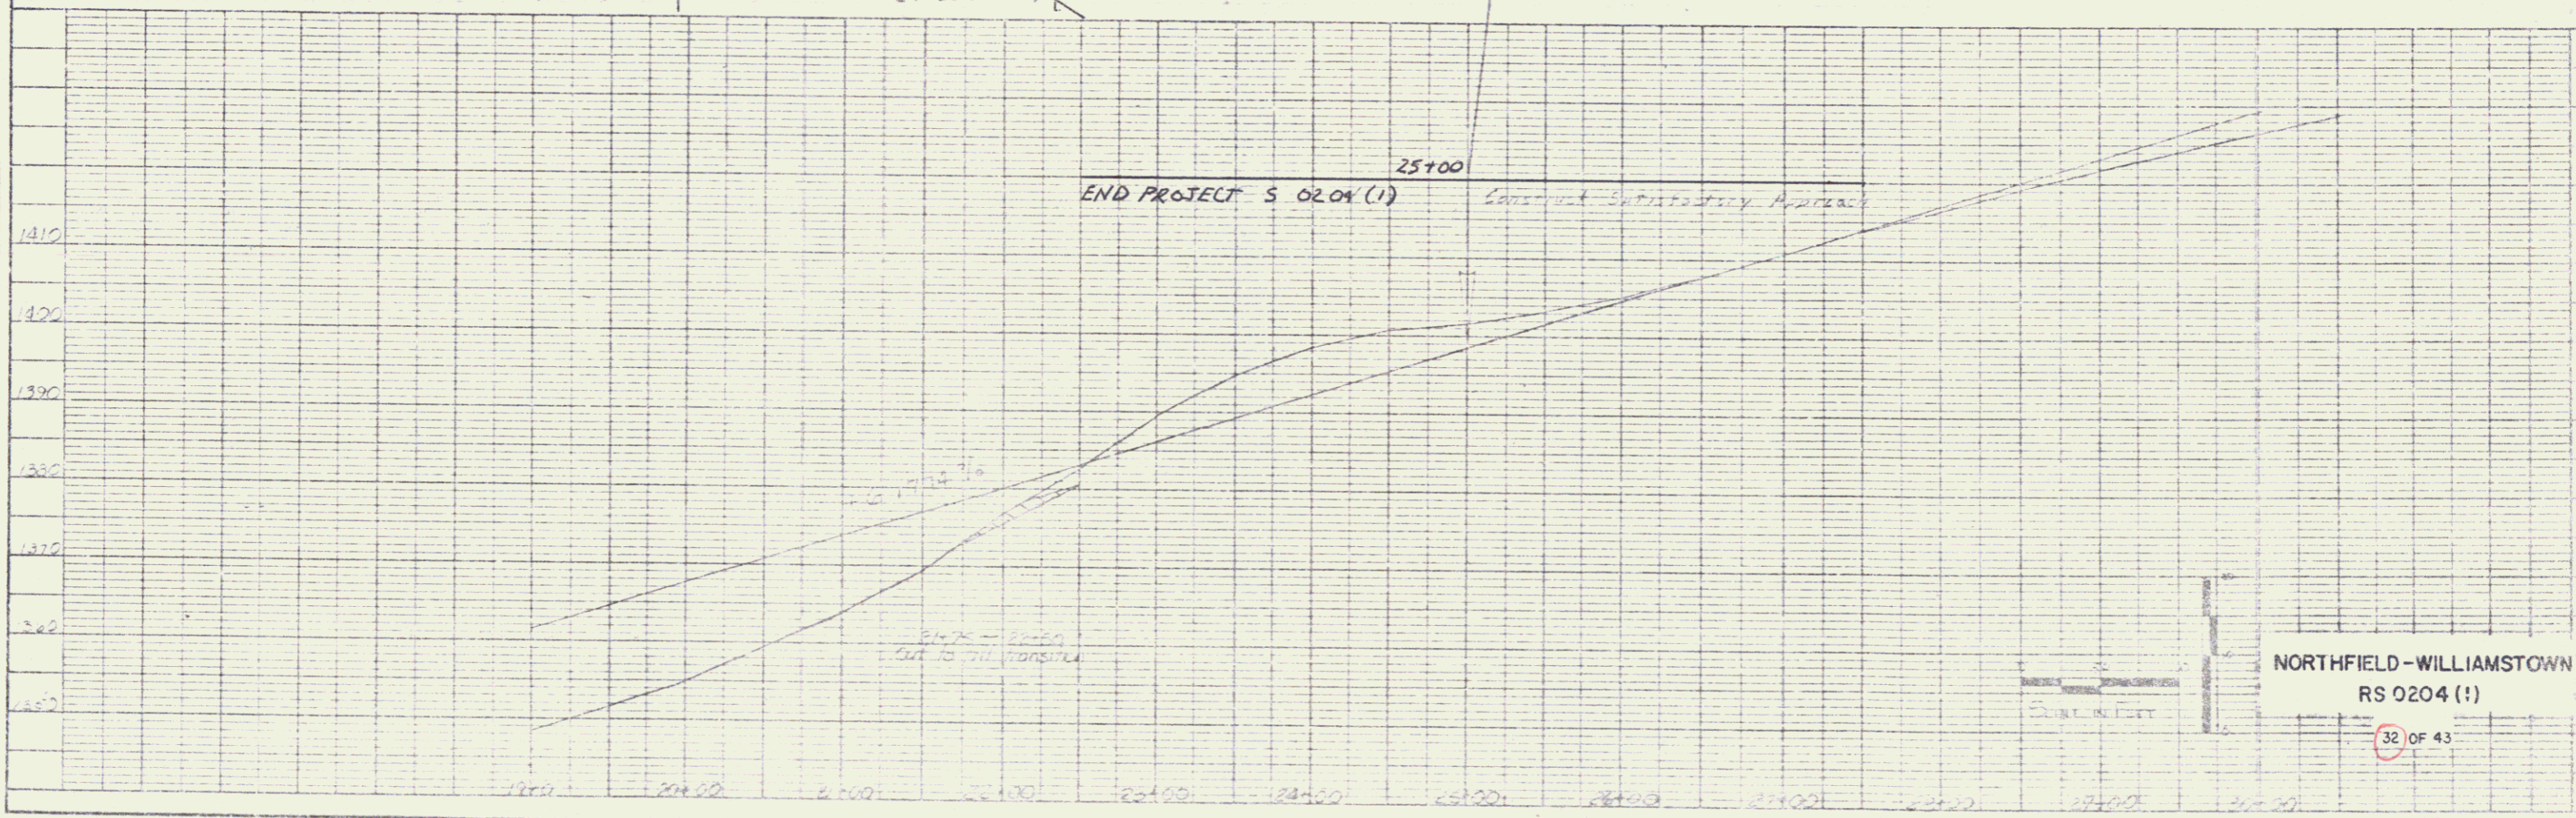

PROFILE  
 SHEET NO. 32 OF 43  
 DATE 10/15/10  
 DRAWN BY [illegible]  
 CHECKED BY [illegible]

SCALE IN FEET

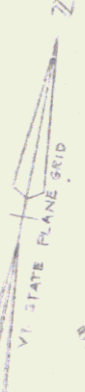

NORTHFIELD-WILLIAMSTOWN  
 RS 0204 (1)

32 OF 43