

REMOVAL AND DISPOSAL  
OF GUARD RAIL  
VT 104 115+25 - 115+30.0'


Construct Drive  
115+02 Rt (Paved)

REMOVE STONE  
VT 104 115+32 RT  
(COMMON EXCAVATION)

APPR CURVE DATA  
 Δ 81° - 57' LT  
 D 7.8952459  
 T 6.30 29  
 R 725.70  
 L 1037.97  
 E 235.50

BM # 1  
SIR 15" M  
US ELEV 549.30

BEGIN R.O.W. PROJECT  
RS 0279(2) STA. 115+02 CL

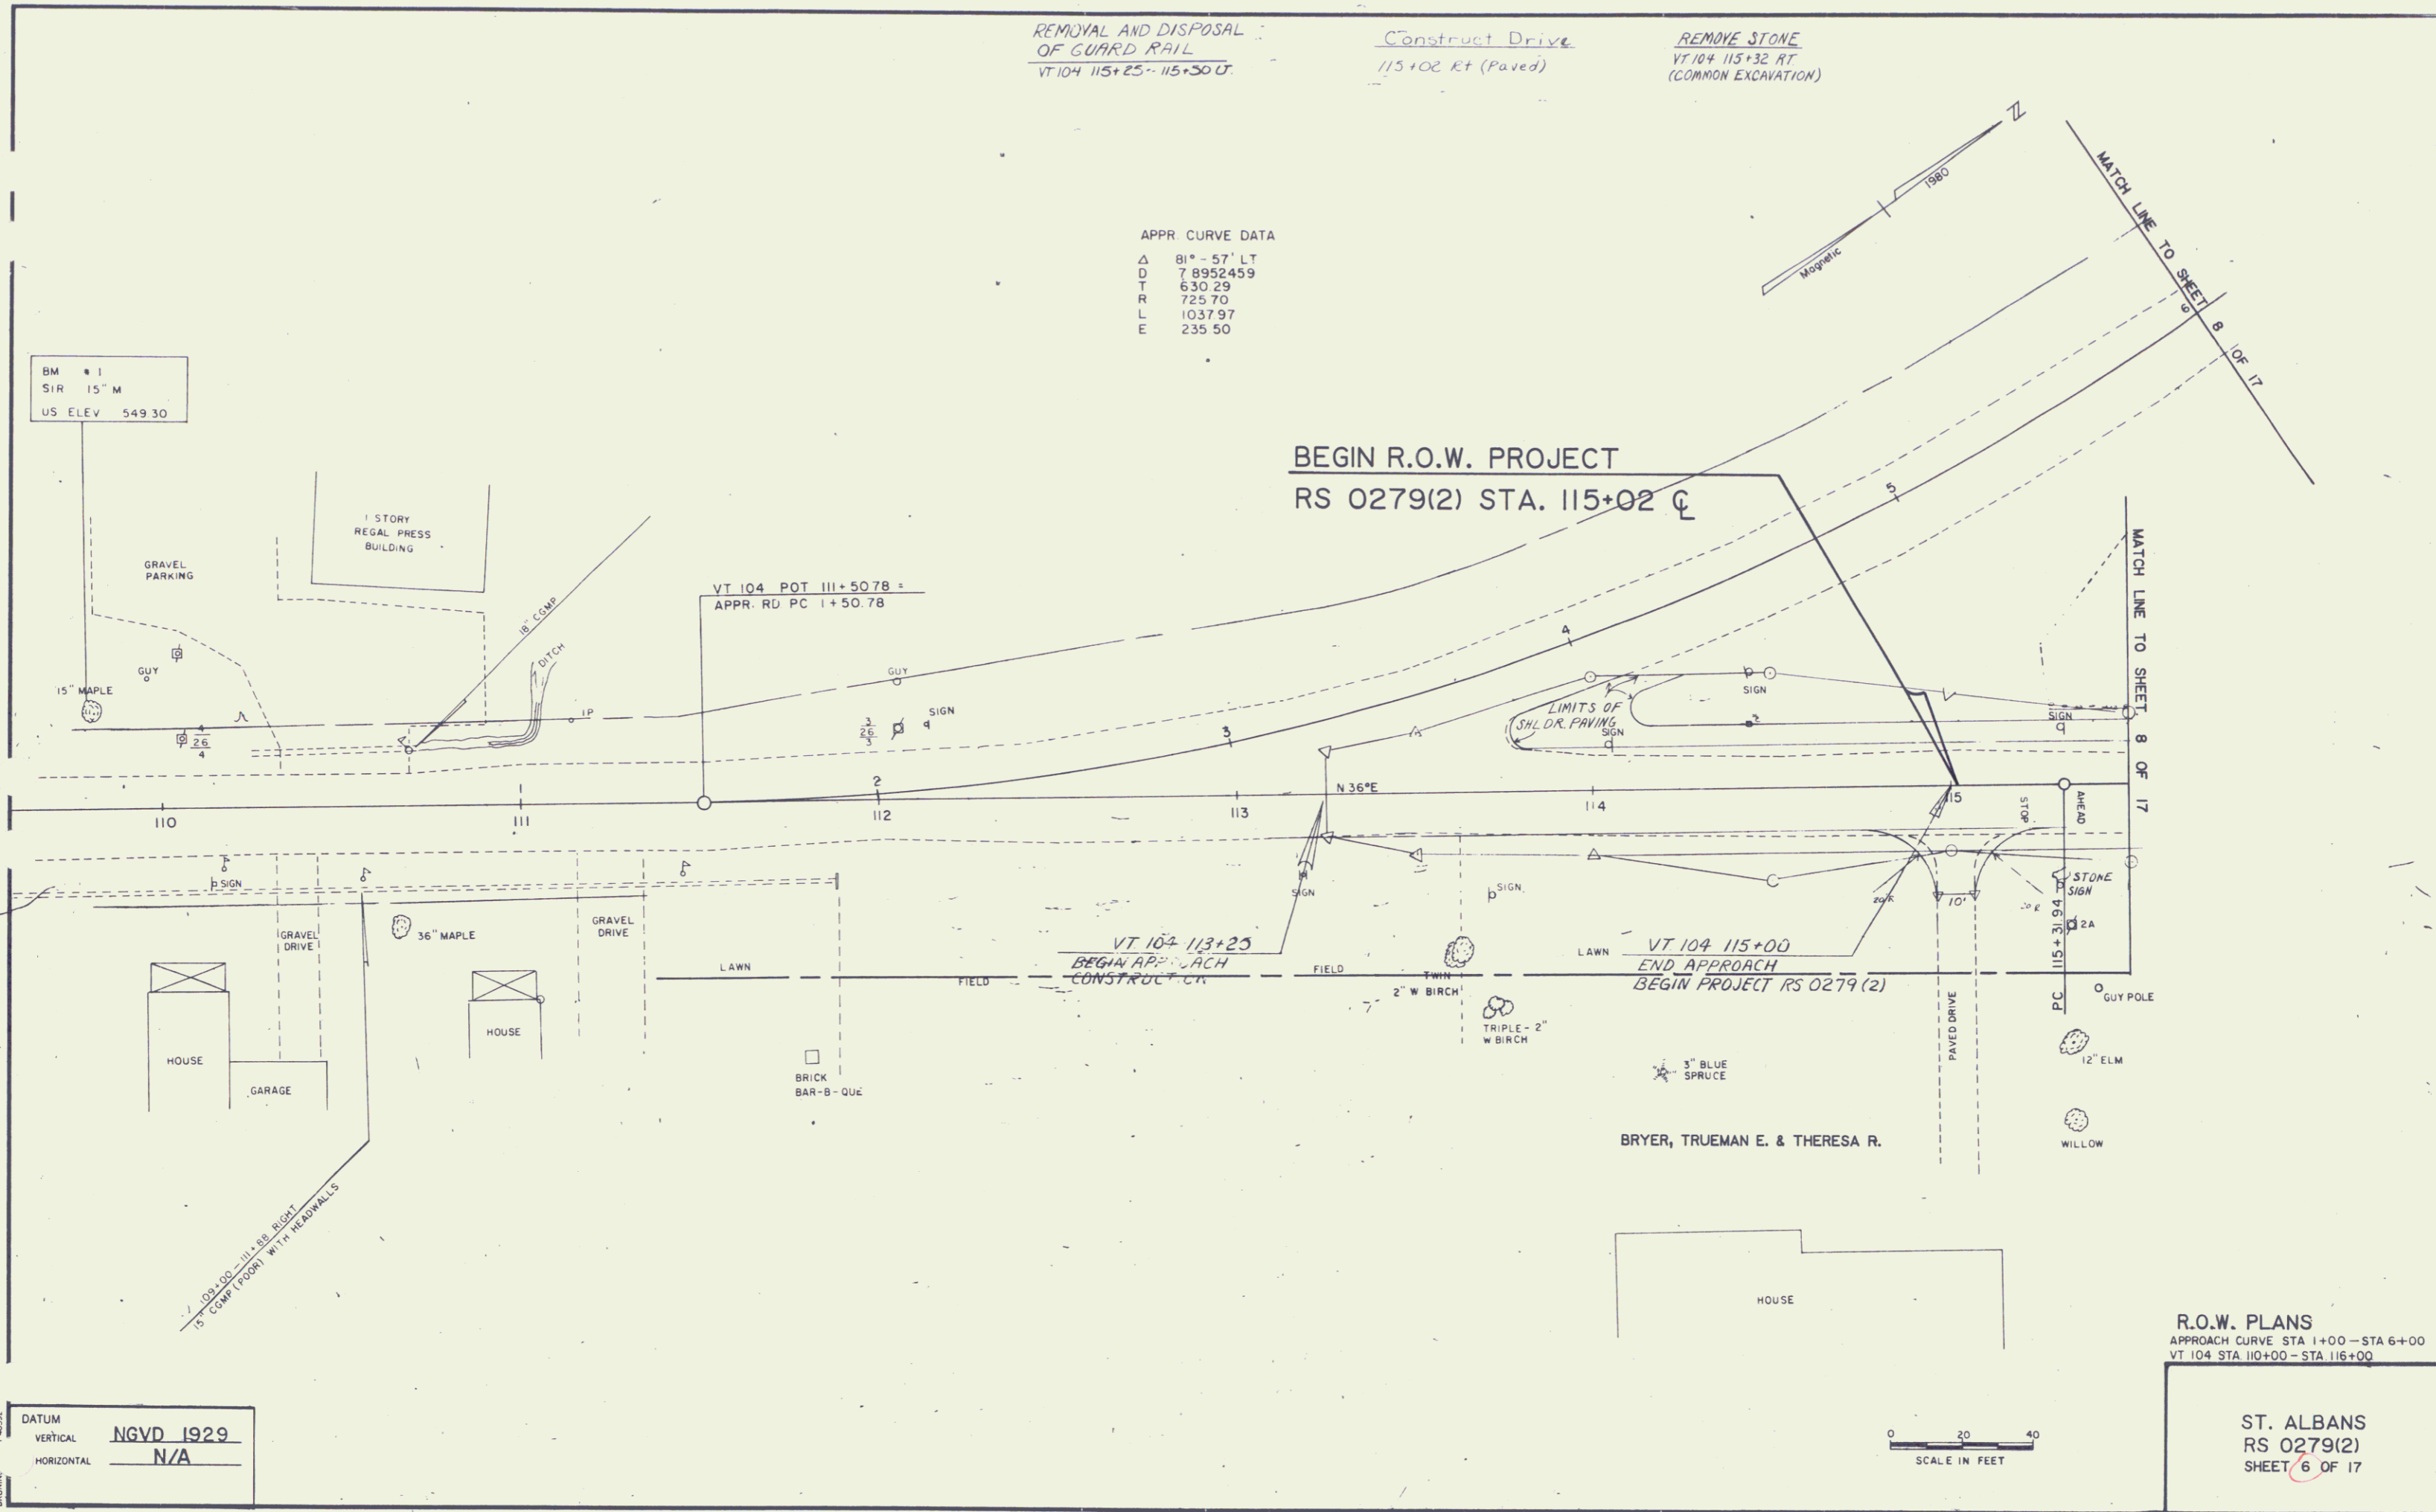

R.O.W. PLANS  
APPROACH CURVE STA 1+00 - STA 6+00  
VT 104 STA 110+00 - STA 116+00

ST. ALBANS  
RS 0279(2)  
SHEET 6 OF 17

7