



Construct Drive  
122+44 LF  
119+20 LT

Bituminous Concrete Curb  
Type A  
VT 104 119+00 ~ 120+00 RT

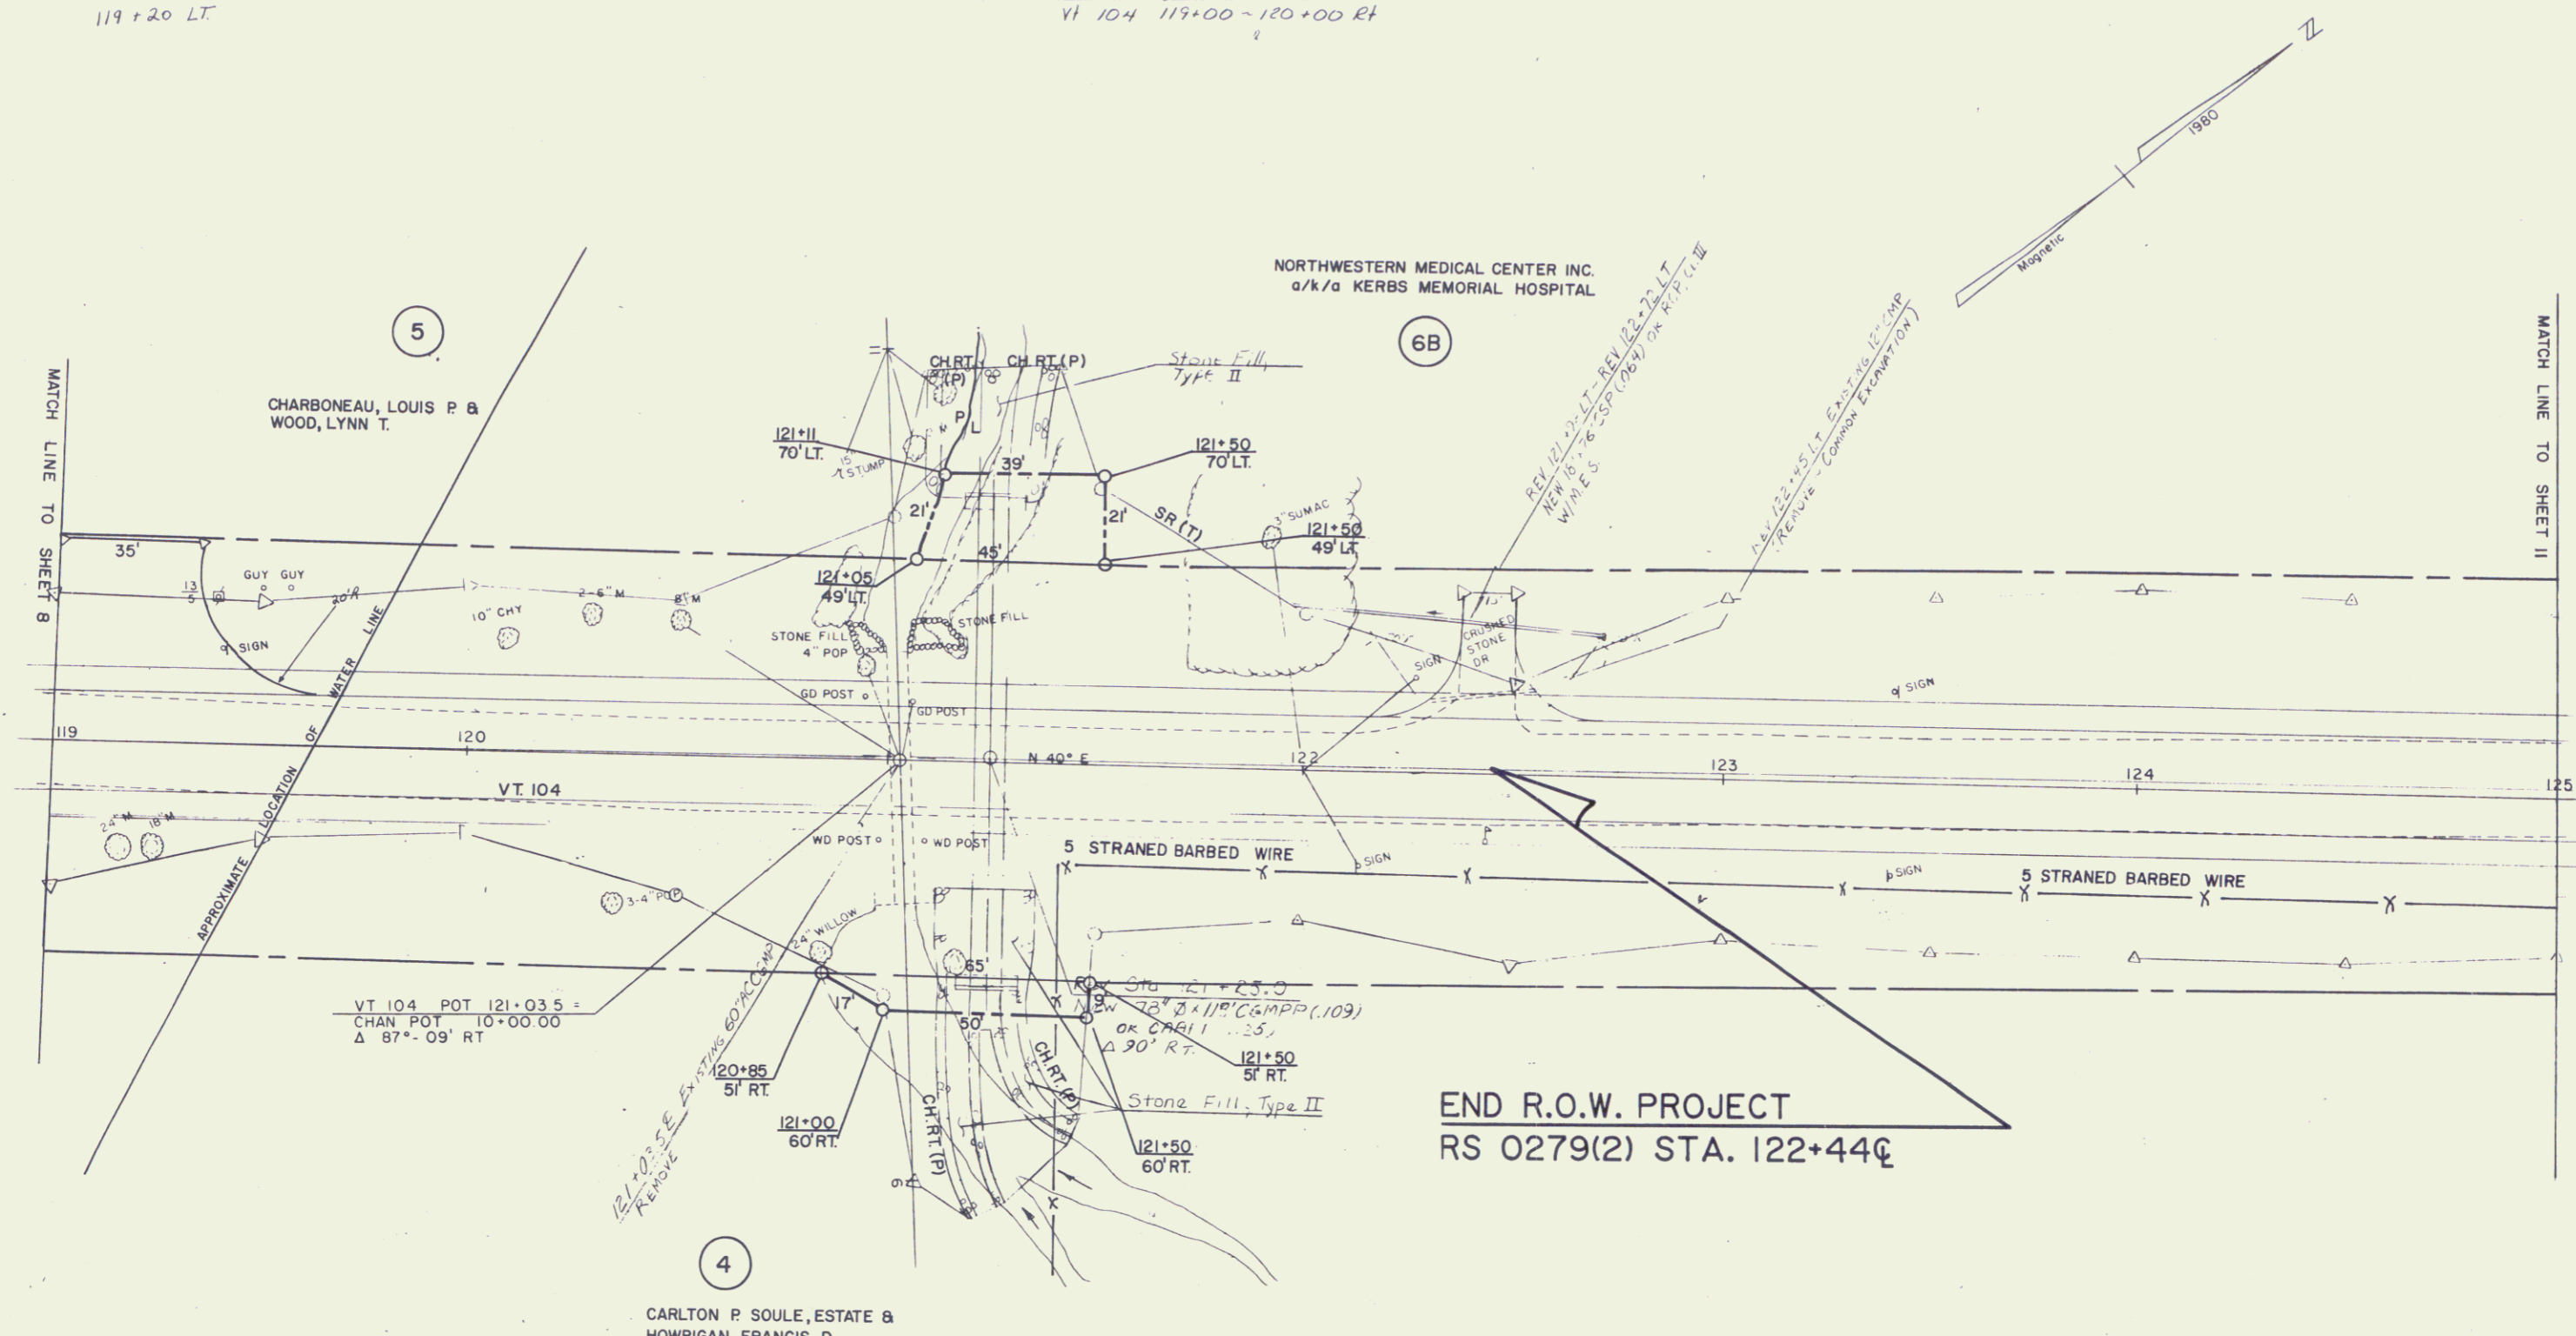

END R.O.W. PROJECT  
RS 0279(2) STA. 122+44¢

DATUM  
VERTICAL NGVD 1929  
HORIZONTAL N/A

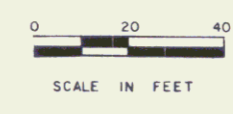

R.O.W. PLANS  
VT 104 STA. 119+00 - STA 125+00

ST. ALBANS  
RS 0279(2)  
SHEET 10 OF 17