

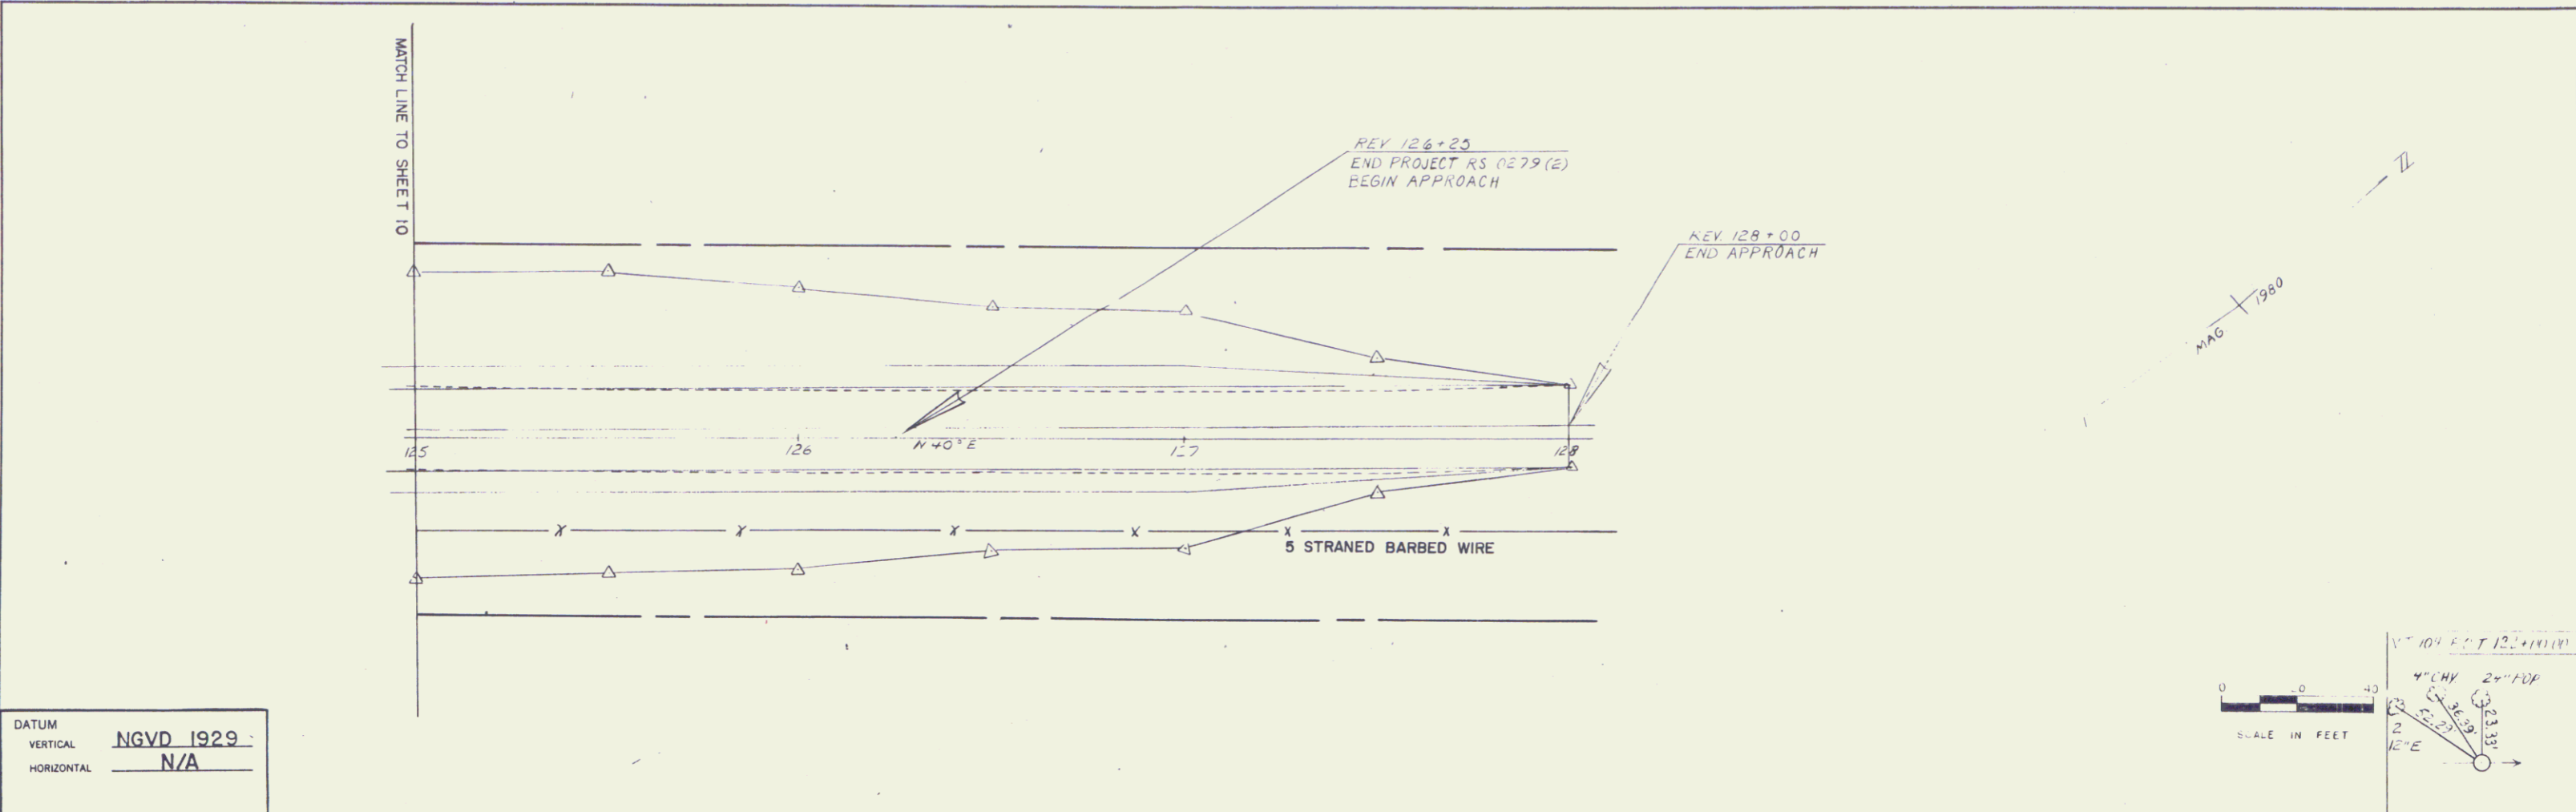
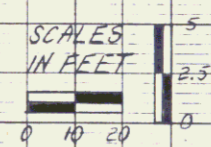


PLAN
 DATE: _____
 SHEET: _____
 NOTE BOOK: _____
 PROJECT: _____
 DRAWN BY: _____

PROFILE
 DATE: _____
 SHEET: _____
 NOTE BOOK: _____
 PROJECT: _____
 DRAWN BY: _____

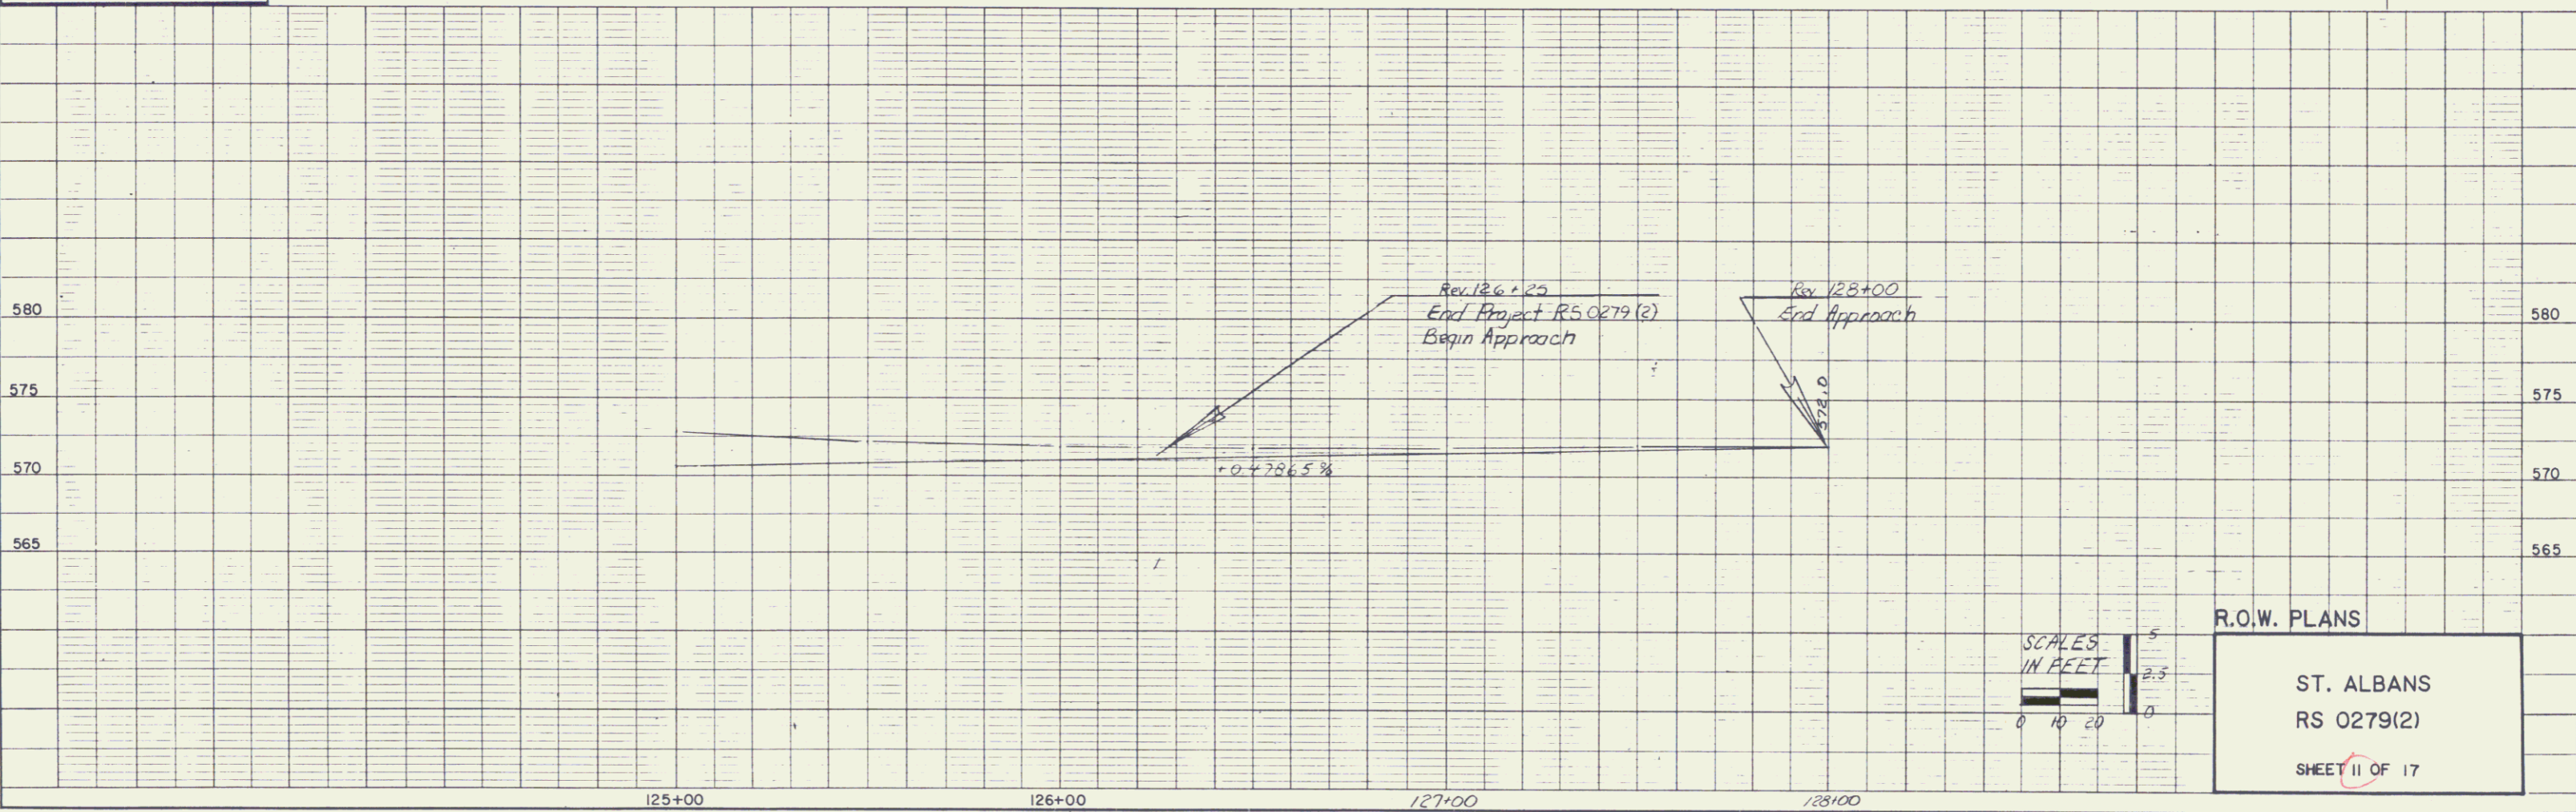

DATUM
 VERTICAL: NGVD 1929
 HORIZONTAL: N/A

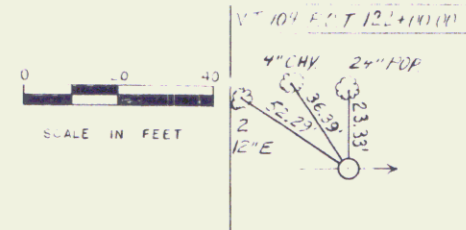

R.O.W. PLANS
 ST. ALBANS
 RS 0279(2)
 SHEET 11 OF 17