


Steel Beam Guard Rail
 142+23 - REV 150+23 LT.
 143+25 - 149+25 RT.
 ELEV 152.74 - REV 152+49 RT.

BEGIN MAINT. AGREE. AREA NO. 1
 T.H. 24 40+17
 (LENGTH 102')

Breakaway Cable Terminal
 144+00 - 144+23 LT.
 145+00 - 145+23 RT.
 REV 149+25 - REV 149+25 LT.
 REV 150+25 - REV 150+50 RT.
 REV 152+49 - REV 152+74 RT.
 REV 155+49 - REV 155+74 RT.


STA.	STA.	LOCATION
145+25	REV 149+25	LT.
REV 152+74	REV 155+49	RT.

STA.	LOCATION	TYPE	WIDTH
REV 152+74	RIGHT	GRAVEL	18 FT.
REV 154+25	LEFT	GRAVEL	12 FT.
TOWN HIGHWAY #24	LEFT	GRAVEL	12 FT.

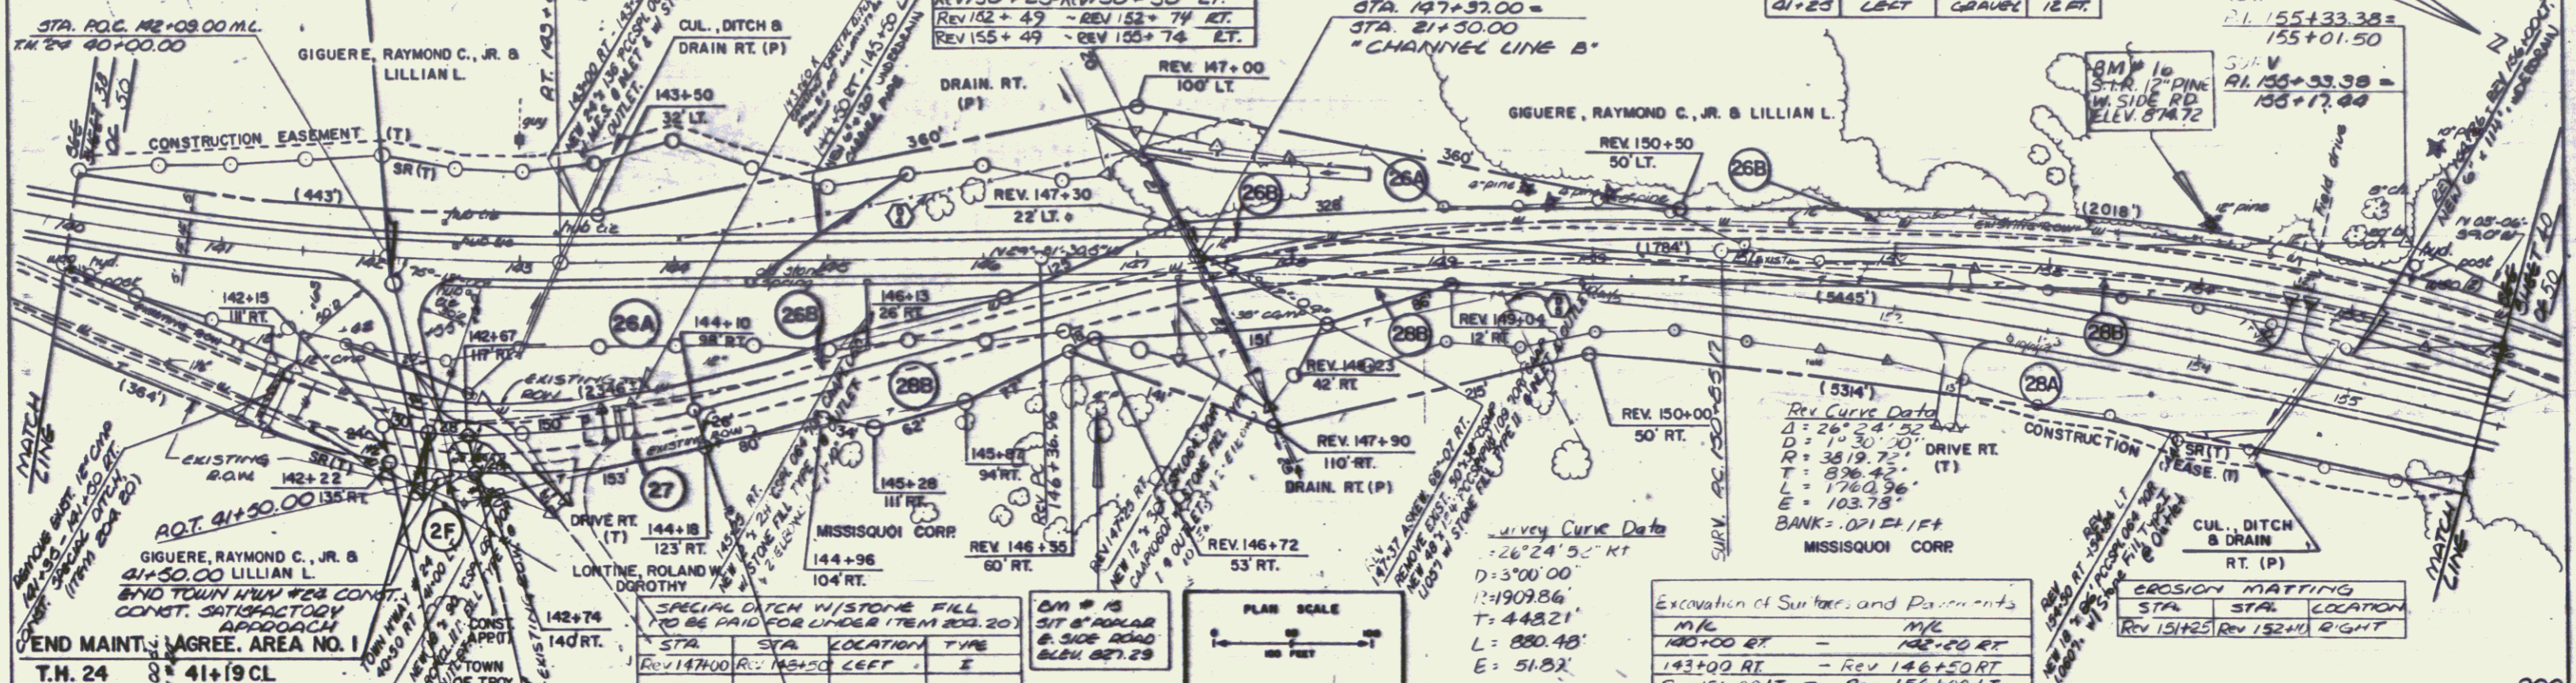

PLAN	DATE	BY	CHKD

END MAINT. AGREE. AREA NO. 1
 T.H. 24 41+19 CL

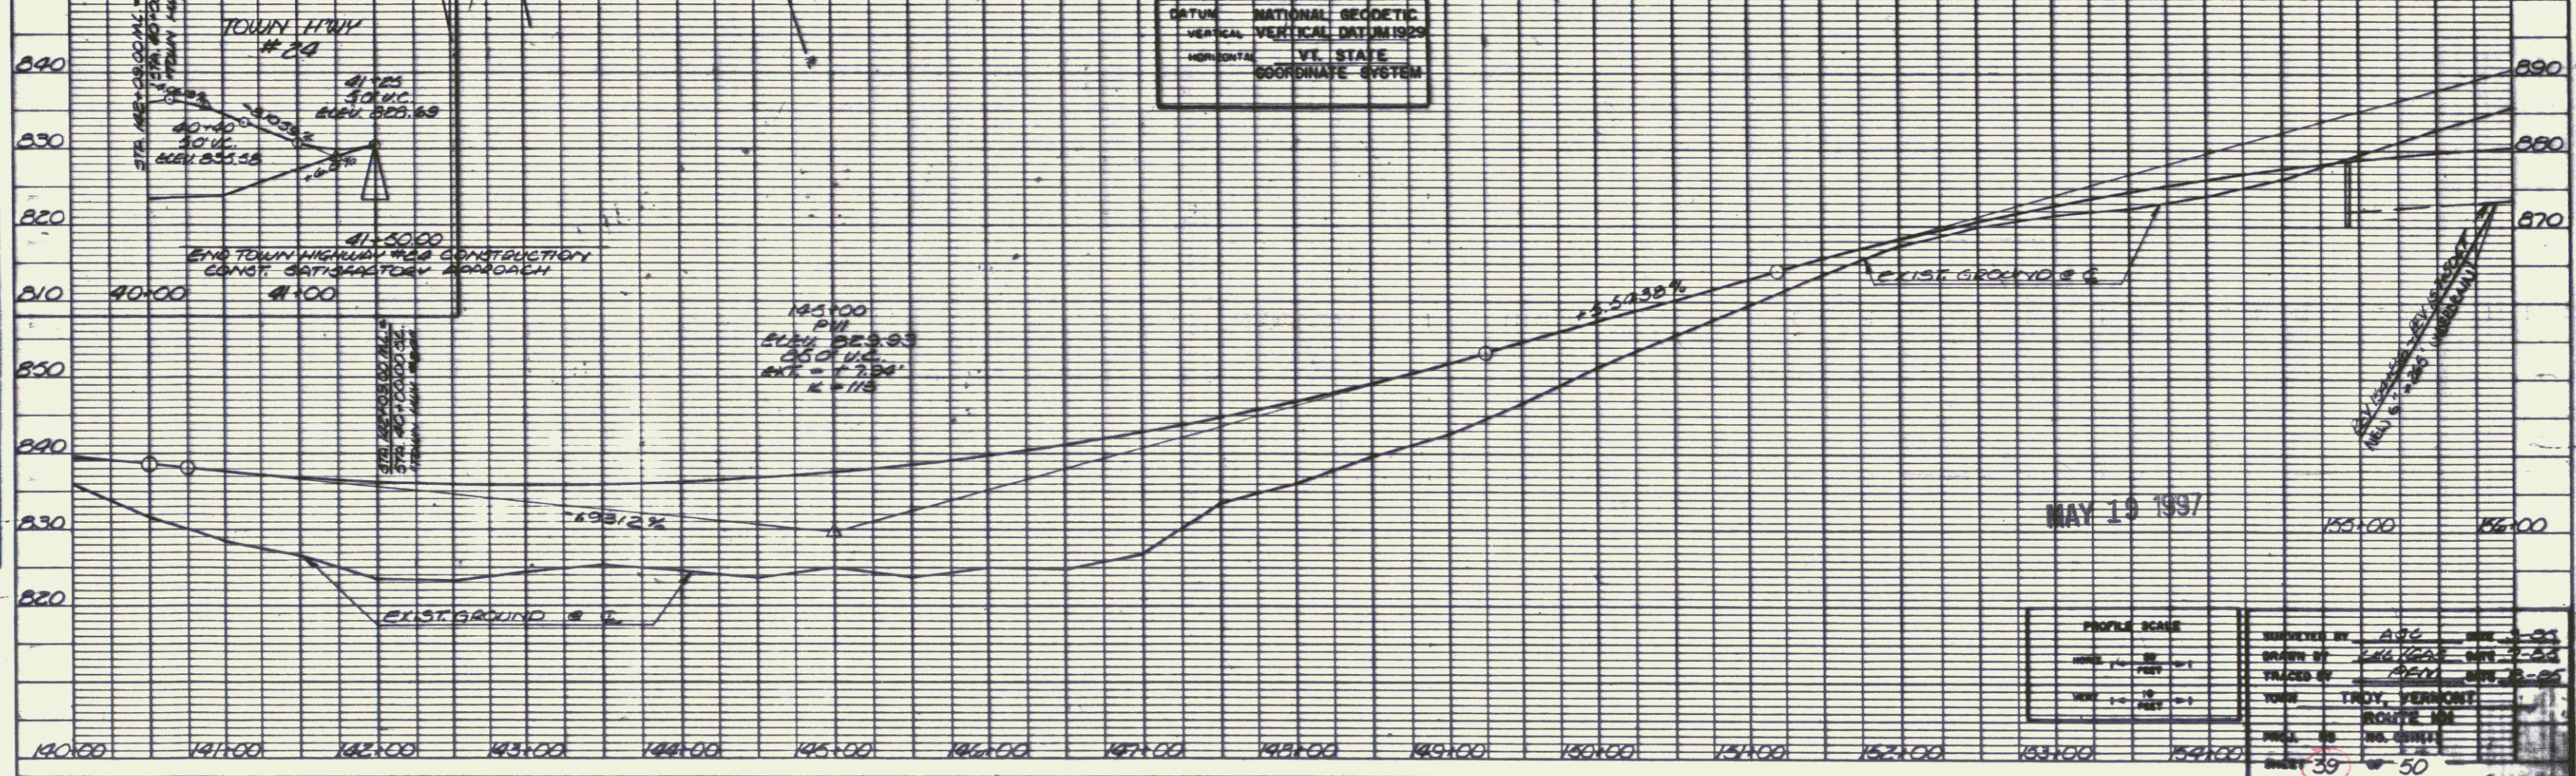

PROFILE	DATE	BY	CHKD

PLAN SCALE
 1" = 100 FEET

VERTICAL SCALE
 1" = 10 FEET

NATIONAL GEODETIC
 VERTICAL DATUM 1929
 VT. STATE
 COORDINATE SYSTEM

PROFILE SCALE
 1" = 10 FEET

DESIGNED BY: ABC DATE: 5-23
 DRAWN BY: DEF DATE: 5-24
 CHECKED BY: GHI DATE: 5-25
 TOWN: TROY, VERMONT
 ROUTE: 100
 SHEET 39 OF 50