
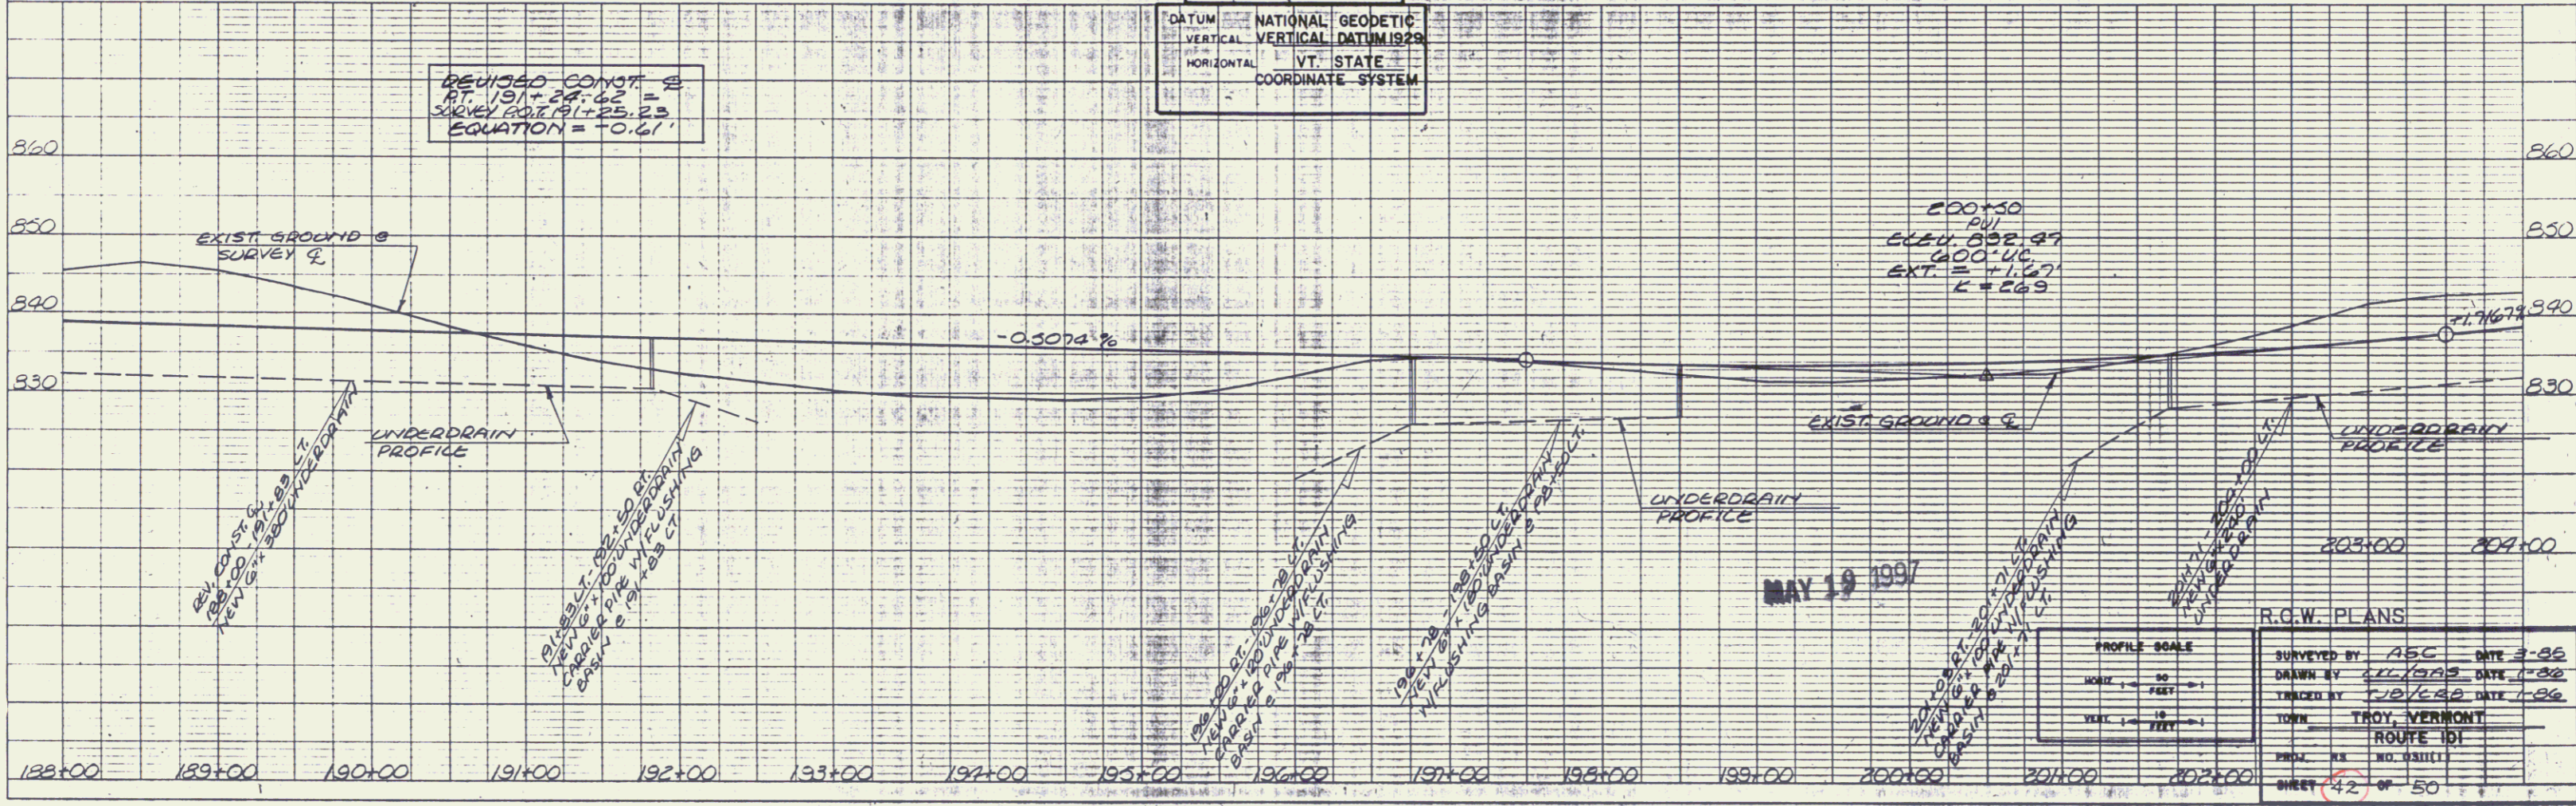


PLAN
 SURVEY
 NOTE BOOK

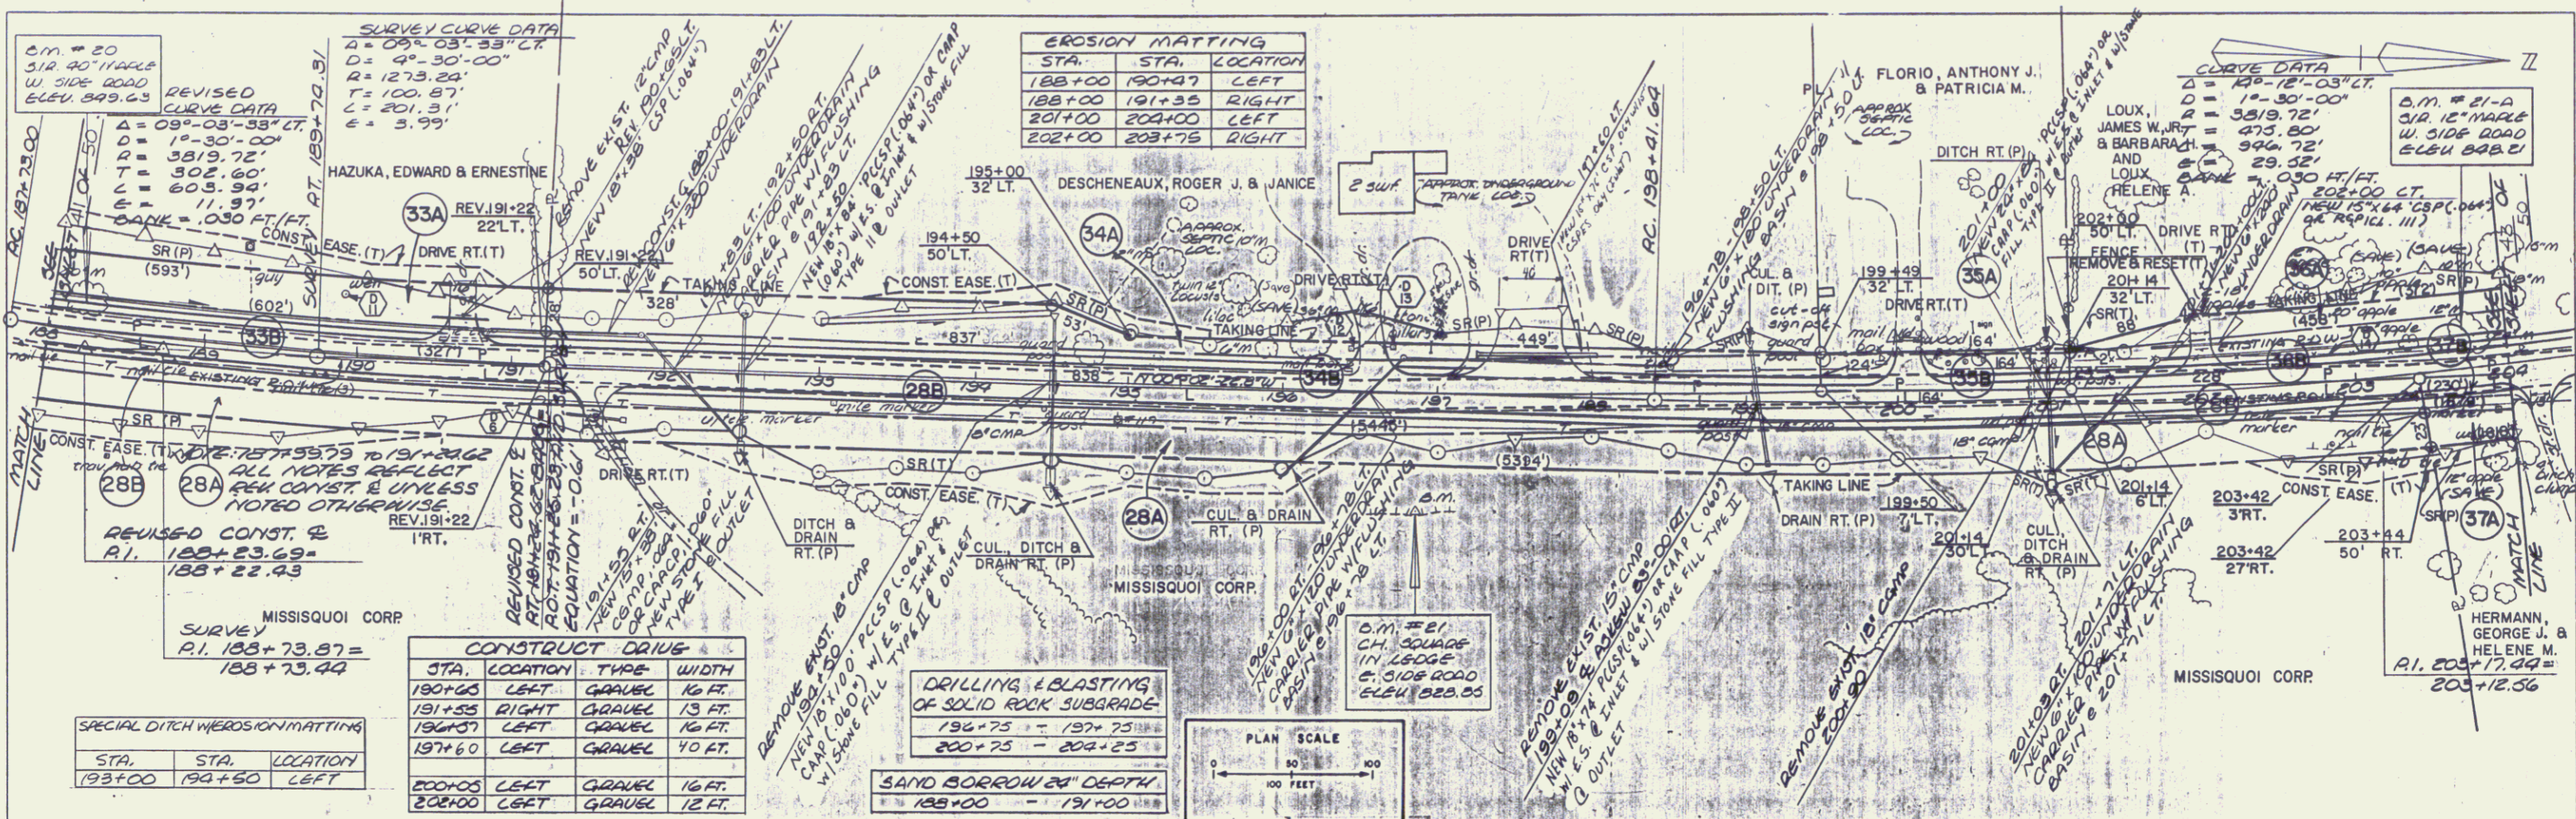

PROFILE
 SURVEY
 NOTE BOOK

| STA. | STA. | LOCATION |
|--------|--------|----------|
| 188+00 | 190+47 | LEFT |
| 188+00 | 191+35 | RIGHT |
| 201+00 | 204+00 | LEFT |
| 202+00 | 203+75 | RIGHT |

| STA. | LOCATION | TYPE | WIDTH |
|--------|----------|--------|--------|
| 190+60 | LEFT | GRAVEL | 16 FT. |
| 191+35 | RIGHT | GRAVEL | 13 FT. |
| 196+07 | LEFT | GRAVEL | 16 FT. |
| 197+60 | LEFT | GRAVEL | 10 FT. |
| 200+00 | LEFT | GRAVEL | 16 FT. |
| 202+00 | LEFT | GRAVEL | 12 FT. |

| STA. | STA. | LOCATION |
|--------|--------|----------|
| 193+00 | 194+50 | LEFT |

VERTICAL NATIONAL GEODETIC
 HORIZONTAL VT. STATE
 DATUM 1929
 COORDINATE SYSTEM

PROFILE SCALE
 HORIZ. 1" = 50'
 VERT. 1" = 10'
 YEAR 1997

R.G.W. PLANS
 SURVEYED BY ASC DATE 3-86
 DRAWN BY JLL DATE 7-86
 CHECKED BY JTB DATE 1-86
 TOWN TROY, VERMONT
 ROUTE 101
 SHEET 42 OF 50