

PLAN
NOTE BOOK
NO.

PROFILE
NOTE BOOK
NO.

STA.	STA.	LOCATION
220+00	221+25	LT
221+80	223+80	LT


STA.	STA.	LOCATION
220+00	224+05	RT

STA.	LOCATION	TYPE	WIDTH
REV 222+31	LEFT	GRAVEL	12 FT
REV 225+82	RIGHT	GRAVEL	12 FT
REV 225+80	LEFT	GRAVEL	37 FT
REV 232+35	RIGHT	GRAVEL	13 FT
REV 235+21	LEFT	GRAVEL	12 FT

STA.	STA.	LOCATION
234+50	236+00	RIGHT

CURVE DATA
 $\Delta = 37^\circ - 44' - 51''$ RT
 $D = 1^\circ - 35' - 00''$
 $R = 3618.65$
 $T = 1237.10'$
 $L = 2350.05'$
 $E = 205.62'$
 $BANK = 0.30$ FEET

DATUM NATIONAL GEODETIC
 VERTICAL VERTICAL DATUM 1929
 HORIZONTAL VT. STATE
 COORDINATE SYSTEM

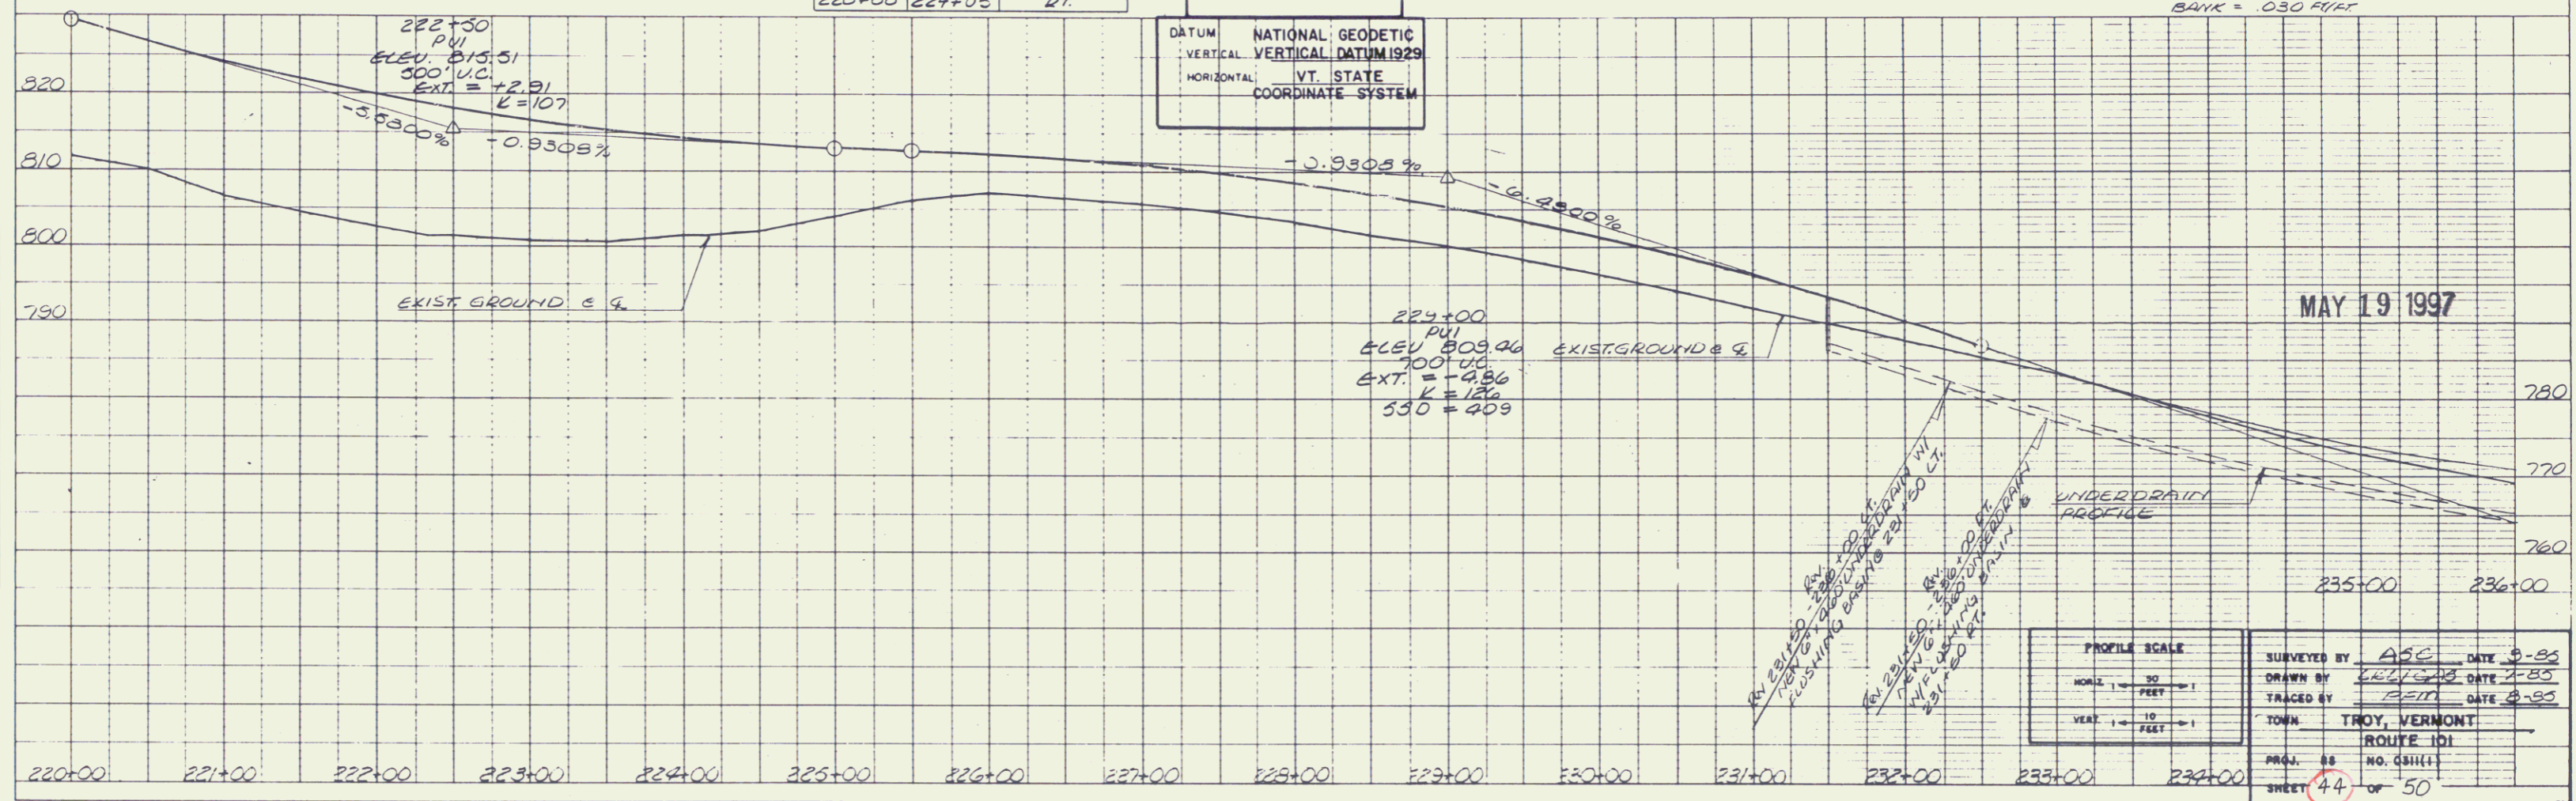

MAY 19 1997

HORIZ	1" = 50 FEET
VERT	1" = 10 FEET

SURVEYED BY ASC DATE 8-85
 DRAWN BY LEWIS DATE 7-85
 TRACED BY CSM DATE 8-85
 TOWN TROY, VERMONT
 ROUTE 101
 PROJ. 88 NO. 03111
 SHEET 44 OF 50

PLATE PLAN/PROFILE & A & B STANDARD
 047208H CORPORATION
 1987-11-23