


PLAN  
 SHEET NO. 45 OF 50  
 DATE: MAY 19 1997

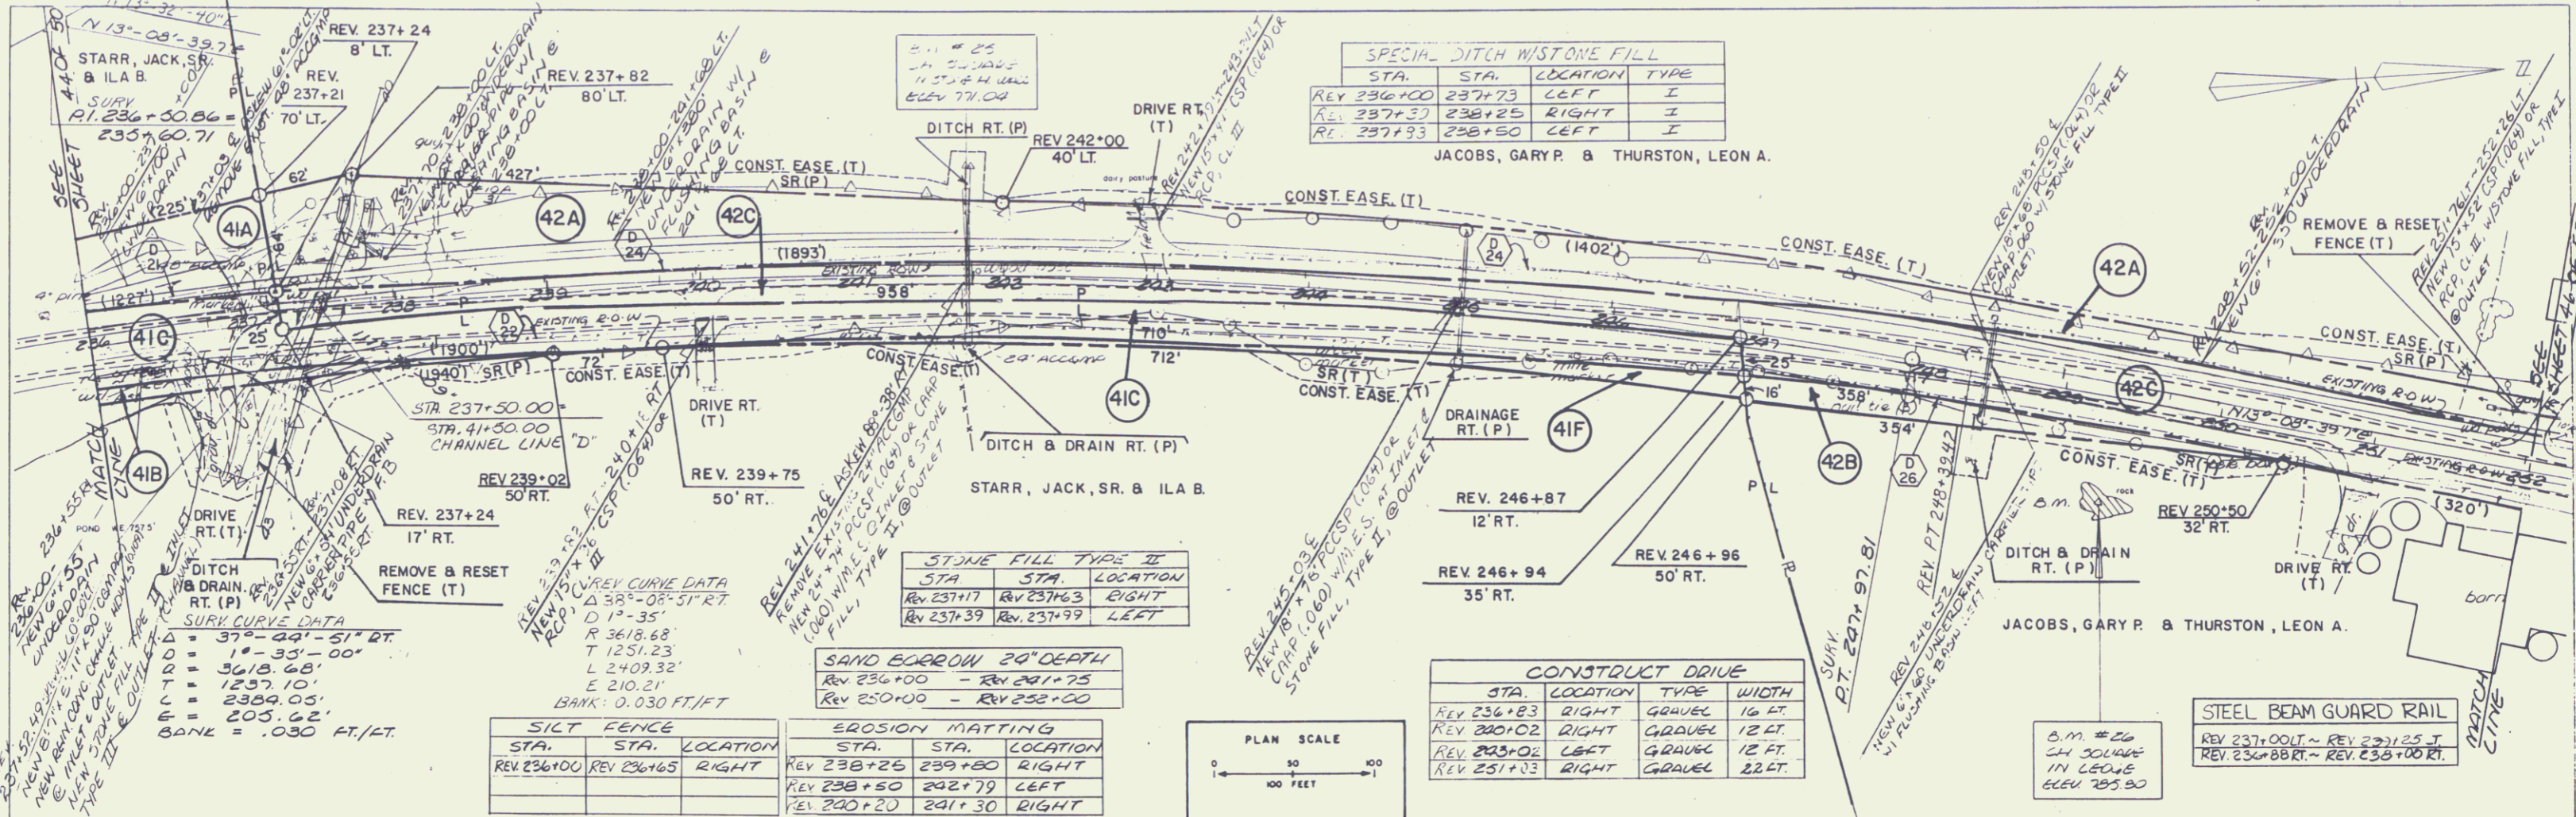

SPECIAL DITCH W/STONE FILL

STA.	STA.	LOCATION	TYPE
REV 236+00	237+73	LEFT	I
REV 237+37	238+25	RIGHT	I
REV 237+93	238+50	LEFT	I

JACOBS, GARY P. & THURSTON, LEON A.

STONE FILL TYPE II

STA.	STA.	LOCATION
REV 237+17	REV 237+63	RIGHT
REV 237+39	REV 237+99	LEFT

SAND BORROW 24" DEPTH

REV 236+00	REV 241+75
REV 250+00	REV 252+00

SILT FENCE


STA.	STA.	LOCATION
REV 236+00	REV 236+65	RIGHT

EROSION MATTING


STA.	STA.	LOCATION
REV 238+25	239+80	RIGHT
REV 238+50	242+79	LEFT
REV 240+20	241+30	RIGHT

CONSTRUCT DRIVE

STA.	LOCATION	TYPE	WIDTH
REV 236+83	RIGHT	GRAVEL	16 FT.
REV 240+02	RIGHT	GRAVEL	12 FT.
REV 240+02	LEFT	GRAVEL	12 FT.
REV 251+03	RIGHT	GRAVEL	22 FT.

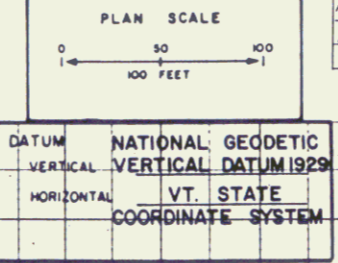

PROFILE  
 SHEET NO. 45 OF 50  
 DATE: MAY 19 1997

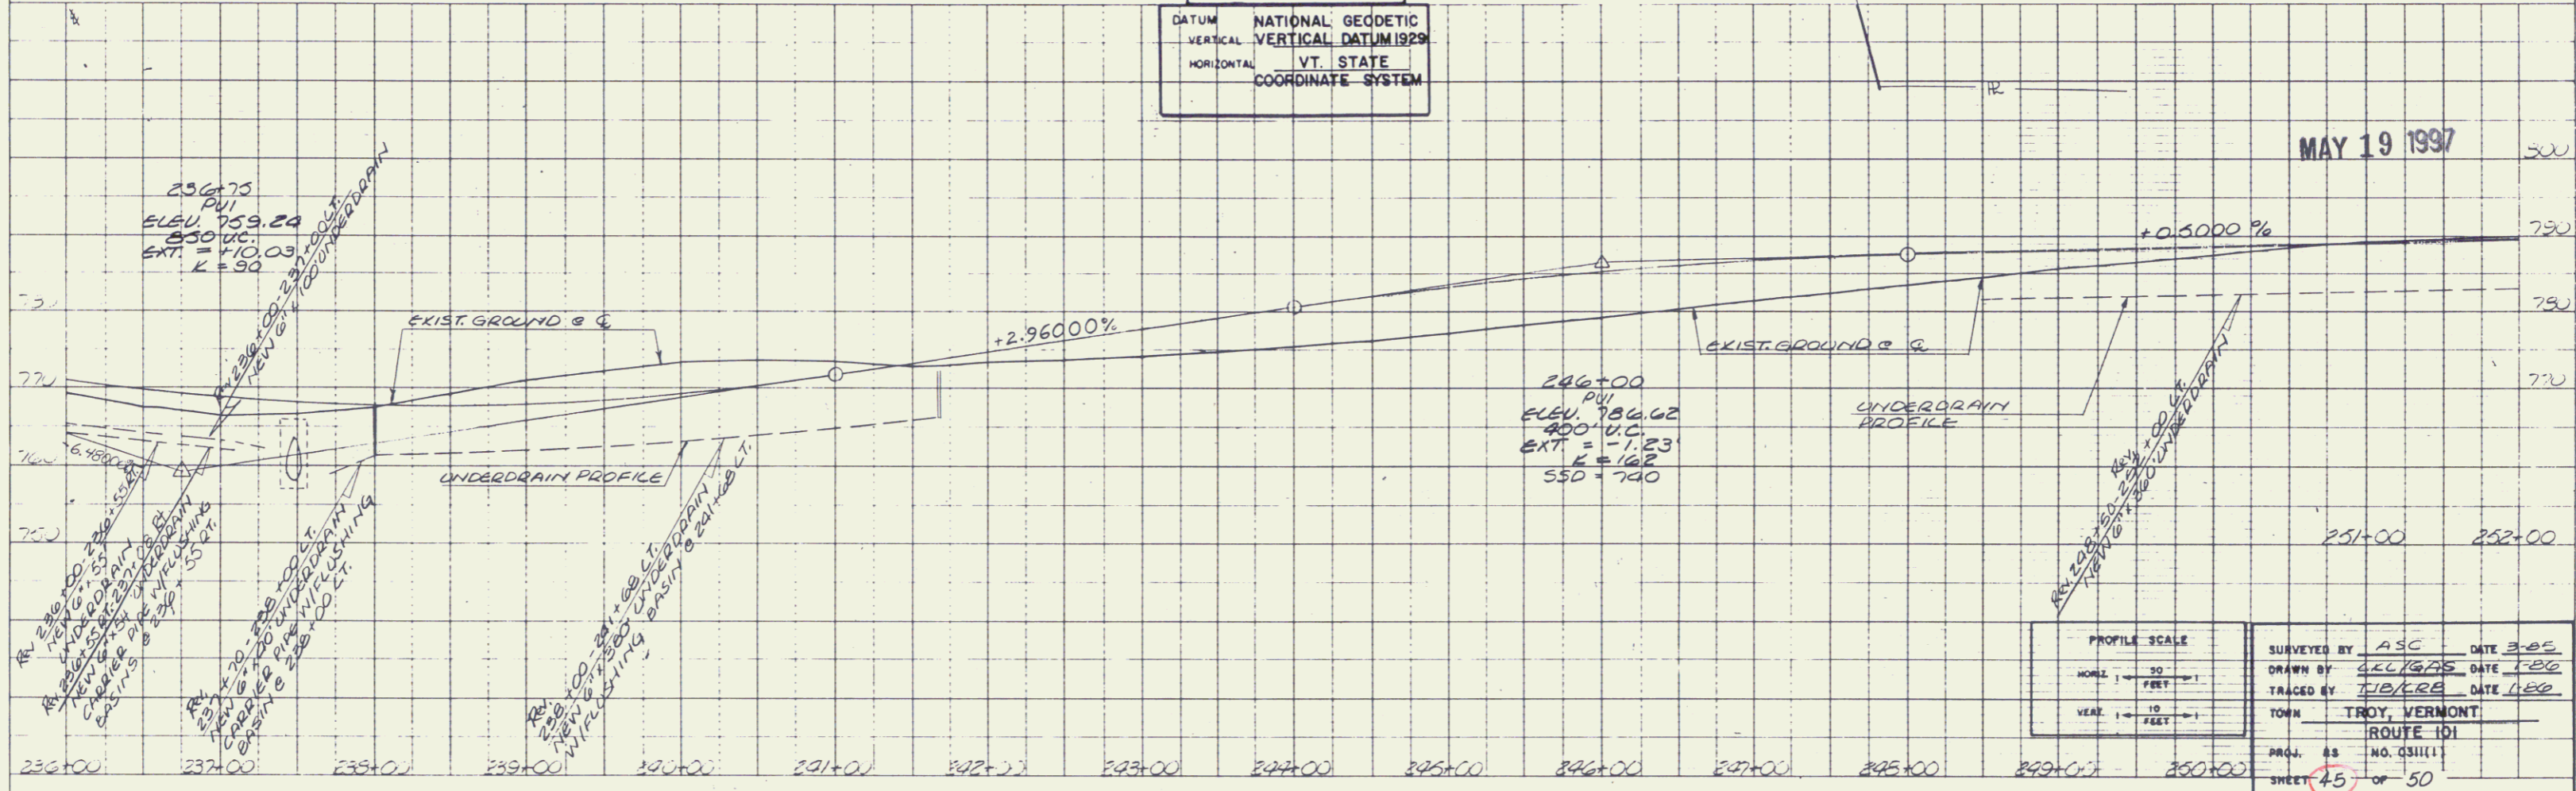

PROFILE SCALE

HORIZ.	1" = 50'
VERT.	1" = 10'

SURVEYED BY: ASC DATE: 3-85  
 DRAWN BY: JEL/GAS DATE: 1-86  
 TRACED BY: JTB/CRB DATE: 1-86  
 TOWN: TROY, VERMONT  
 PROJ. NO. 0311(1)  
 SHEET 45 OF 50

PLATE PLAN PROFILE © P. & S. T. STANDING  
 41 JACKSON ST. COLVER, VT.  
 05101-0000