


PLAN
NOTE BOOK
NO.

PROFILE
NOTE BOOK
NO.

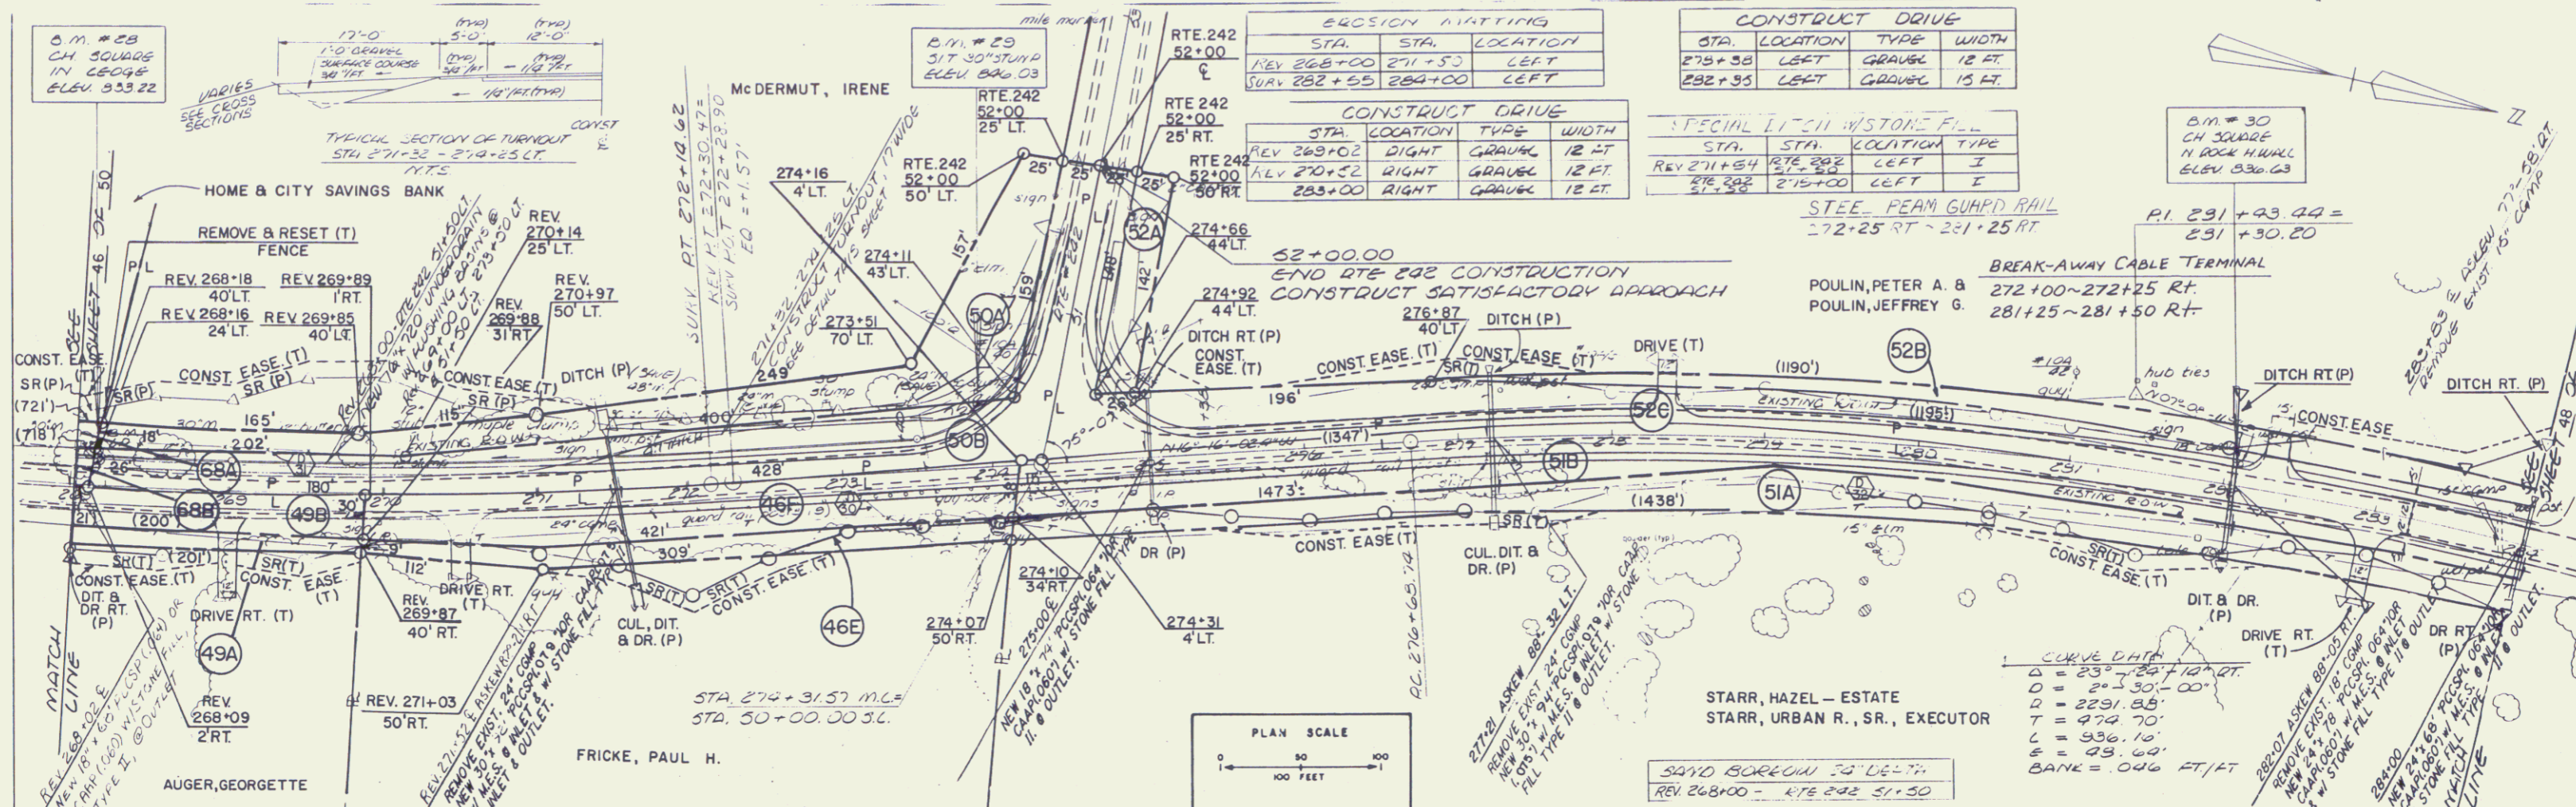


SECTION MATING			
STA.	STA.	LOCATION	
KEY 268+00	271+50	LEFT	
SUA 282+55	284+00	LEFT	


CONSTRUCT DRIVE			
STA.	LOCATION	TYPE	WIDTH
273+38	LEFT	GRAVEL	12 FT.
282+95	LEFT	GRAVEL	15 FT.

CONSTRUCT DRIVE			
STA.	LOCATION	TYPE	WIDTH
REV 269+02	DITCH	GRAVEL	12 FT.
KEY 270+52	RIGHT	GRAVEL	12 FT.
283+00	RIGHT	GRAVEL	12 FT.

SPECIAL LITCHI W/STONE FILL			
STA.	STA.	LOCATION	TYPE
REV 271+84	REV 282	LEFT	I
276+82	275+00	LEFT	I

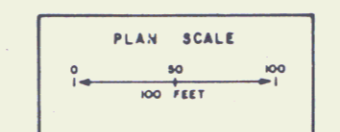

DATUM NATIONAL GEODETIC VERTICAL DATUM 1929
HORIZONTAL VT. STATE COORDINATE SYSTEM

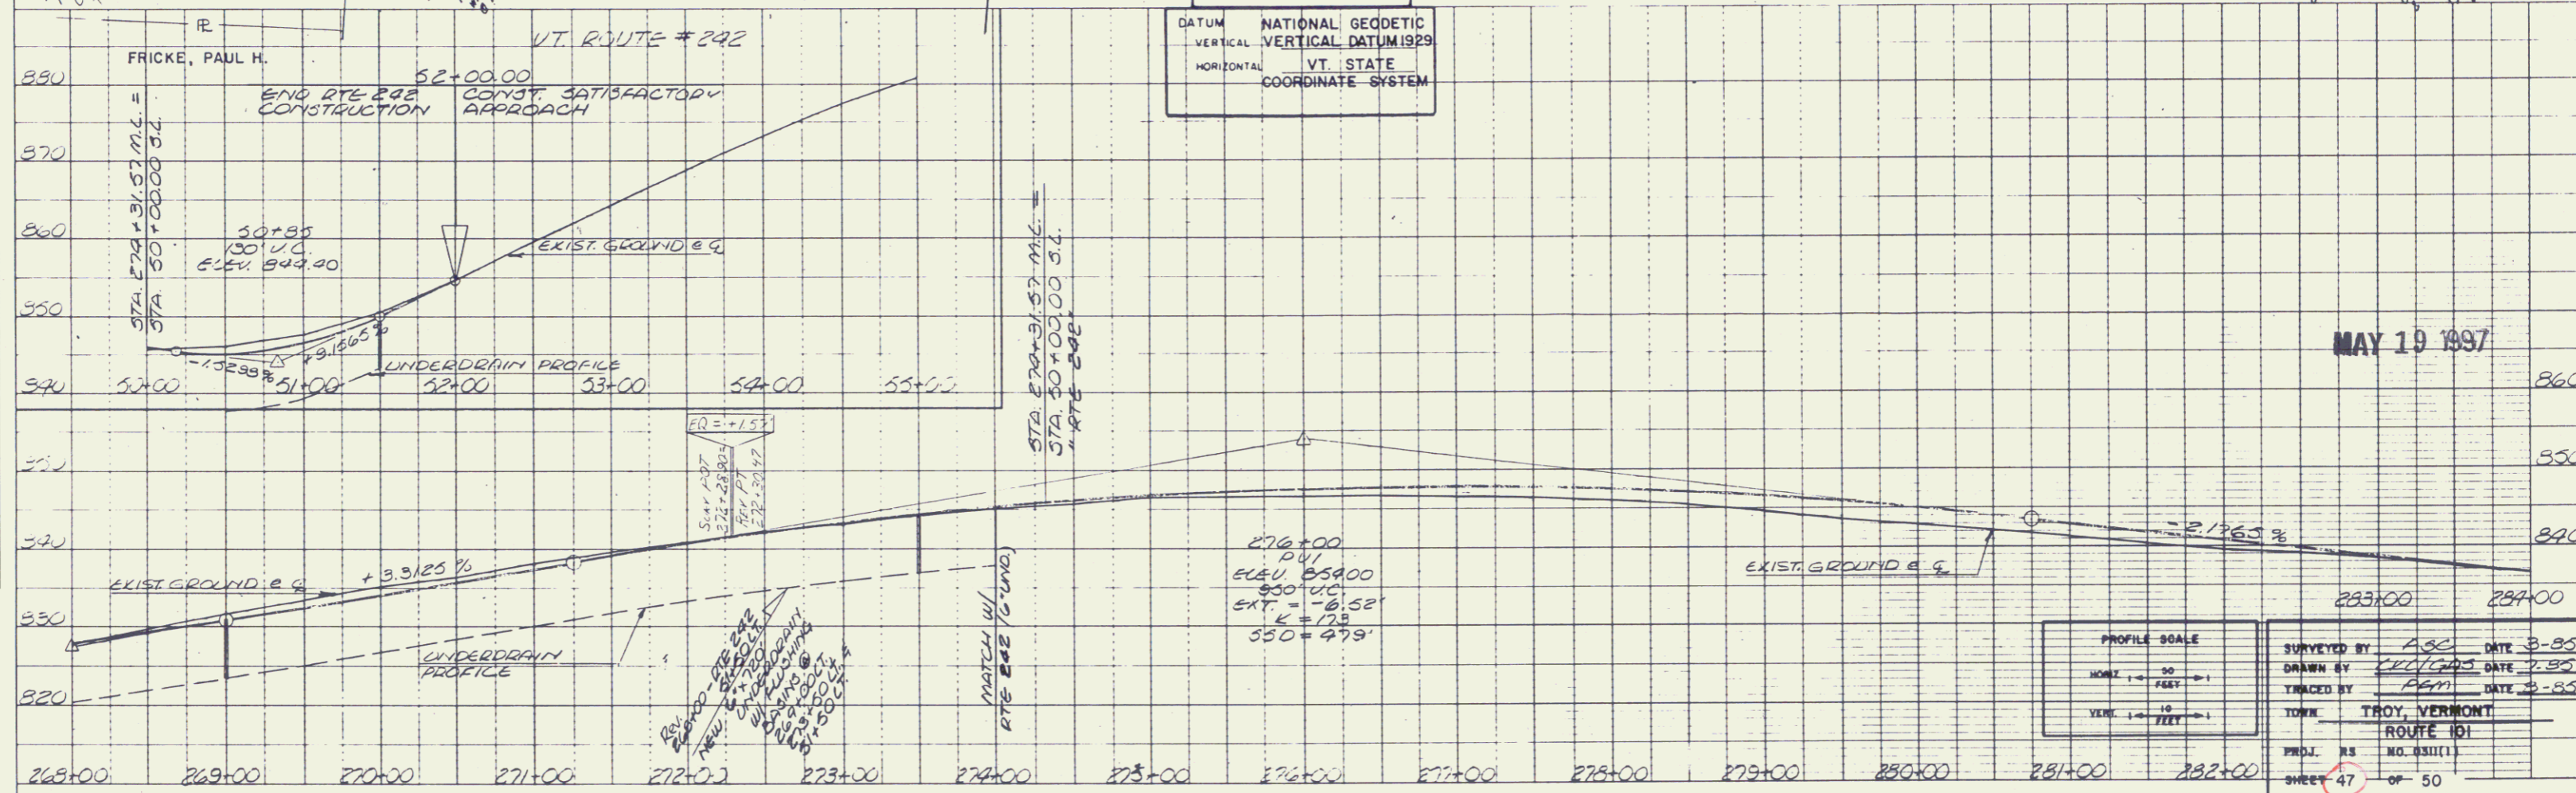

PROFILE SCALE		SURVEYED BY		DATE
HORIZ	1" = 50 FEET	AGE		3-85
VERT	1" = 10 FEET	DRAWN BY	AGE	2-85
		CHECKED BY	AGE	2-85
		TITLE	TROY, VERMONT ROUTE 101	
		PROJ. NO.	NO. 0311(1)	
		SHEET	47 OF 50	

PLATE 1 PLAN PROFILE OF P. & S. I. STANDARD DATUM 1929

MAY 19 1997