



CONSTRUCT DRIVE			
STA.	LOCATION	TYPE	WIDTH
159+36	LEFT	GRAVEL	12 FT.
160+82	LEFT	GRAVEL	16 FT.
170+40	LEFT	GRAVEL	16 FT.

TREATED TIMBER CURB		
STA.	STA.	LOCATION
165+00	172+00	RT.

CABLE GUARD RAIL	
STA.	LOCATION
165+00	RT. ~ 172+00

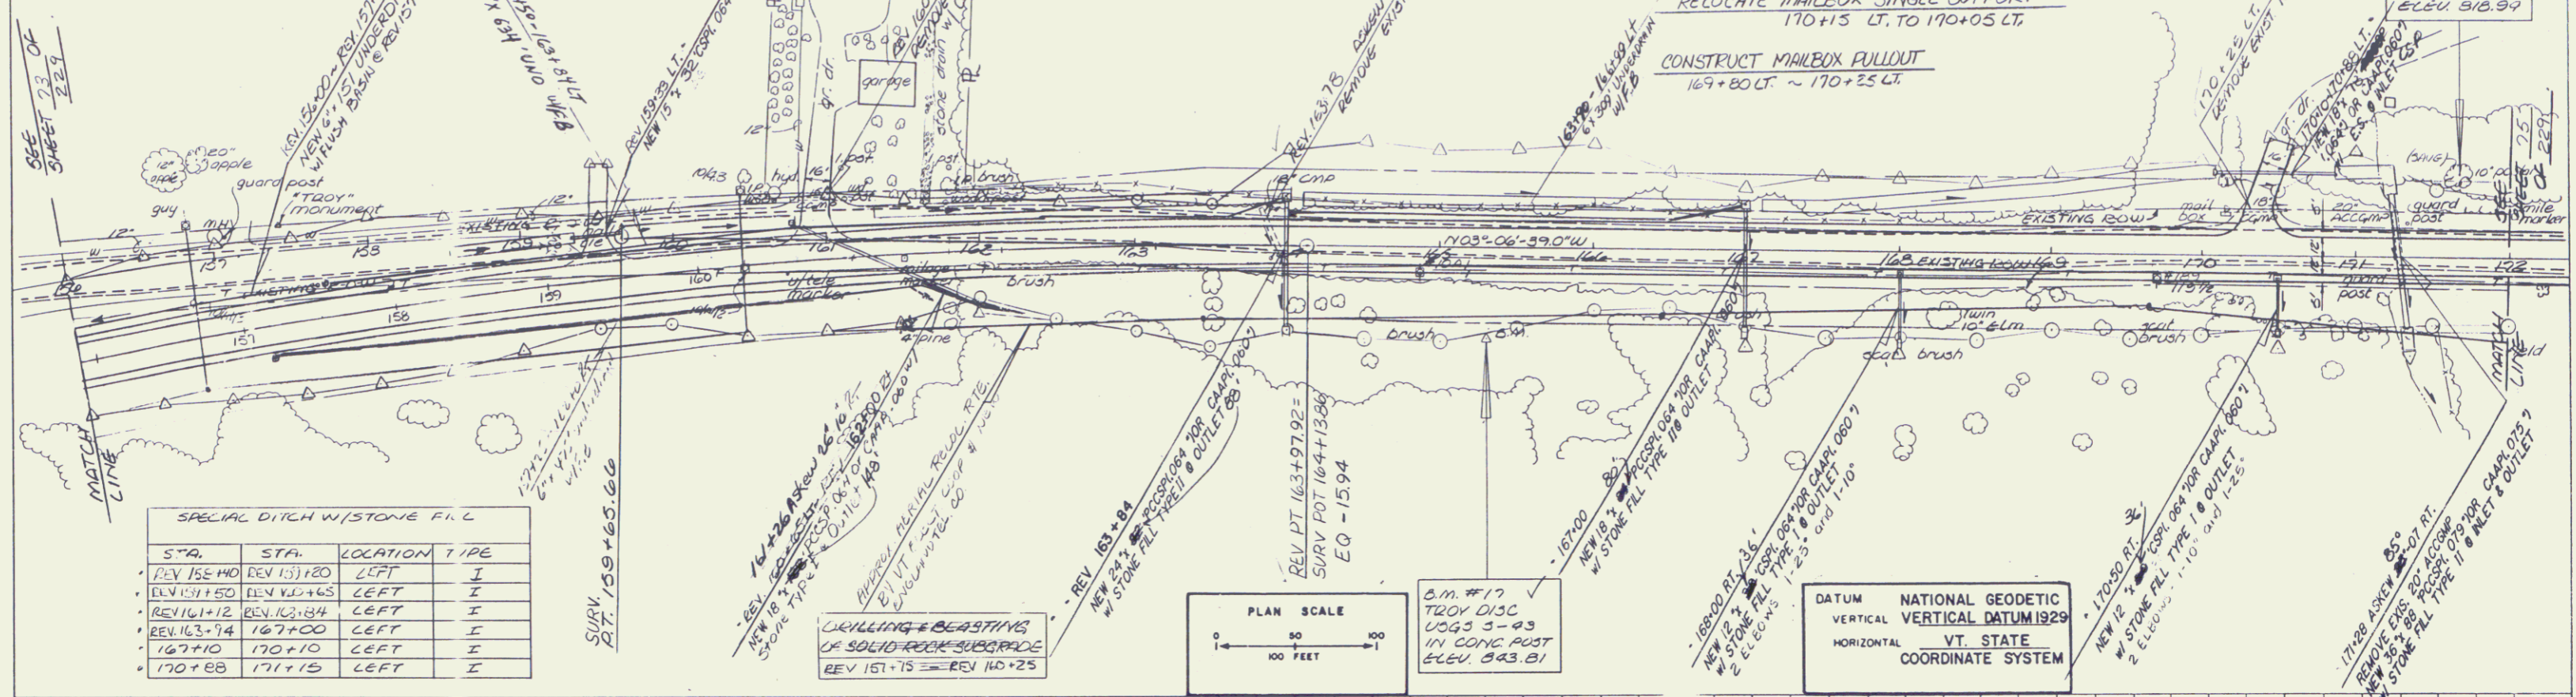


SPECIAL DITCH W/STONE FILL			
STA.	STA.	LOCATION	TYPE
REV 158+40	REV 153+80	LEFT	I
REV 151+50	REV 142+65	LEFT	I
REV 161+12	REV 153+84	LEFT	I
REV 163+74	REV 170+00	LEFT	I
REV 167+10	REV 170+10	LEFT	I
REV 170+88	REV 171+15	LEFT	I

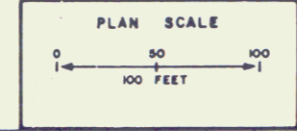

DATUM NATIONAL GEODETIC
 VERTICAL VERTICAL DATUM 1929
 HORIZONTAL VT. STATE
 COORDINATE SYSTEM

PLAN
 NOTE BOOK
 NO.

PROFILE
 NOTE BOOK
 NO.

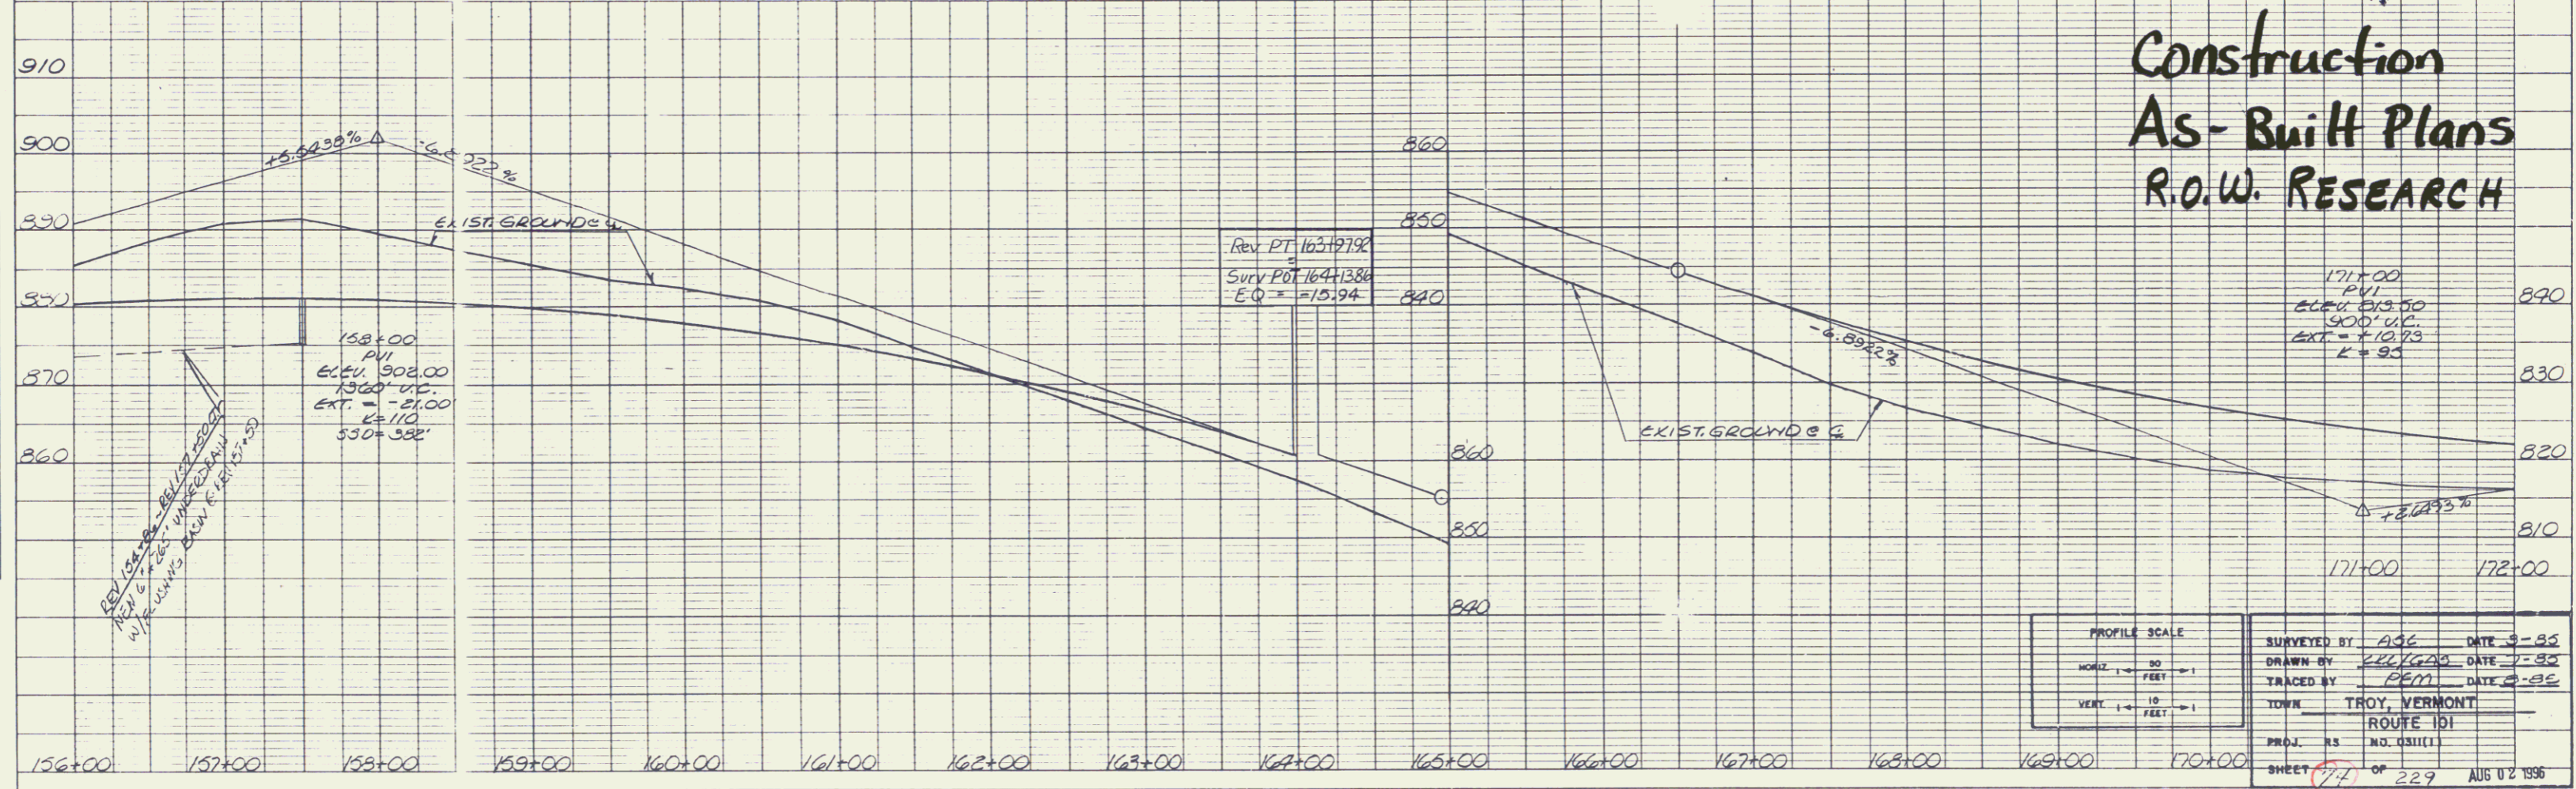

Construction As-Built Plans R.O.W. RESEARCH

PROFILE SCALE HORIZ. 1" = 50 FEET VERT. 1" = 10 FEET	SURVEYED BY: AGC DATE: 3-93 DRAWN BY: EJC/AGC DATE: 7-93 TRACED BY: PEM DATE: 8-93 TOWN: TROY, VERMONT PROJ. NO. ROUTE 101 SHEET 77 OF 229
--	---

PLATE 1 PLAN PROFILE D.P. & A.S.I. STANDARD
 OF THE CORPORATION
 PRINTED IN U.S.A.