

PLAN
NOTE BOOK
NO.

PROFILE
NOTE BOOK
NO.

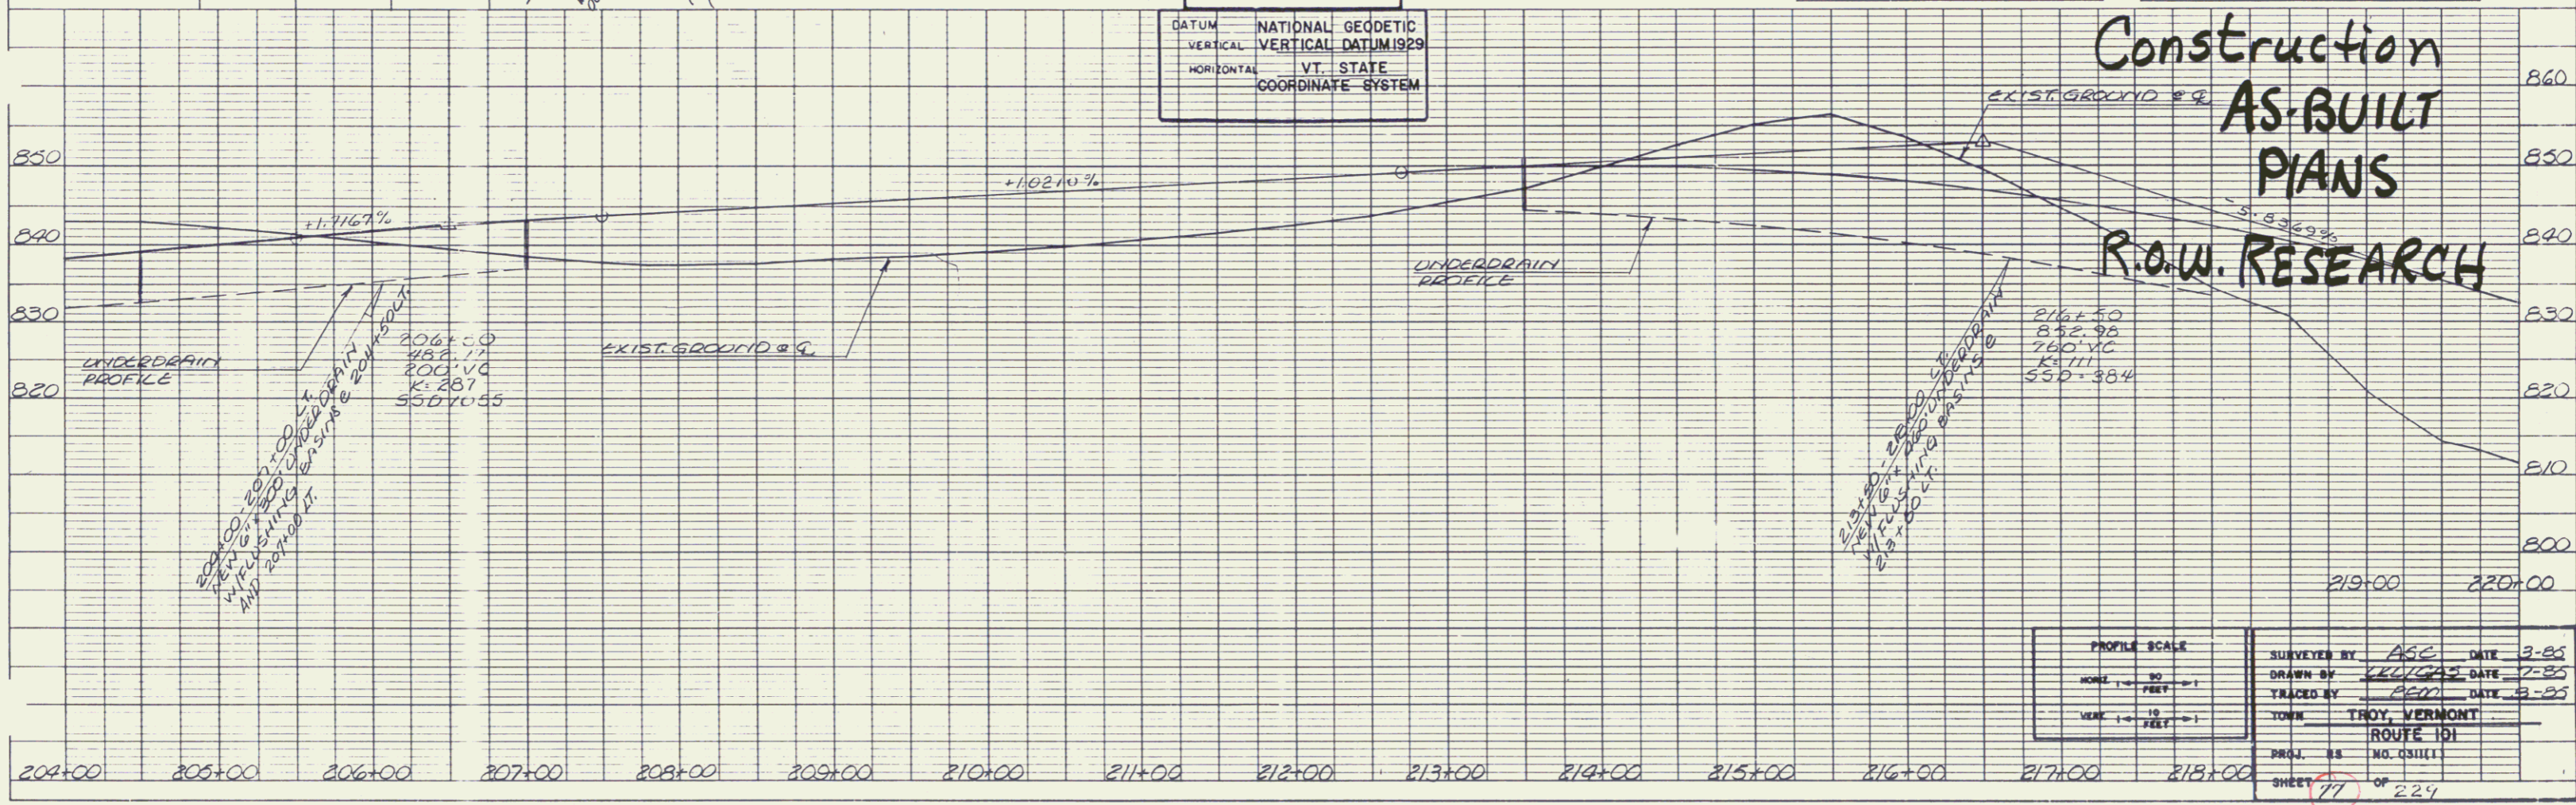
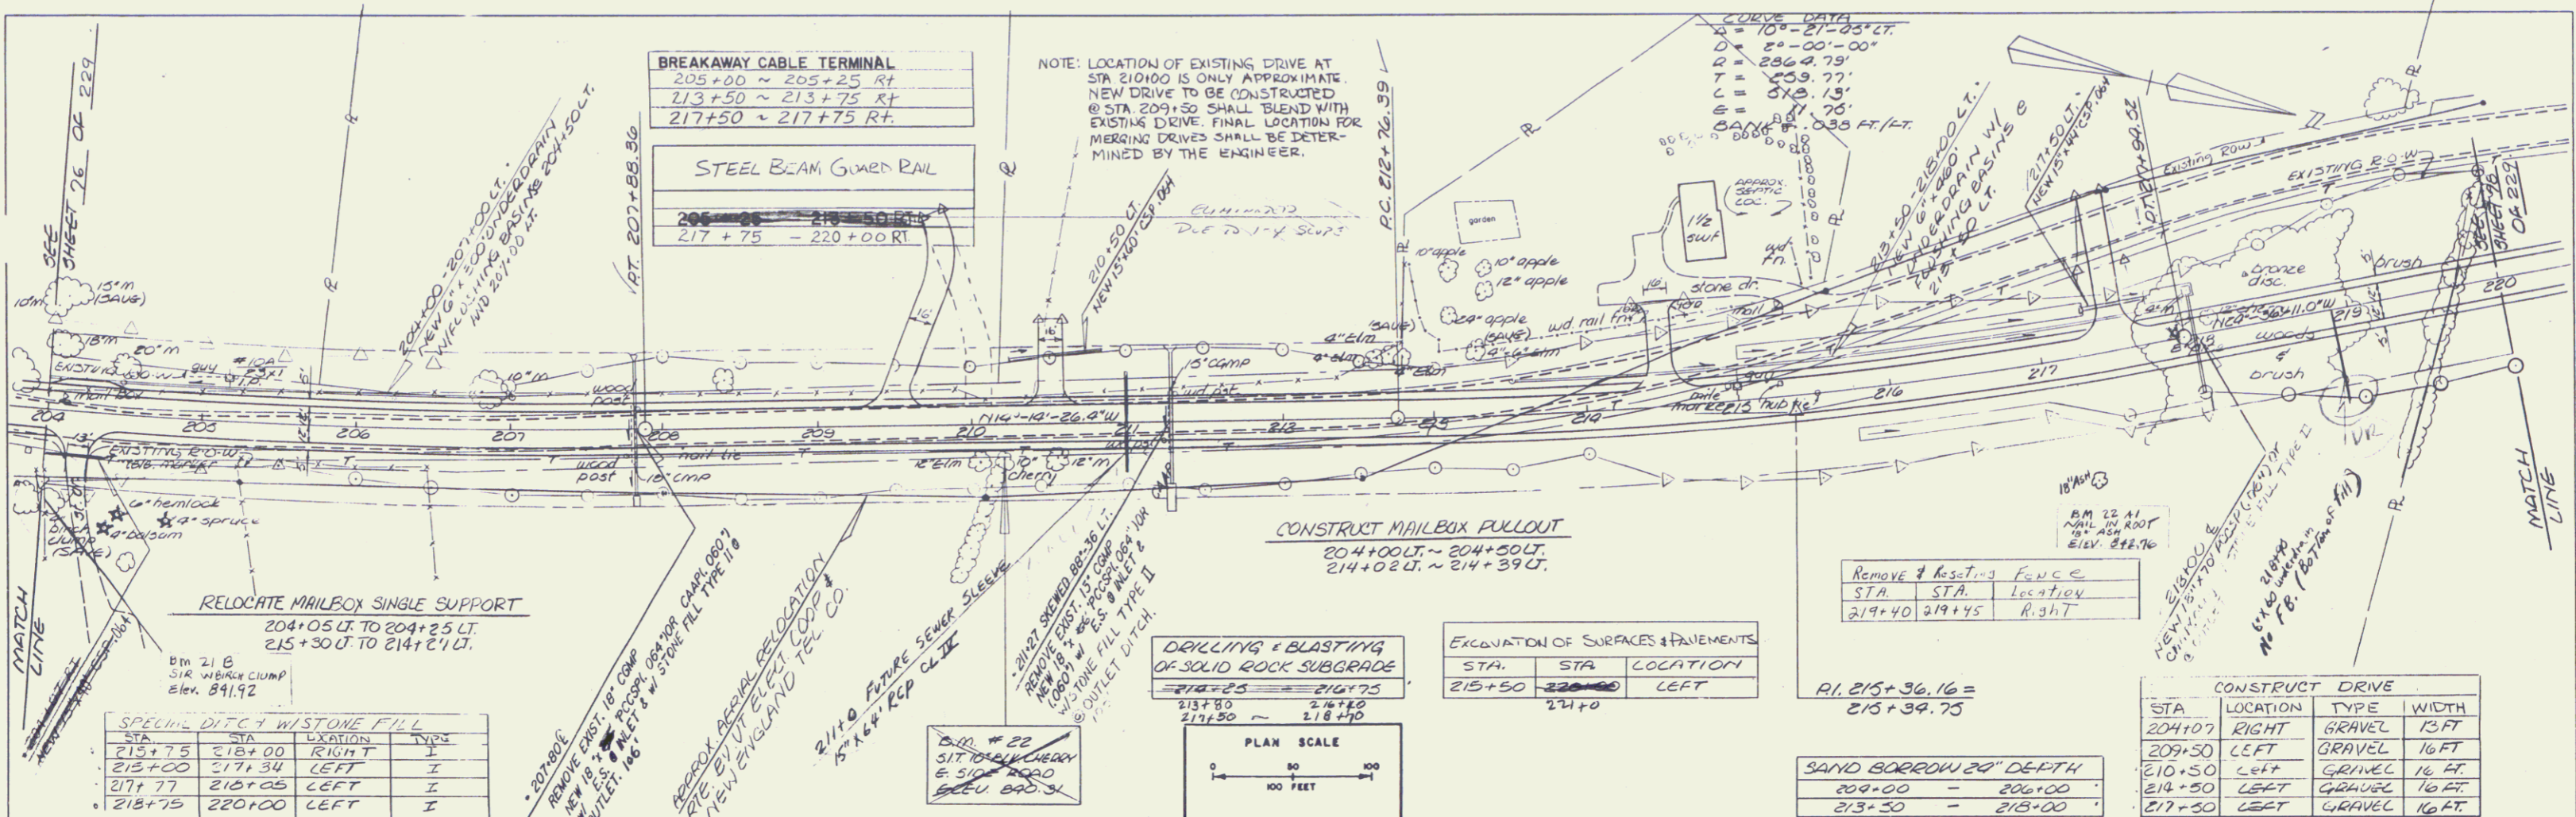


PLATE 1 PLAN PROFILE OF P. A. & E. STANDARD
DESIGN CORPORATION
LITTLETON, CO.

AUG 02 1996

59