
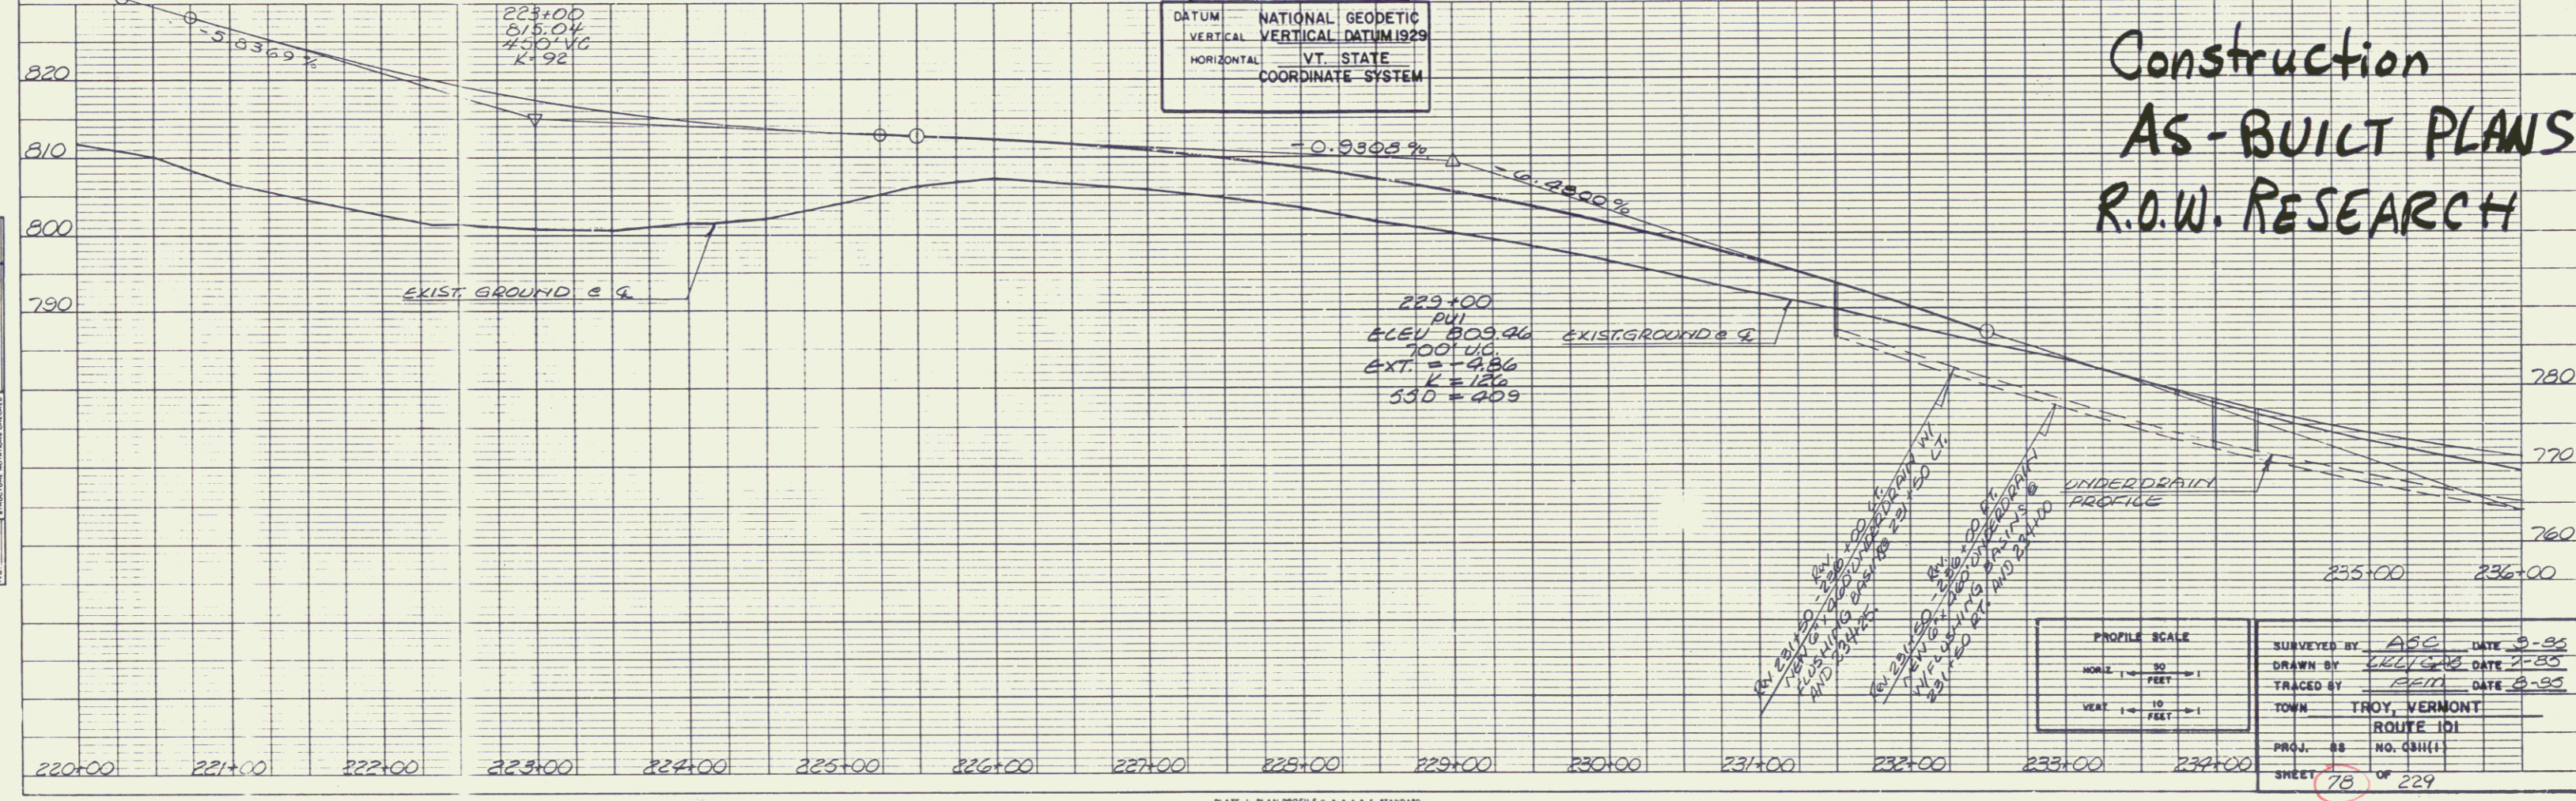


PLAN  
 SHEET NO. 78 OF 229  
 DATE: \_\_\_\_\_

PROFILE  
 SHEET NO. 78 OF 229  
 DATE: \_\_\_\_\_

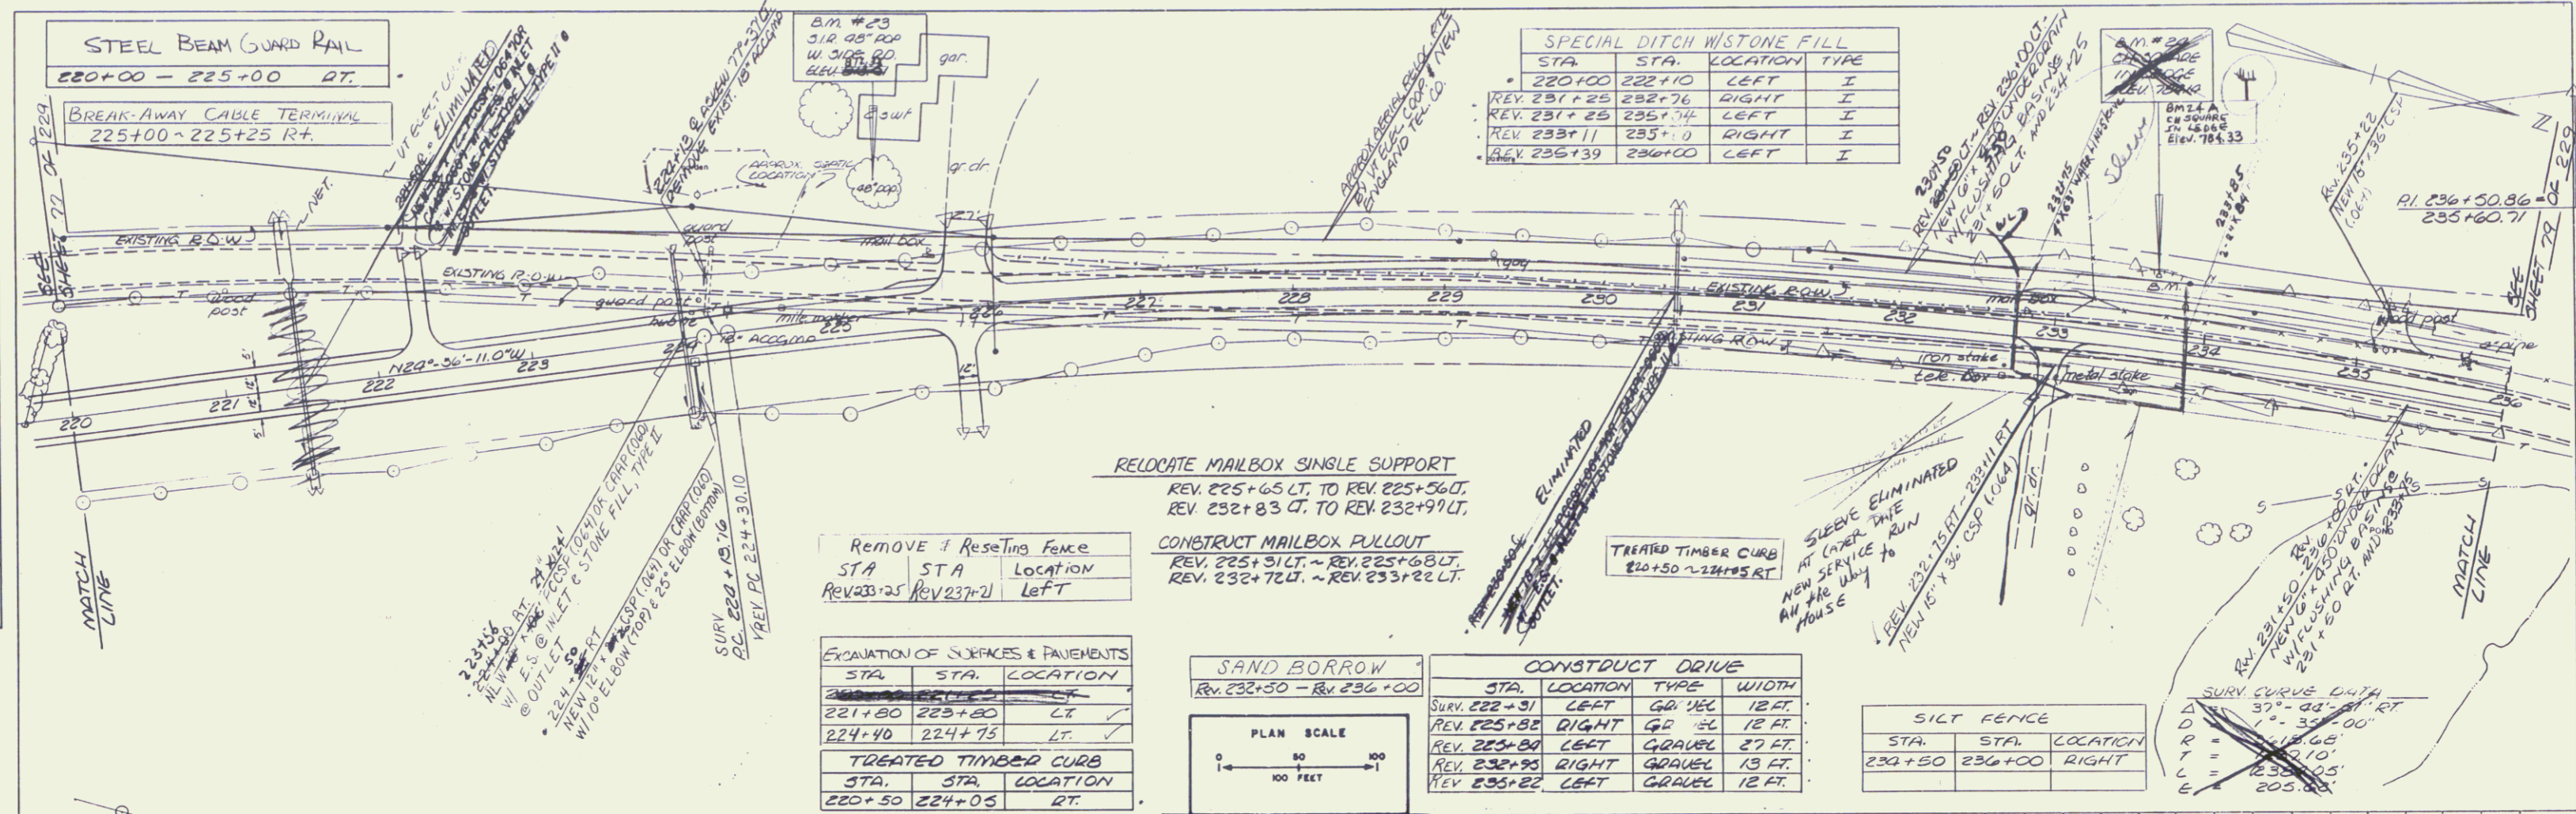

Construction  
 AS-BUILT PLANS  
 R.O.W. RESEARCH

PLATE 1 PLAN PROFILE P.S.S.S. STANDARD  
 PRINTED IN U.S.A.

AUG 02 1996

60