


PLAN
 NOTE BOOK
 NO.

PROFILE
 NOTE BOOK
 NO.

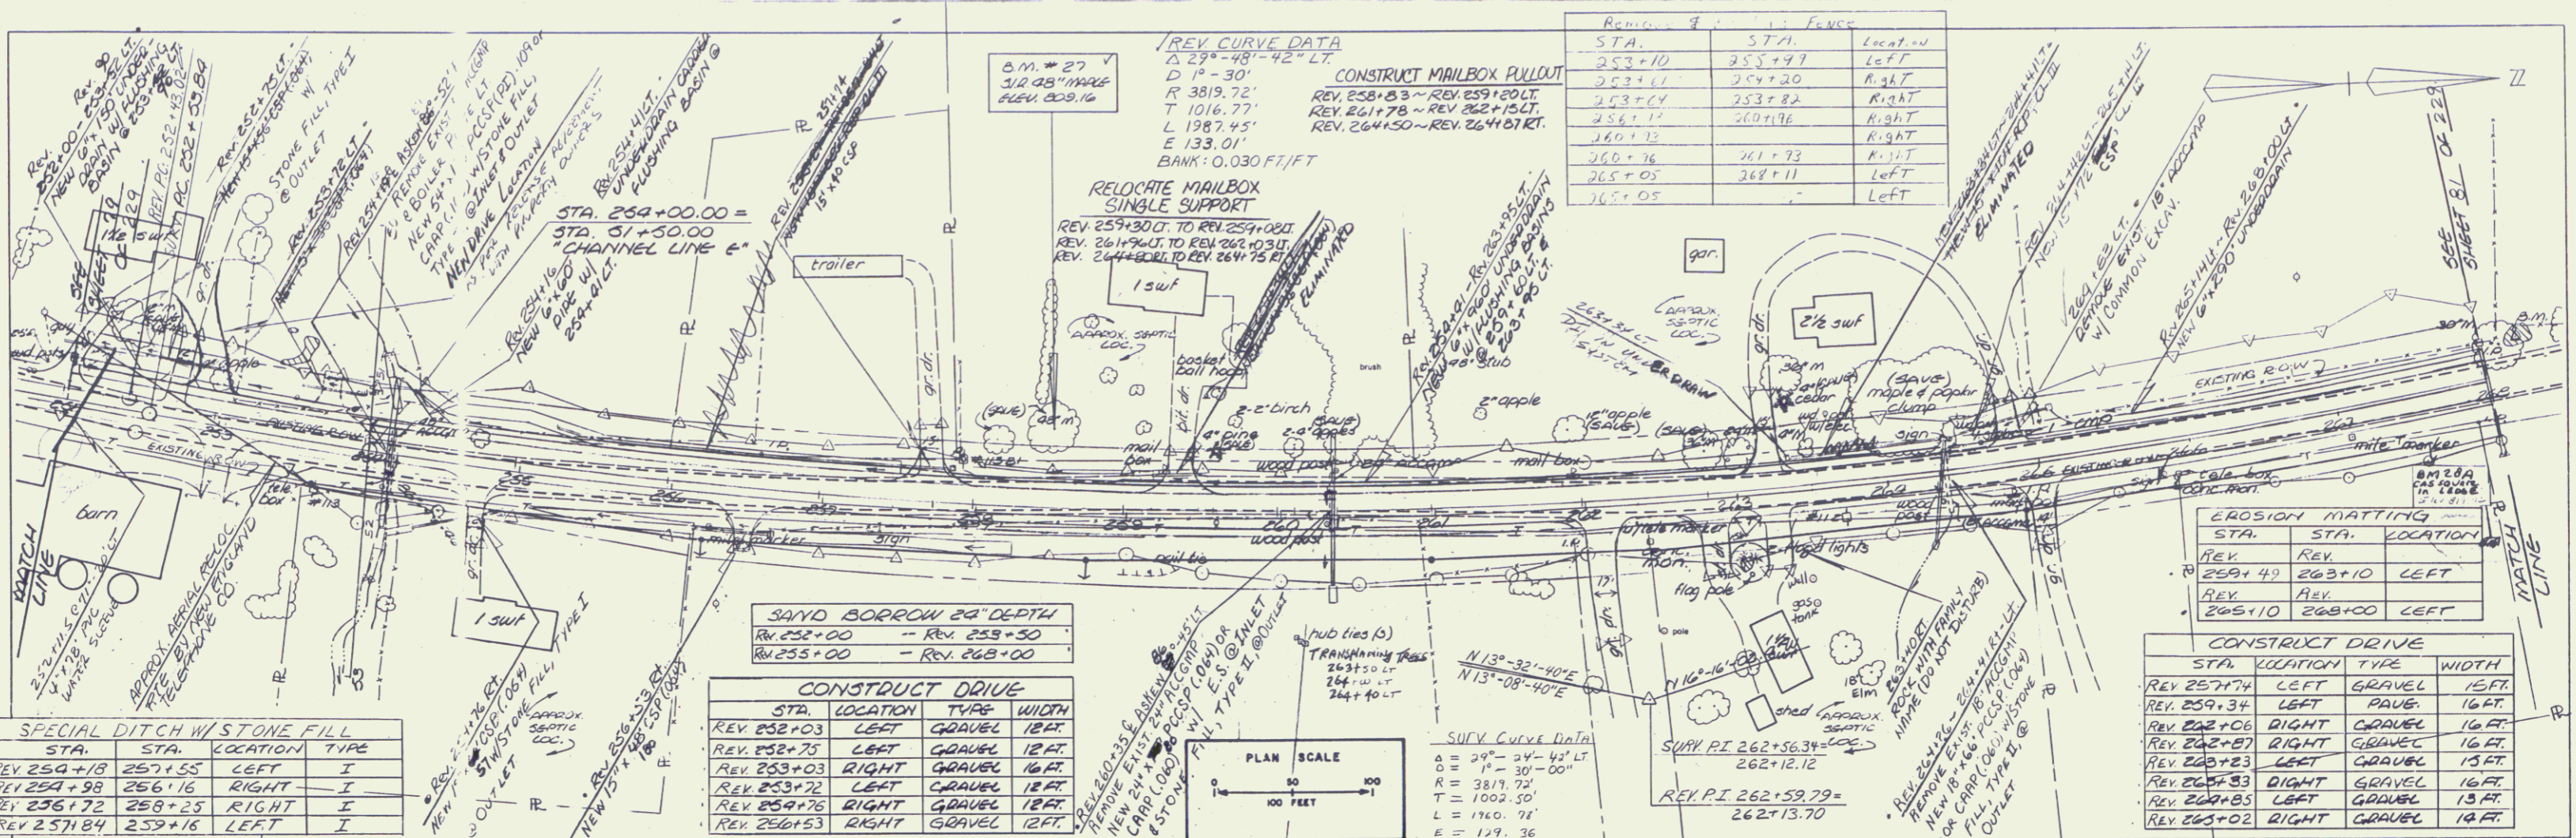

SPECIAL DITCH W/ STONE FILL

STA.	STA.	LOCATION	TYPE
REV 254+18	257+55	LEFT	I
REV 254+98	256+16	RIGHT	I
REV 256+72	258+25	RIGHT	I
REV 257+84	259+16	LEFT	I

SAND BORROW 24" DEPTH

REV 252+00	REV 253+50
REV 255+00	REV 265+00

CONSTRUCT DRIVE

STA.	LOCATION	TYPE	WIDTH
REV 252+03	LEFT	GRAVEL	12 FT.
REV 252+75	LEFT	GRAVEL	12 FT.
REV 253+03	RIGHT	GRAVEL	16 FT.
REV 253+72	LEFT	GRAVEL	12 FT.
REV 254+76	RIGHT	GRAVEL	12 FT.
REV 256+53	RIGHT	GRAVEL	12 FT.


EROSION MATTING

STA.	STA.	LOCATION
REV 259+49	263+10	LEFT
REV 259+10	268+00	LEFT

CONSTRUCT DRIVE


STA.	LOCATION	TYPE	WIDTH
REV 257+74	LEFT	GRAVEL	15 FT.
REV 259+34	LEFT	PAVE.	16 FT.
REV 262+06	RIGHT	GRAVEL	16 FT.
REV 262+87	RIGHT	GRAVEL	16 FT.
REV 262+23	LEFT	GRAVEL	15 FT.
REV 265+83	RIGHT	GRAVEL	16 FT.
REV 264+85	LEFT	GRAVEL	13 FT.
REV 265+02	RIGHT	GRAVEL	14 FT.

DATUM NATIONAL GEODETIC
 VERTICAL VERTICAL DATUM 1929
 HORIZONTAL VT STATE
 COORDINATE SYSTEM

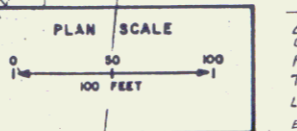

SURV. CURVE DATA
 Δ = 29° - 24' - 43" LT
 D = 19 - 30' - 00" LT
 R = 3819.72'
 T = 1002.50'
 L = 1760.76'
 E = 129.36'

CONSTRUCTION AS-BUILT PLANS
R.O.W. RESEARCH

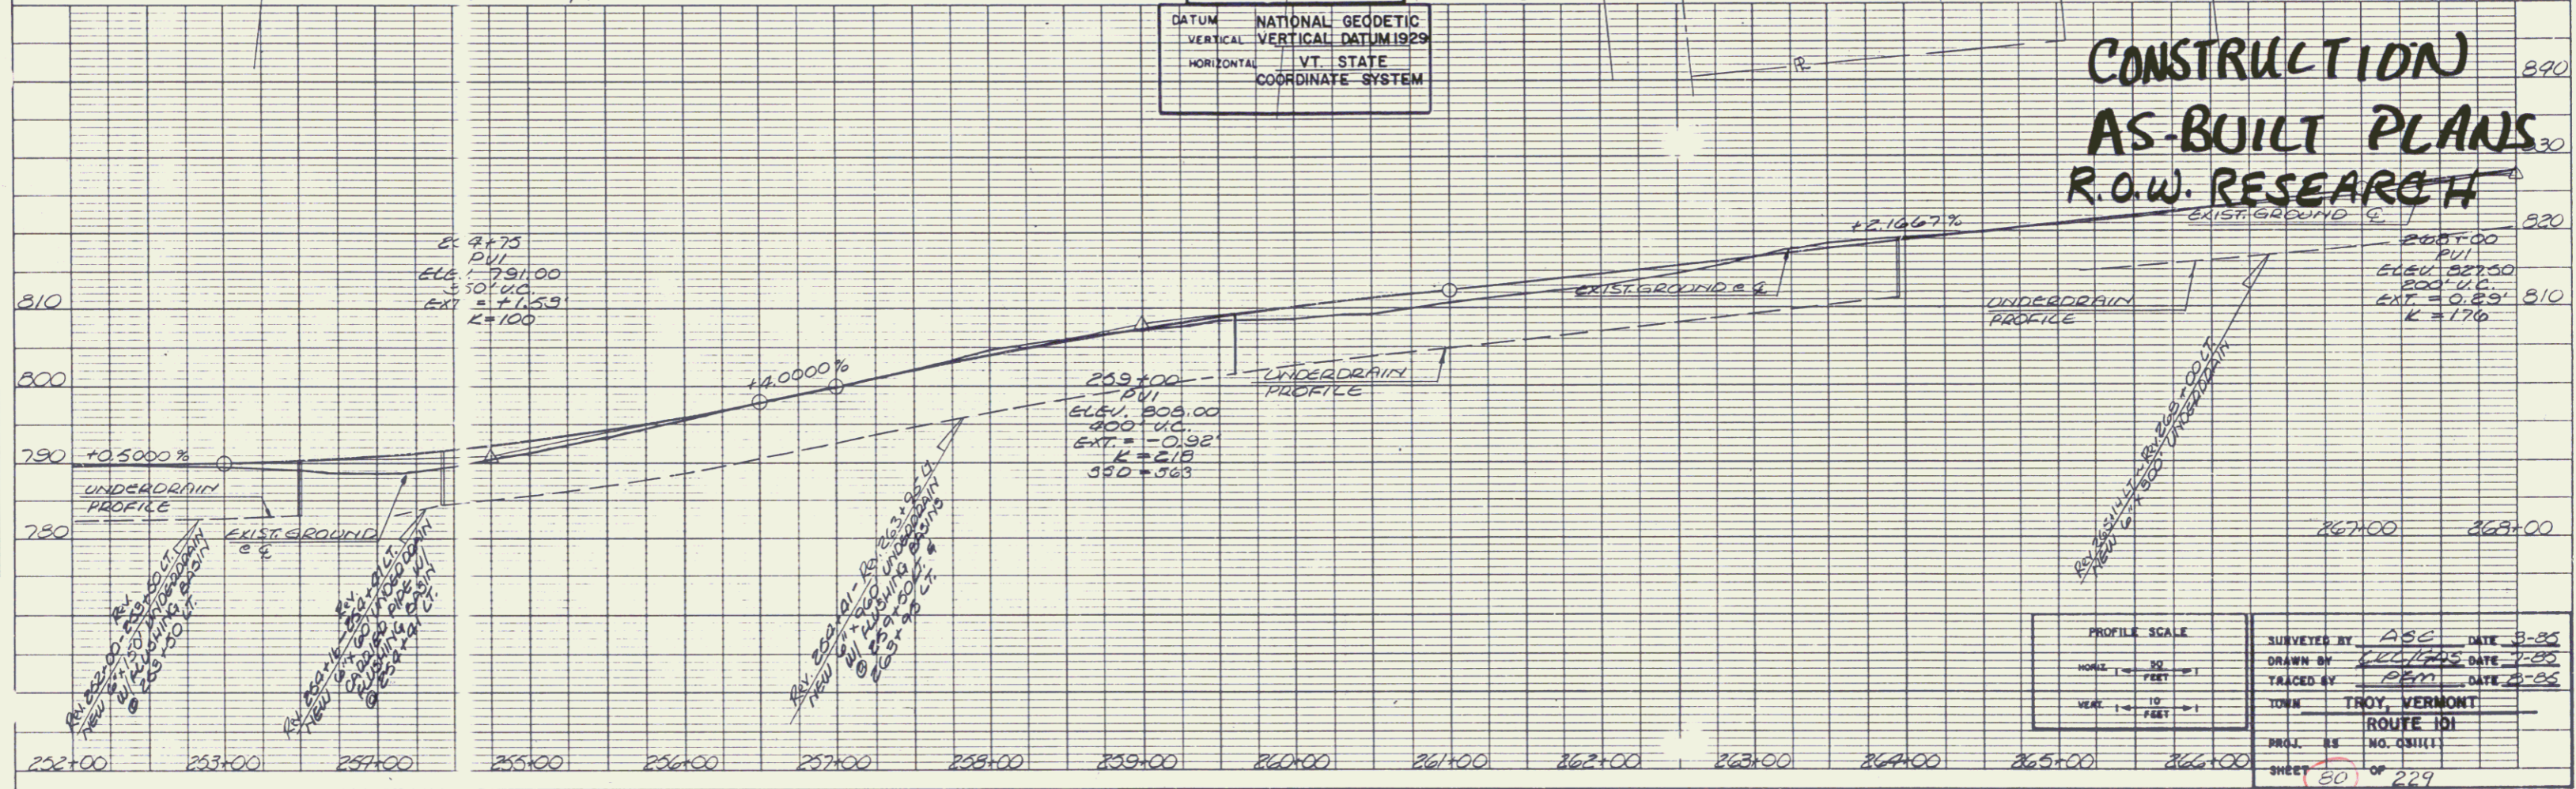

PROFILE SCALE
 HORIZ. 1" = 50 FEET
 VERT. 1" = 10 FEET

SURVEYED BY ABC DATE 3-85
 DRAWN BY JCC/GRS DATE 7-85
 TRACED BY DEM DATE 2-85
 TOWN TROY, VERMONT
 ROUTE 101
 PROJ. NO. 85111
 SHEET 80 OF 229