


PLAN
 DATE: _____
 DRAWN BY: _____
 CHECKED BY: _____
 NO. _____

PROFILE
 DATE: _____
 DRAWN BY: _____
 CHECKED BY: _____
 NO. _____

STA	LOCATION	TYPE	WIDTH
289+30	LEFT	GRAVEL	12 FT.
297+00	LEFT	GRAVEL	16 FT.
298+65	LEFT	GRAVEL	25 FT.



Remove & Re-setting Fence	STA	LOCATION
	288 63	LEFT
	288 65	LEFT
	289 18	RIGHT
	289 20	RIGHT
	298 40	LEFT

CURVE DATA
 D = 15° - 12' - 32" LT.
 D = 24' - 30' - 00"
 Q = 2291.83
 T = 303.98
 L = 608.36
 E = 20.33
 BANK = .086 FT./FT.

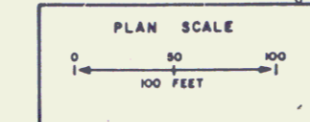

DATUM NATIONAL GEODETIC
 VERTICAL VERTICAL DATUM IS 29
 HORIZONTAL VT. STATE
 COORDINATE SYSTEM

292+50
 PVI
 ELEV. 813.09
 300' U.C.
 EXT. ± 145
 R = 97

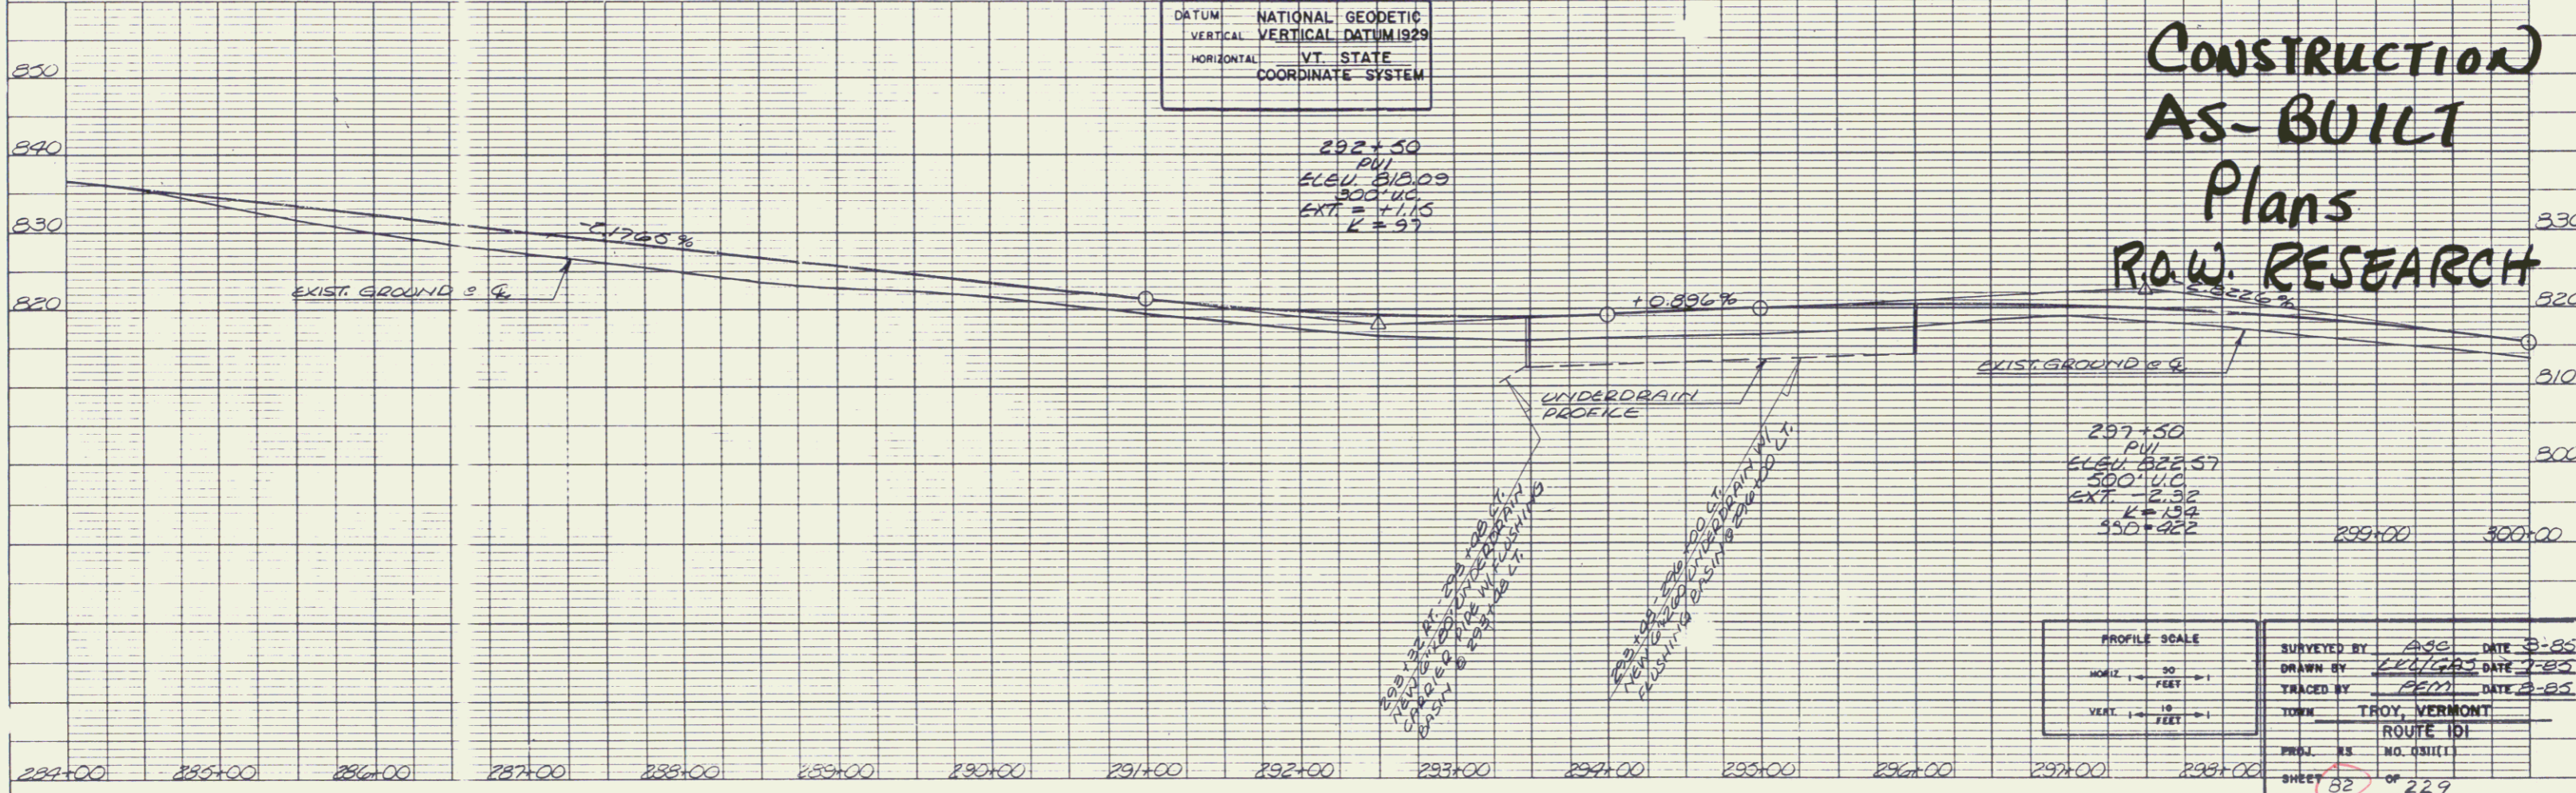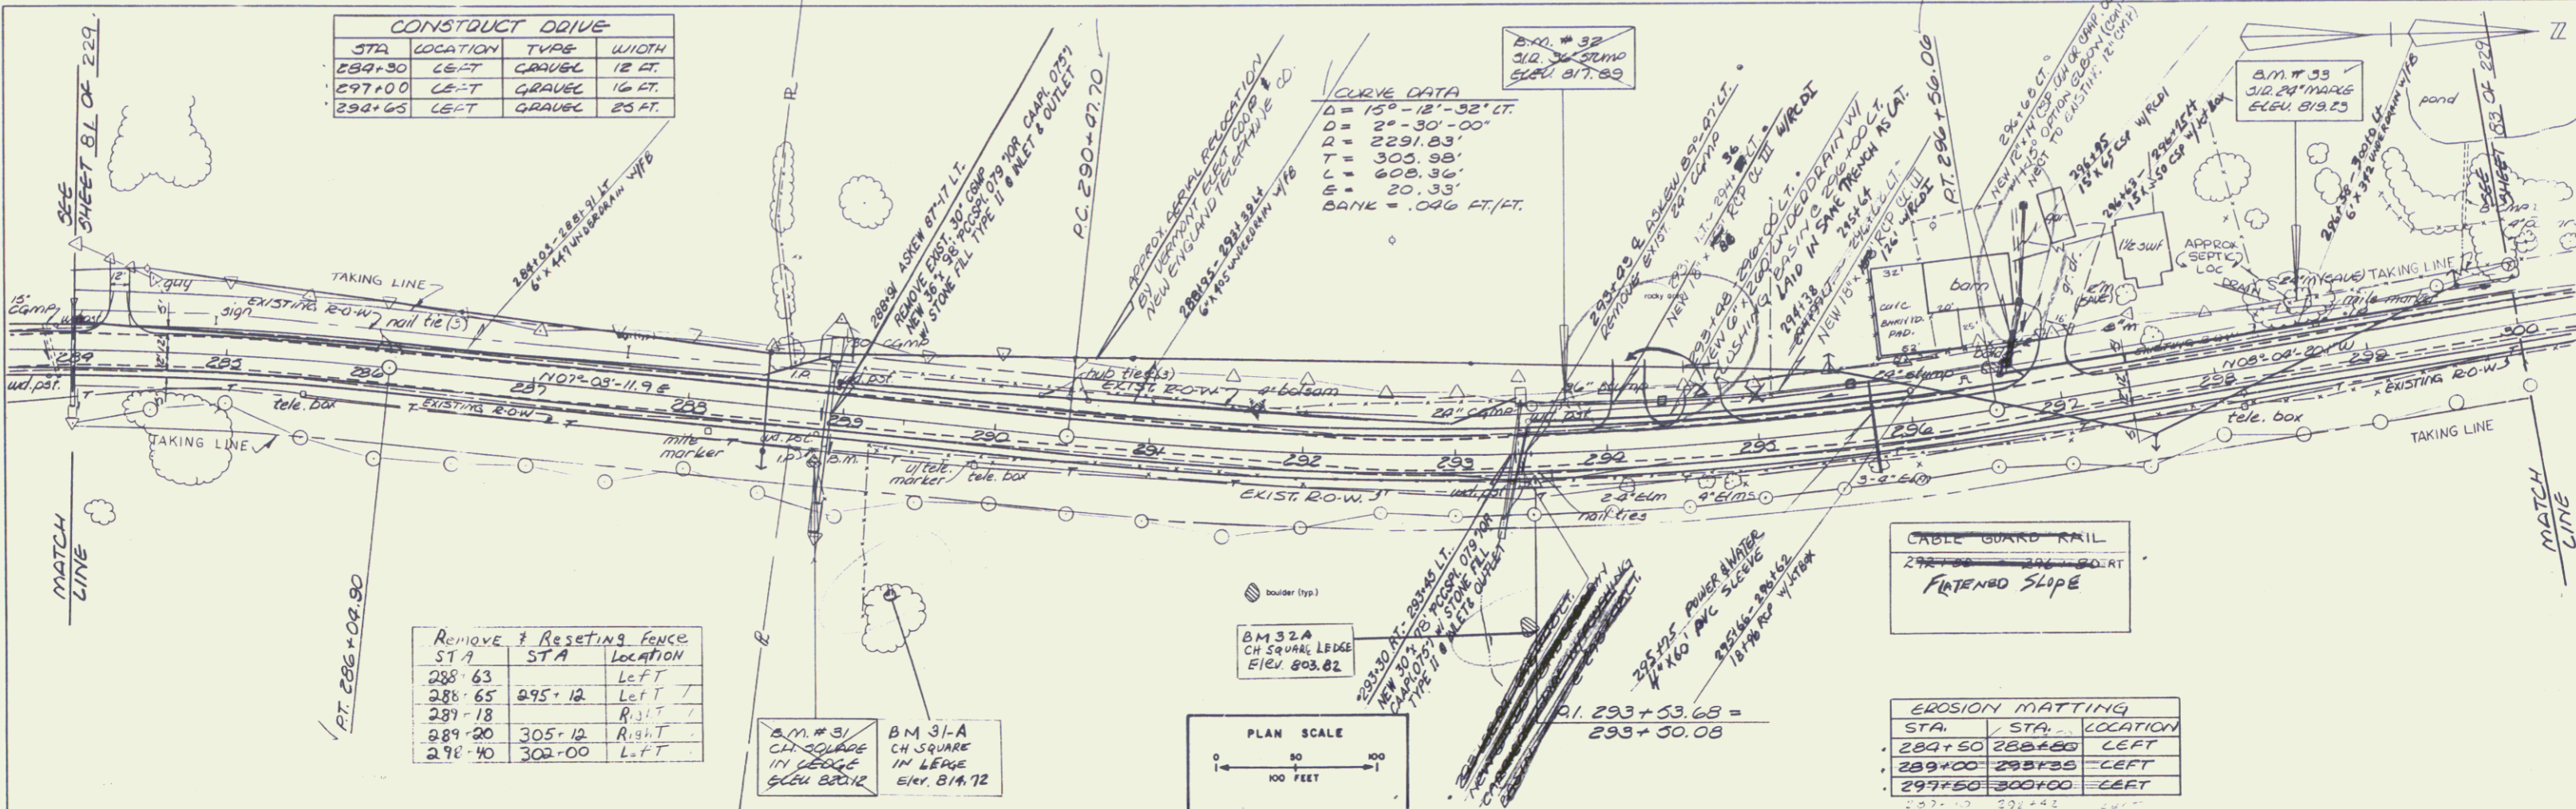

CONSTRUCTION AS-BUILT Plans R.O.W. RESEARCH

PROFILE SCALE
 HORIZ. 1" = 40 FEET
 VERT. 1" = 10 FEET

SURVEYED BY: ASB DATE: 3-82
 DRAWN BY: LEWIS DATE: 7-82
 TRACED BY: BSM DATE: 2-82
 TOWN: TROY, VERMONT
 ROUTE: 101
 PROJ. NO. 03111
 SHEET 82 OF 229