
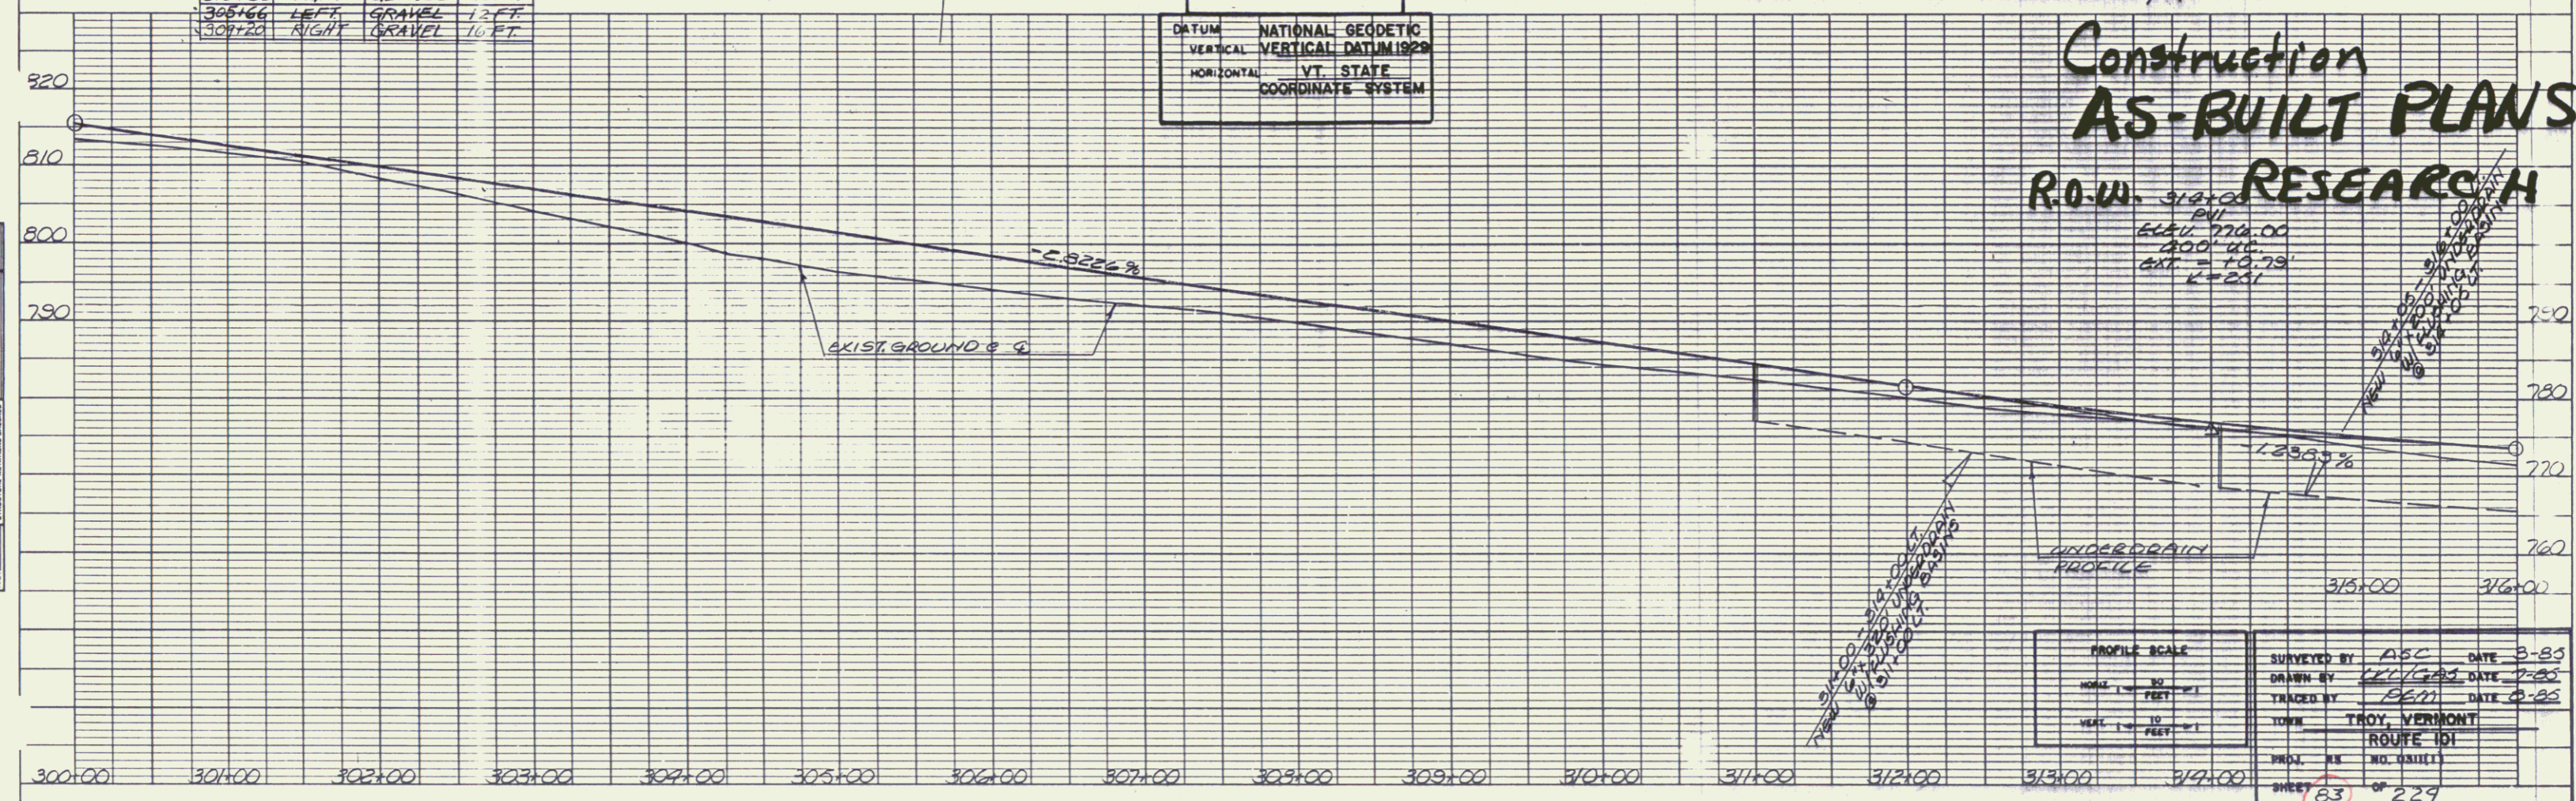


PLAN
 SHEET NO. 63
 OF 229

PROFILE
 SHEET NO. 63
 OF 229

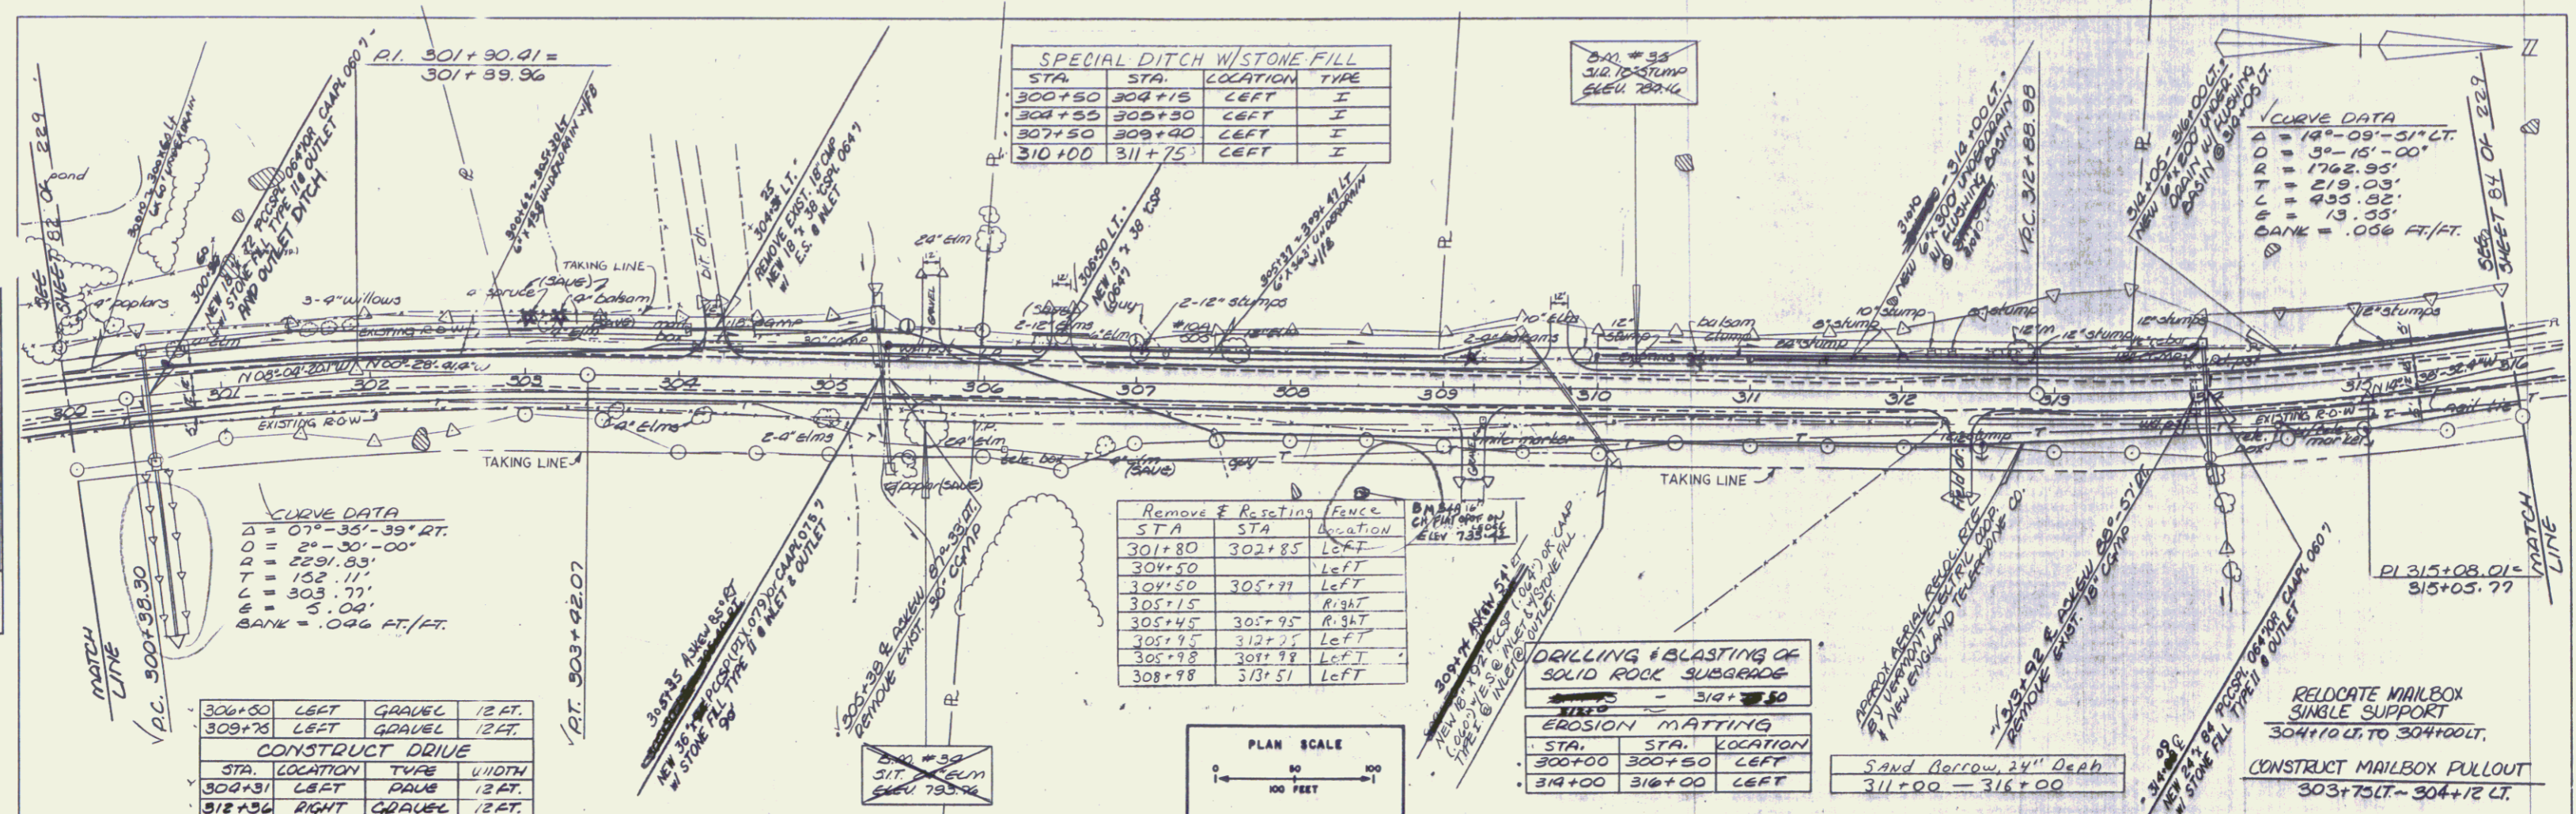

Construction AS-BUILT PLANS ROW RESEARCH

314+00
 ELEV. 776.00
 100' AC
 EXT. = 10.79'
 K=231