



PLAN  
NOTE BOOK

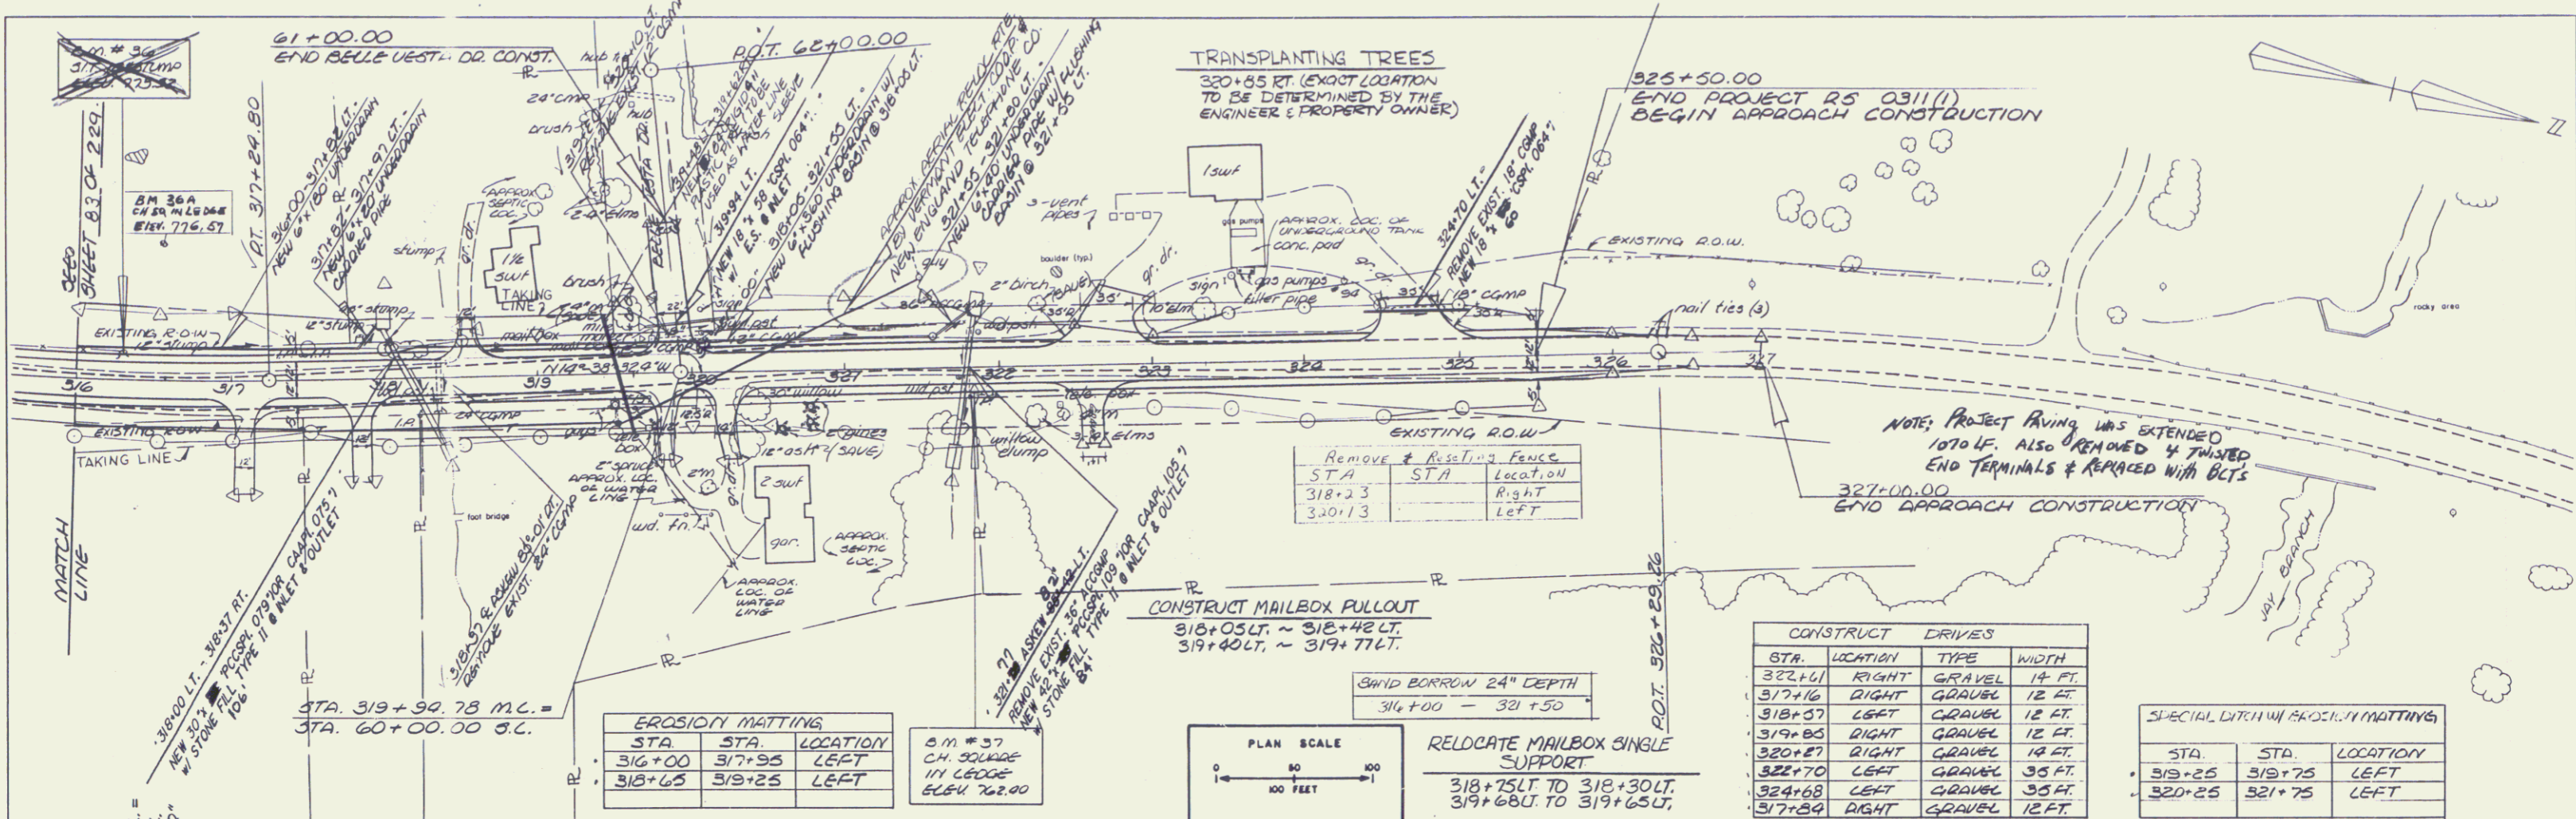

PROFILE  
NOTE BOOK

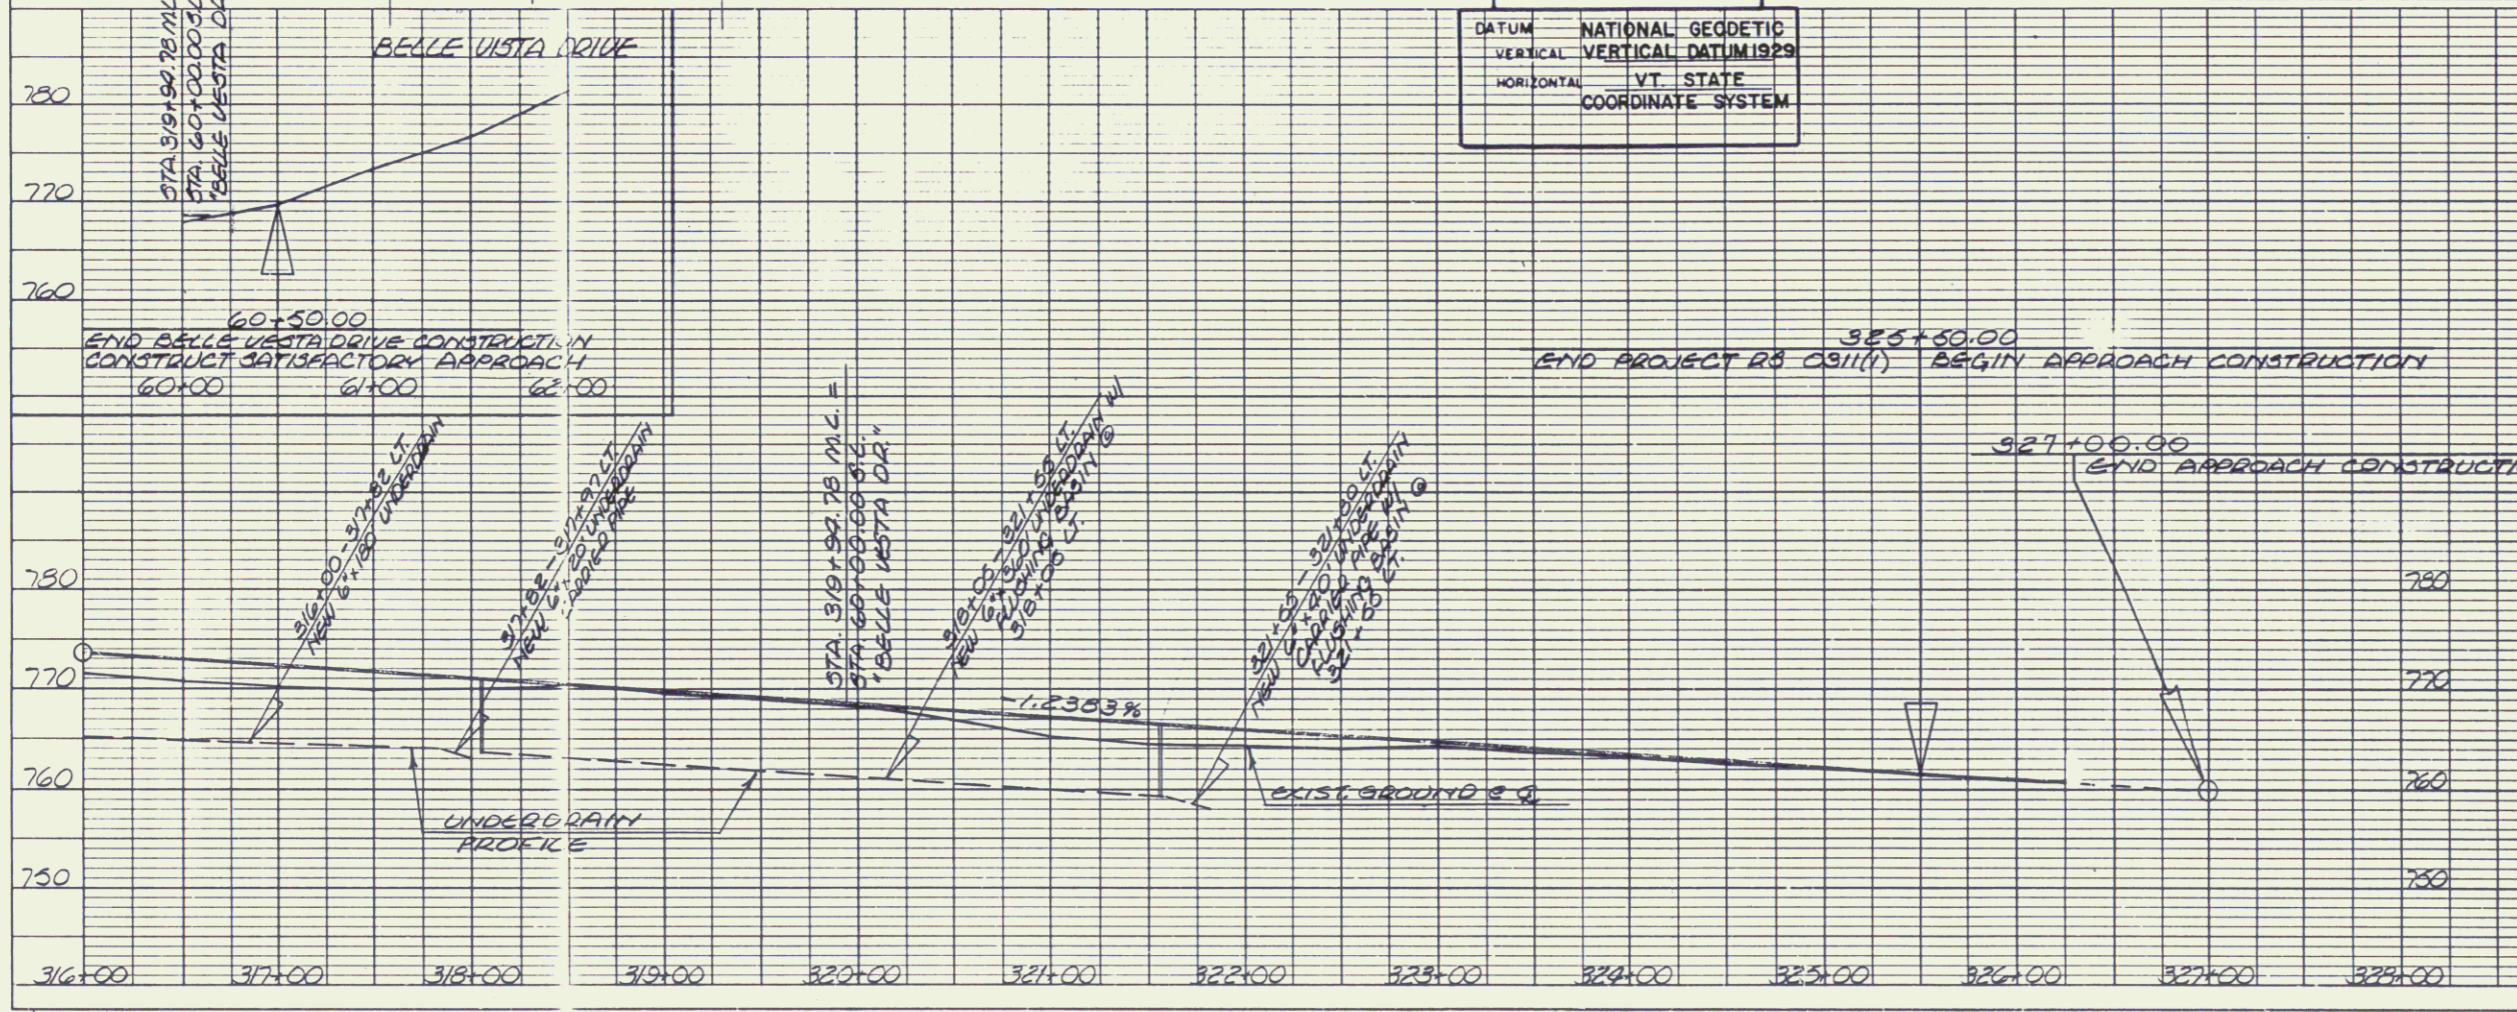

# Construction As-Built Plans R.O.W. RESEARCH

PROFILE SCALE  
HORIZ. 1" = 50 FEET  
VERT. 1" = 10 FEET

SURVEYED BY AGE DATE 3-83  
DRAWN BY LUTZ DATE 7-83  
TRACED BY PEM DATE 8-83  
TOWN TROY, VERMONT  
ROUTE 151  
SHEET 84 OF 229

66