



PLAN	NO. 1
DATE	
BY	
CHECKED	
APPROVED	
REVISIONS	
NO. 1	
NO. 2	
NO. 3	
NO. 4	
NO. 5	
NO. 6	
NO. 7	
NO. 8	
NO. 9	
NO. 10	

PROFILE	NO. 1
DATE	
BY	
CHECKED	
APPROVED	
REVISIONS	
NO. 1	
NO. 2	
NO. 3	
NO. 4	
NO. 5	
NO. 6	
NO. 7	
NO. 8	
NO. 9	
NO. 10	

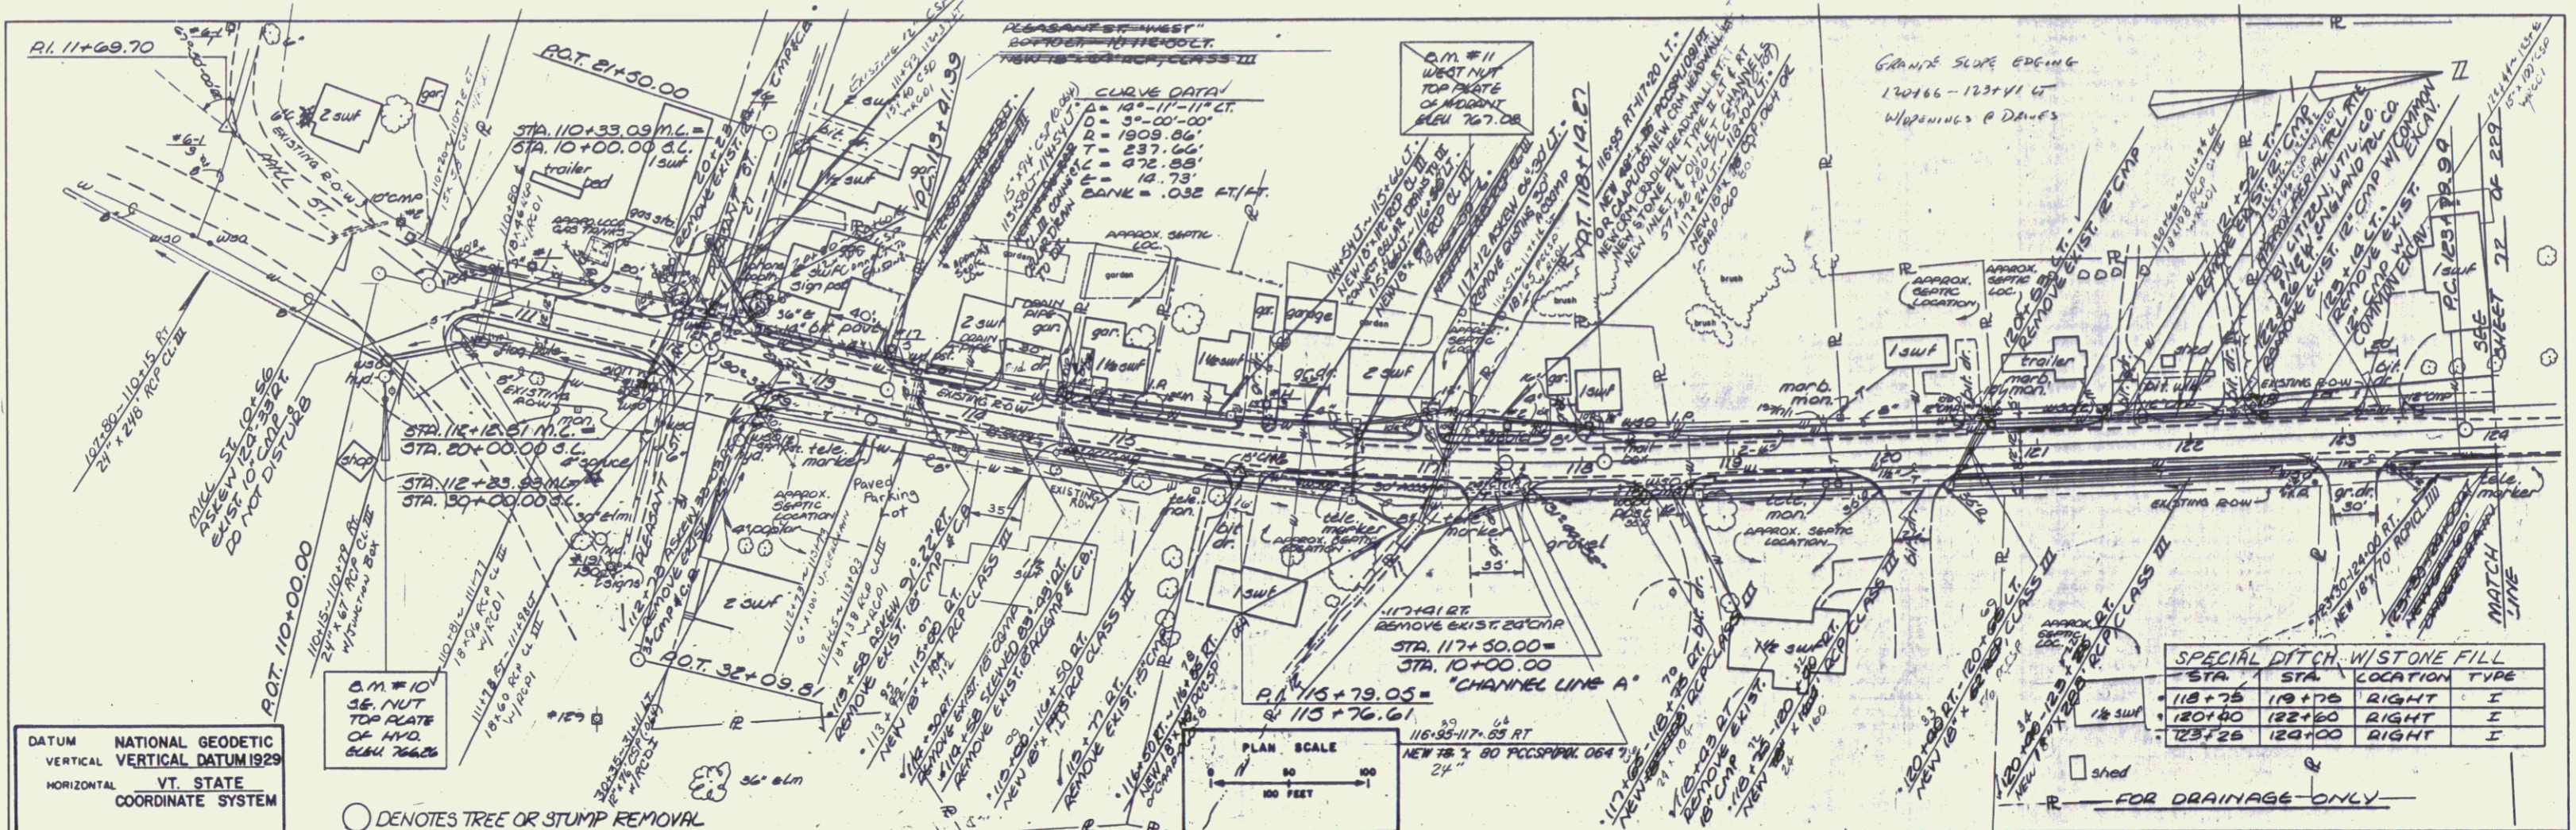

STA.	STA.	LOCATION	TYPE
118+75	119+75	RIGHT	I
120+40	122+60	RIGHT	I
123+25	124+00	RIGHT	I

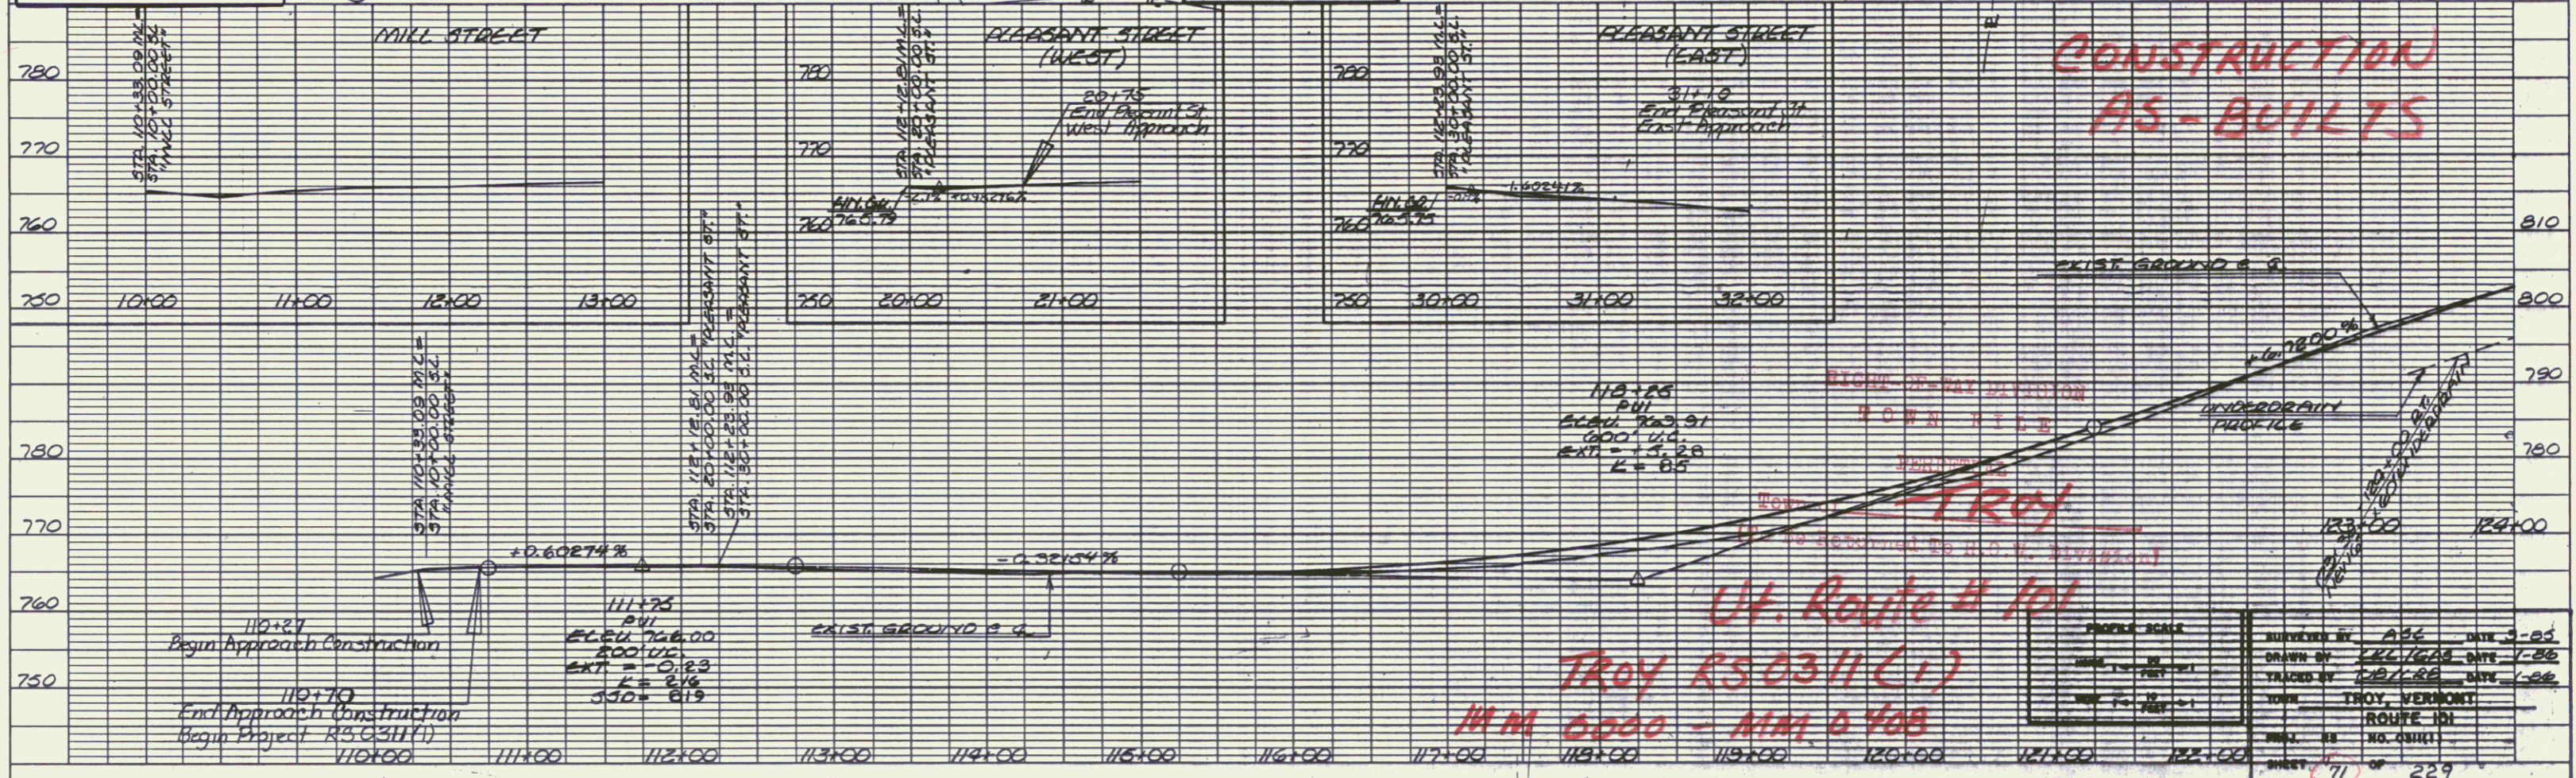

PROJECT NO.	110-0000	DATE	3-25
DRAWN BY	RLC/2025	DATE	1-26
TRACED BY	RLC/2025	DATE	1-26
WORK	TROY, VERMONT		
ROUTE	ROUTE 101		
SCALE	AS SHOWN		
SHEET	71	OF	229

PLATE 1 PLAN PROFILE D. F. & S. L. BRADSHAW
 11/25/88
 11/25/88

MAR 29 1995