

PLAN	NO. 1
DATE	
REVISIONS	
NOTED	
BY	
DATE	
NO. 1	

PROFILE	NO. 1
DATE	
REVISIONS	
NOTED	
BY	
DATE	
NO. 1	

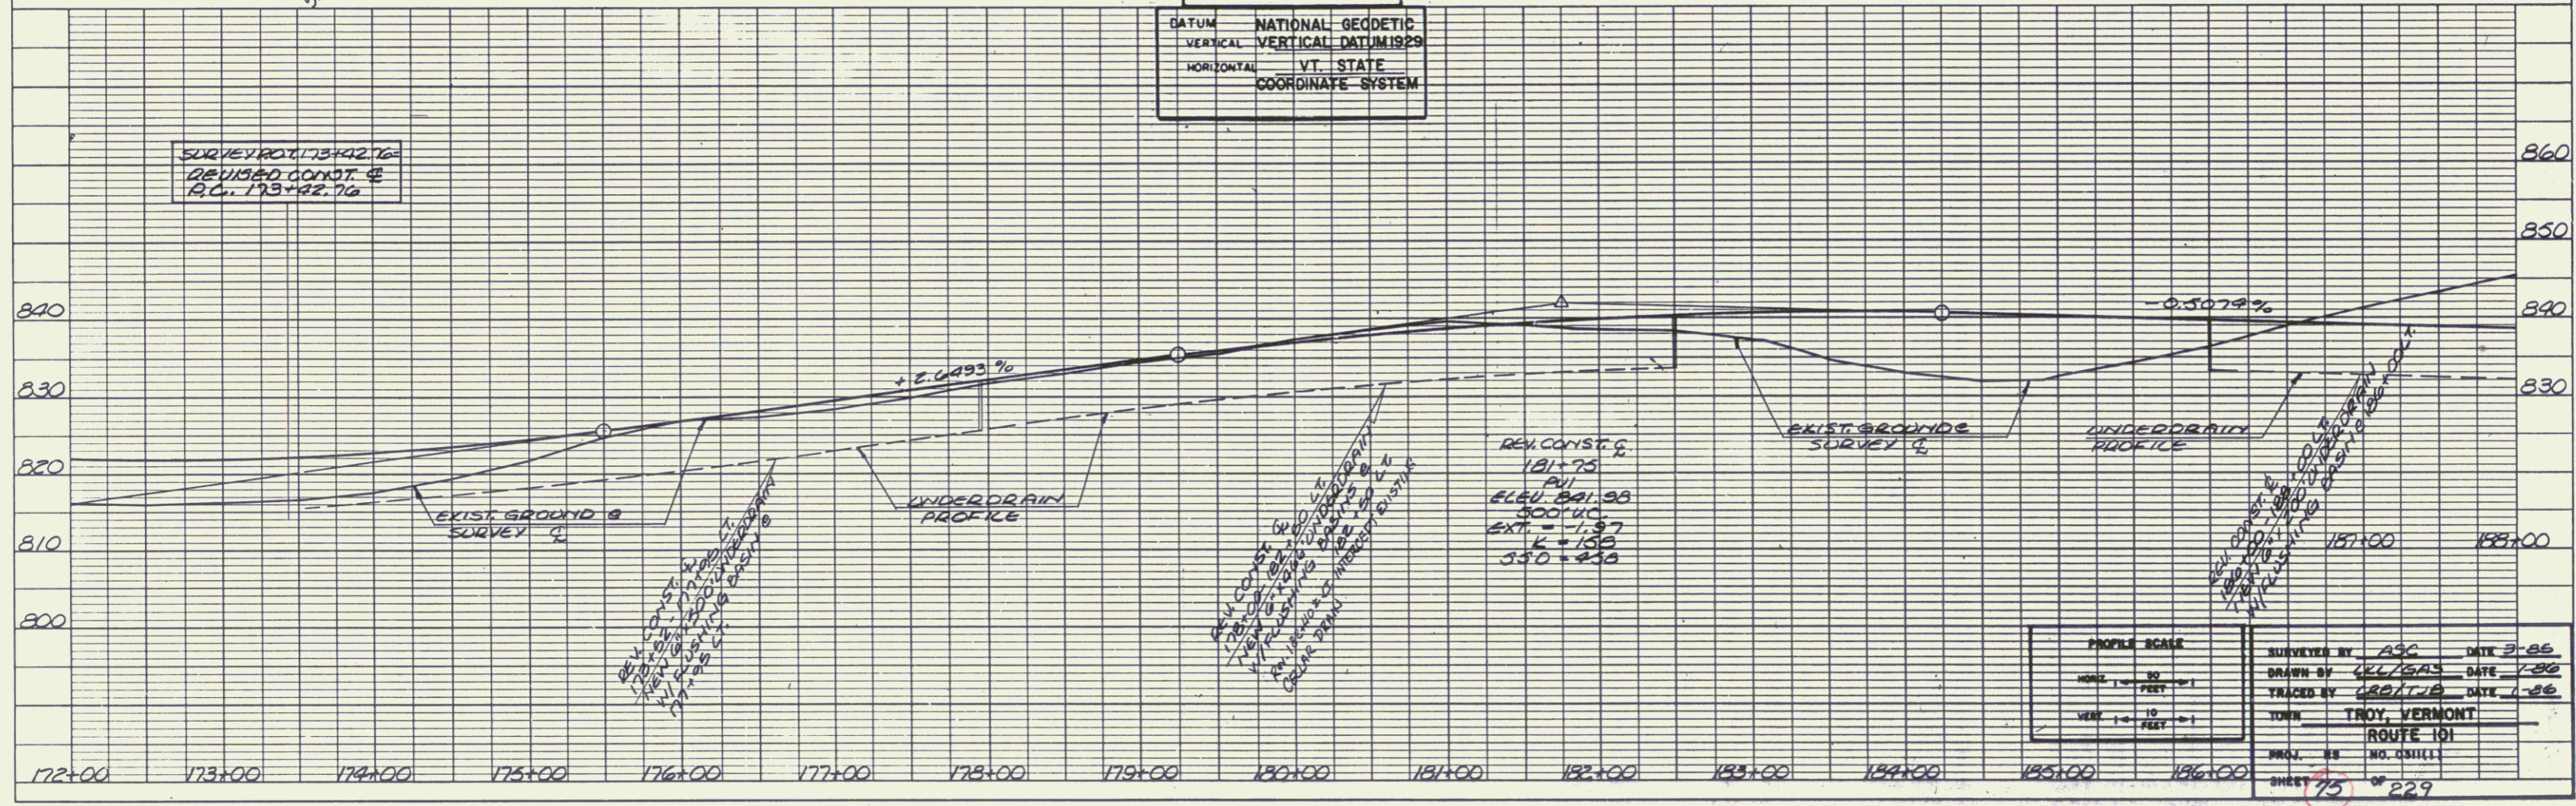
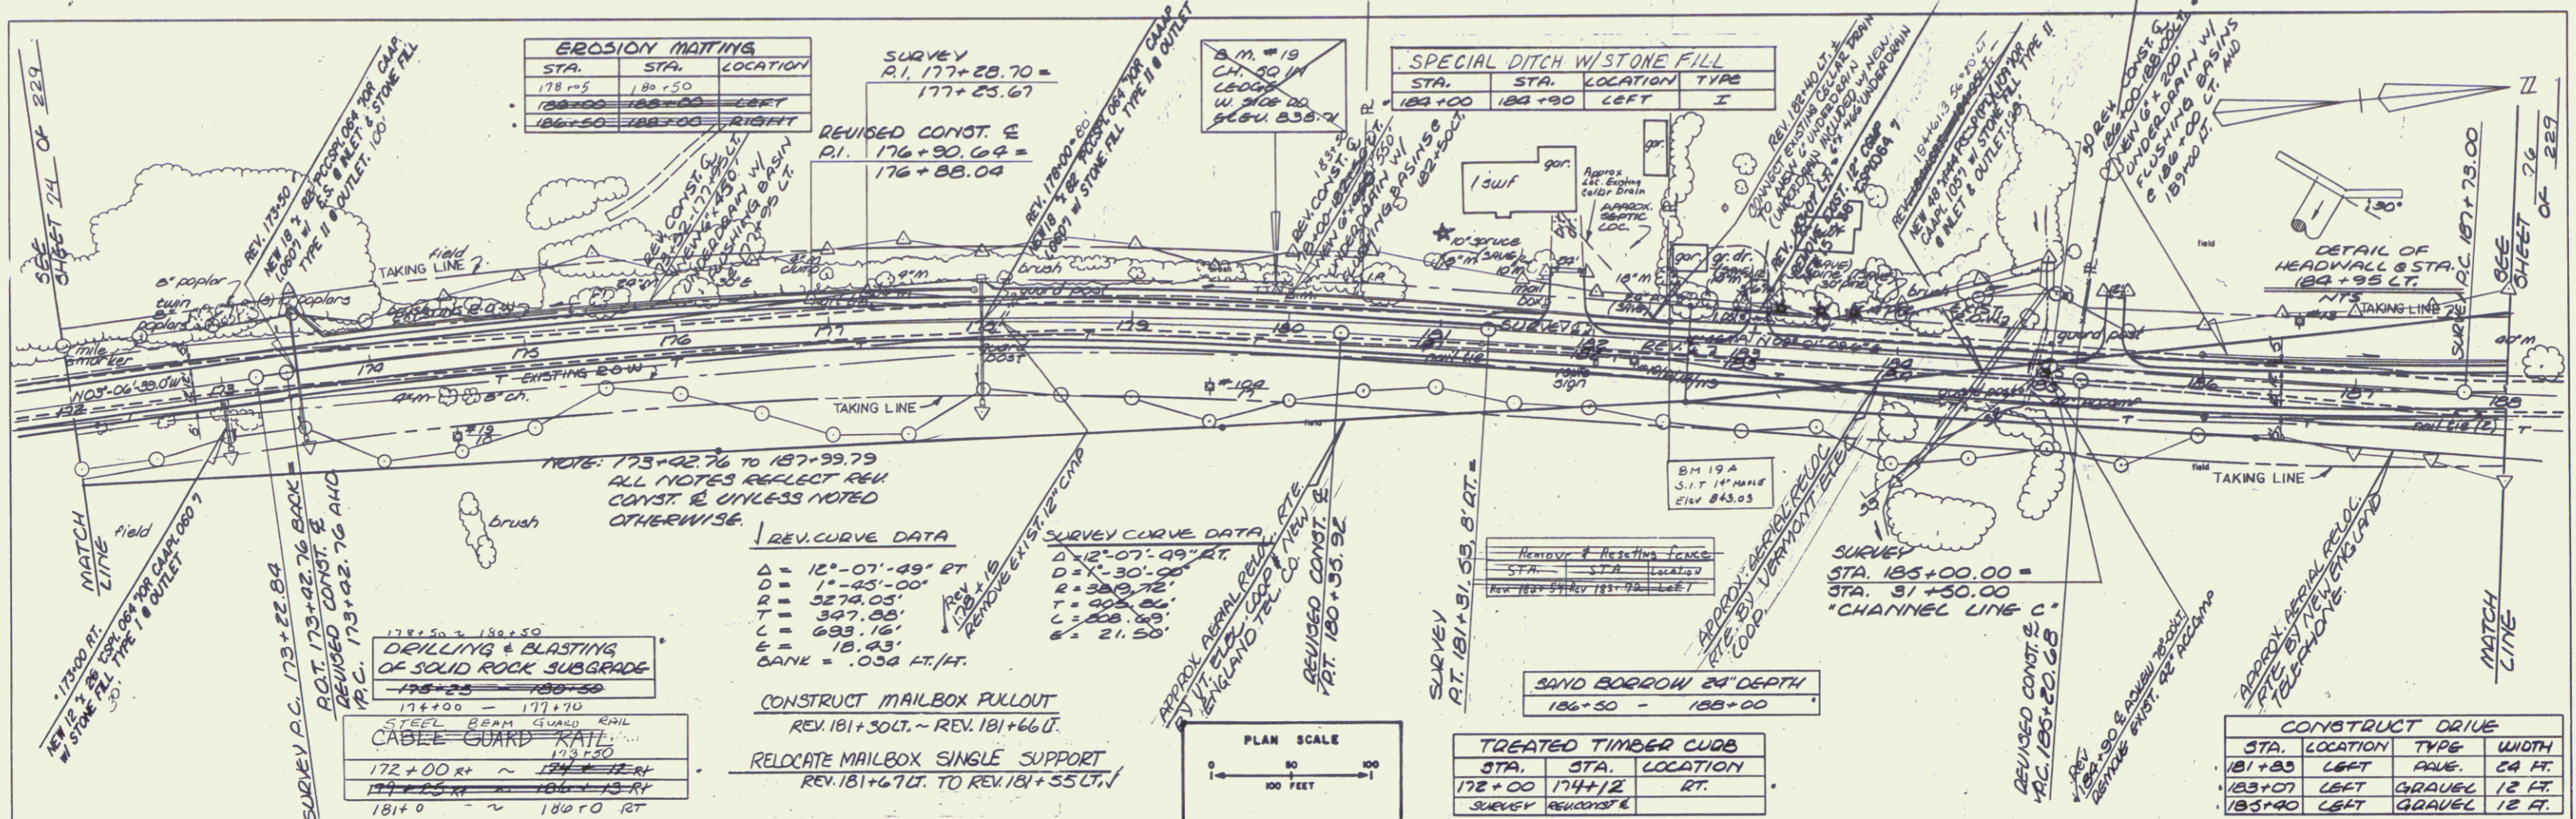


PLATE 1 PLAN-PROFILE D. P. S. S. E. STANDARD
BEST QUALITY REPRODUCTION
PRINTED IN U.S.A.

MAR 29 1995 72