



PLAN
NOTE BOOK
NO.

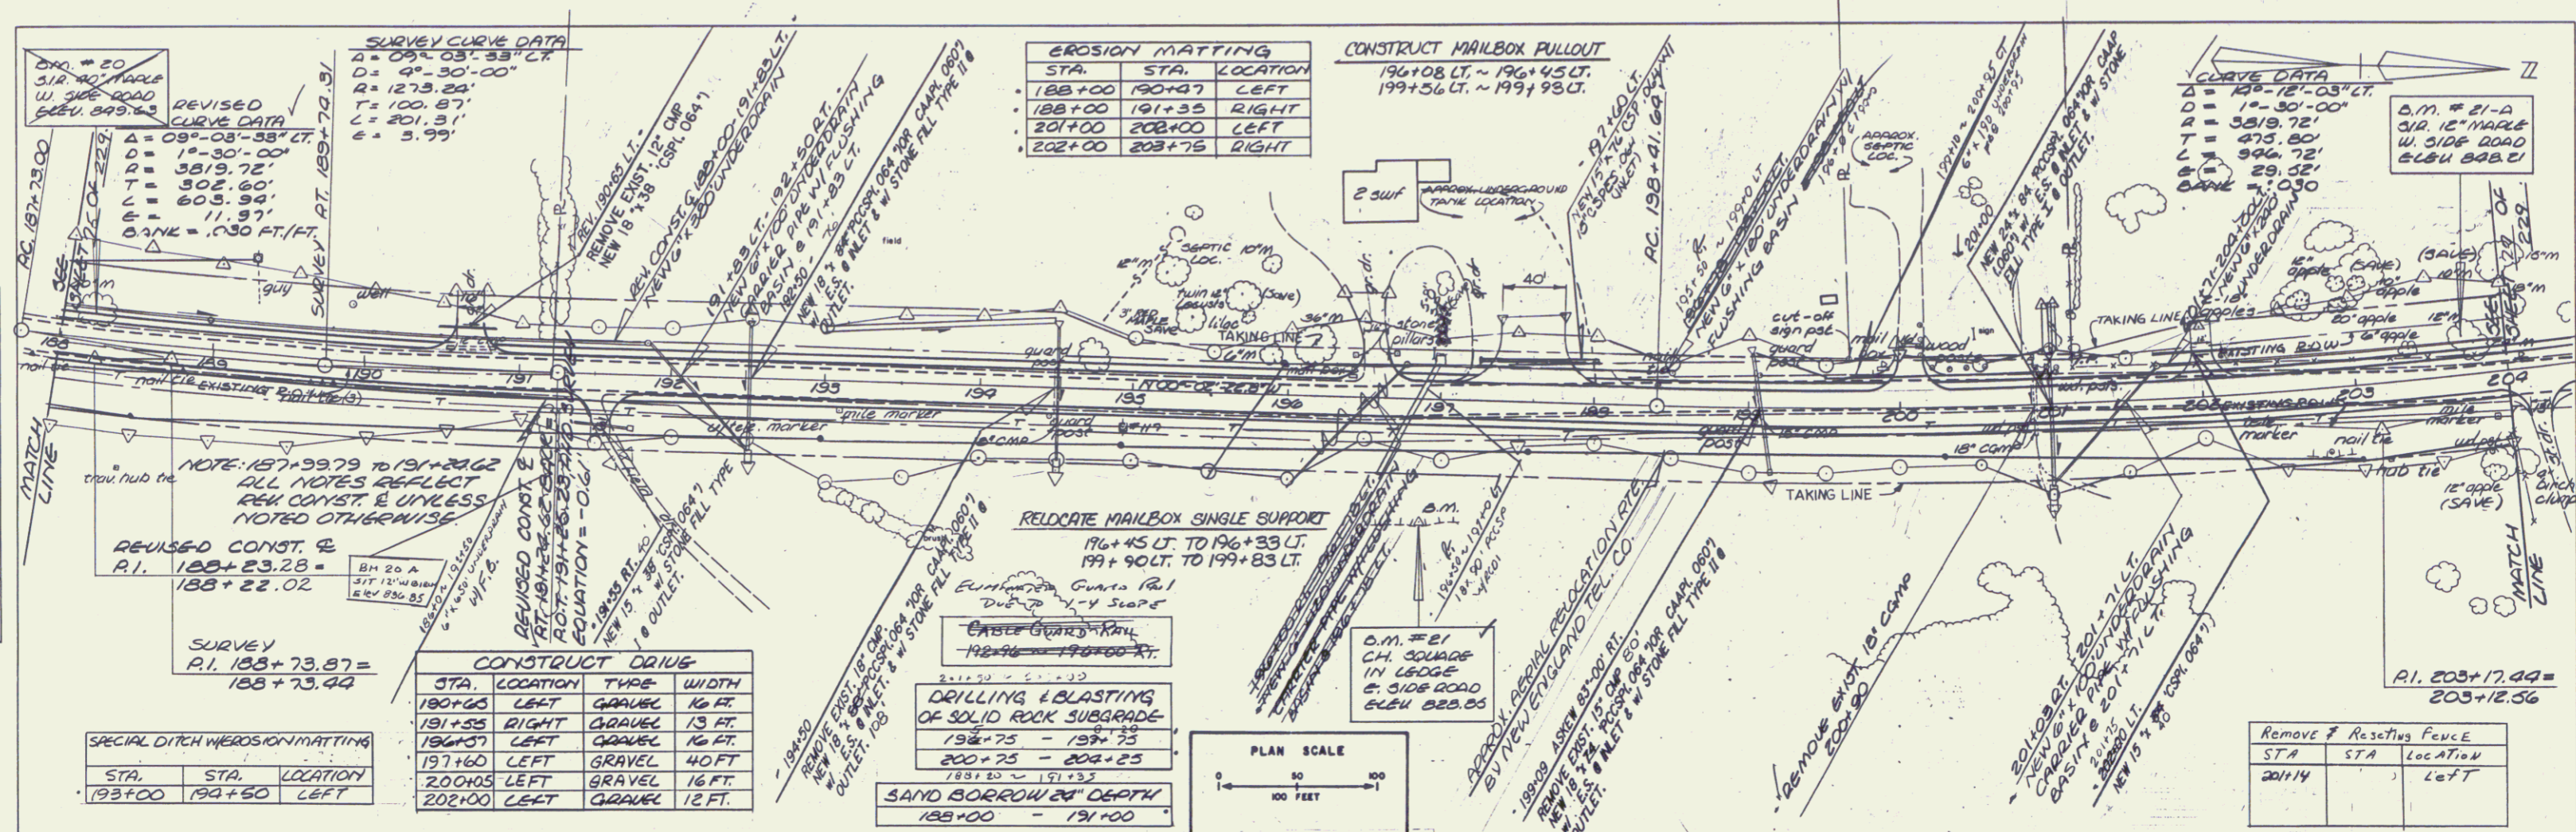

PROFILE
NOTE BOOK
NO.

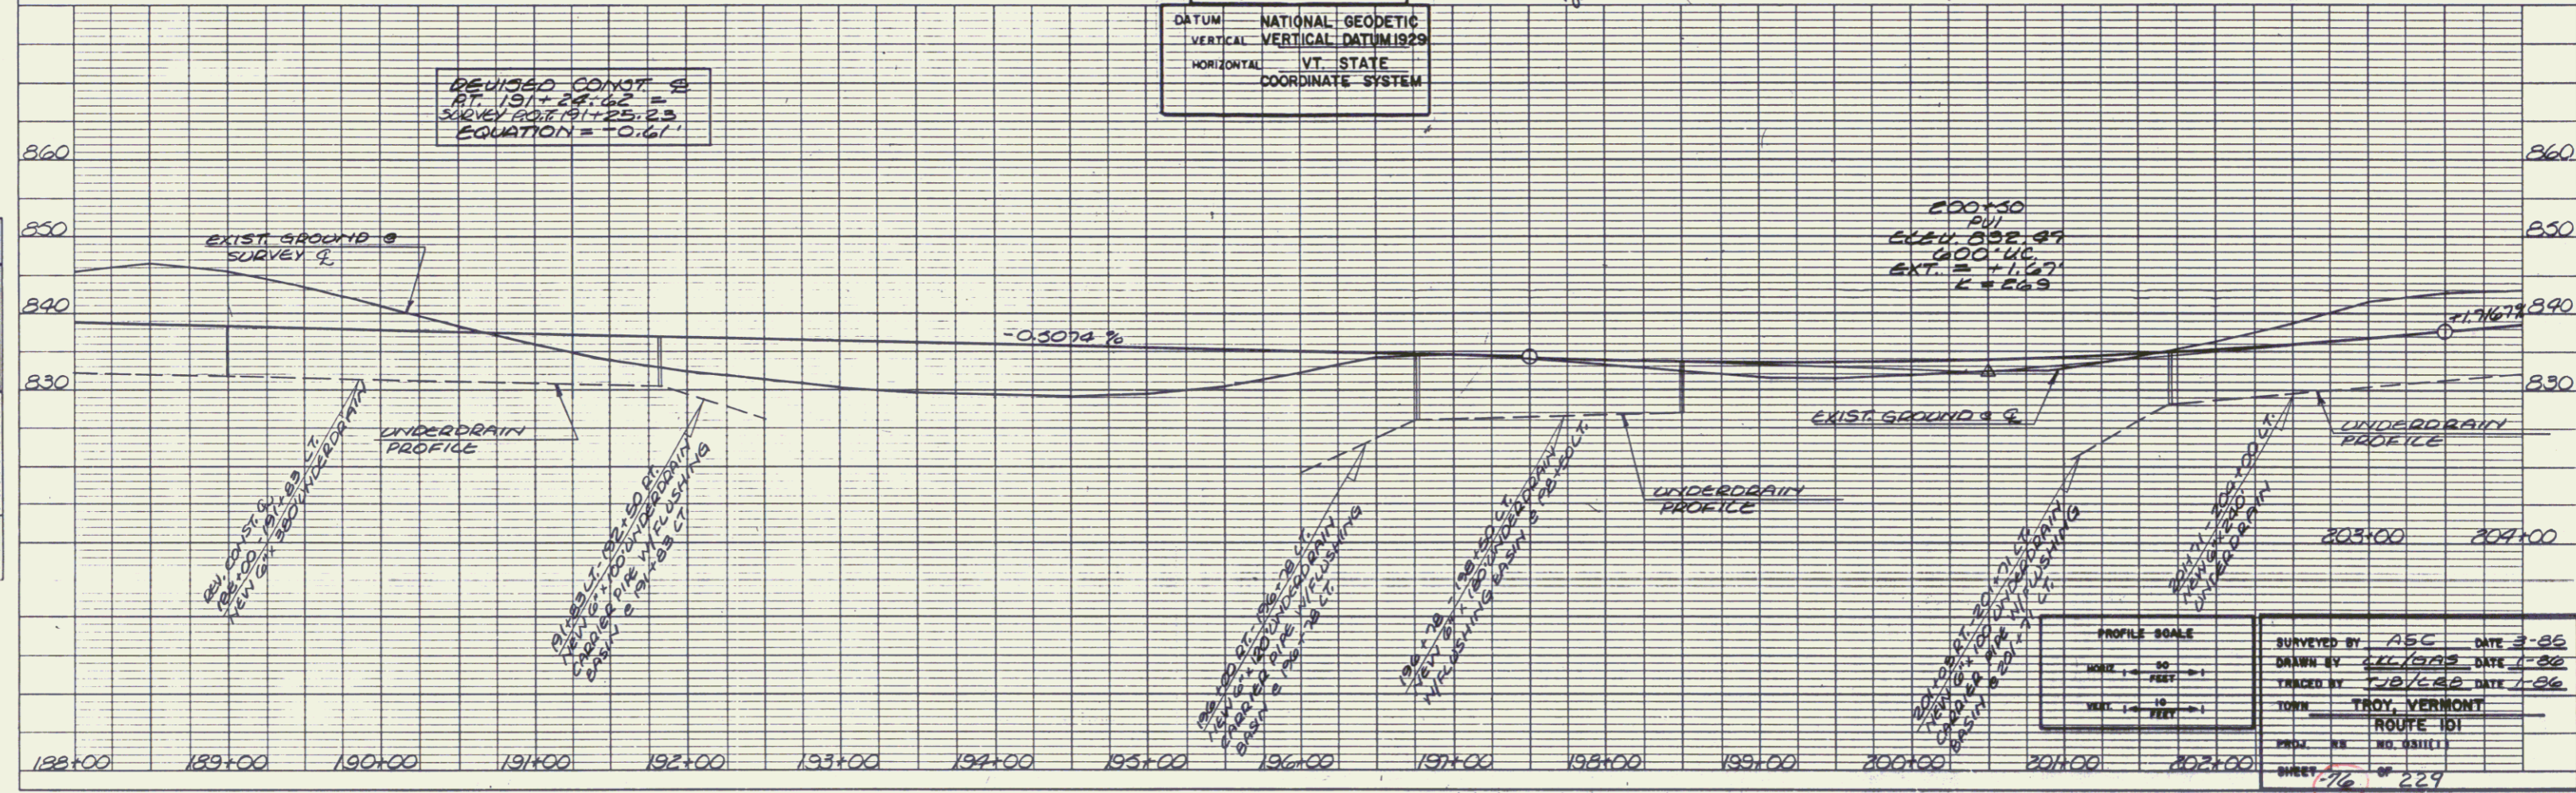

DATUM NATIONAL GEODETIC
VERTICAL VERTICAL DATUM 1929
HORIZONTAL VT STATE
COORDINATE SYSTEM

PROFILE SCALE
1" = 10 FEET
1" = 10 FEET

SURVEYED BY ABC DATE 3-88
DRAWN BY JCL/DAE DATE 1-88
CHECKED BY JCL/DAE DATE 1-88
TOWN TROY, VERMONT
ROUTE 101
SHEET NO. 229
SHEET 229

MAR 29 1995 73